


Farris, Hansen & Associates, Inc.

7 RIDGEWAY COURT, P.O. BOX 437, ELKHORN, WISCONSIN TEL. 414-723-2098
 LOCATION: LOT 10, BLOCK 2, J.H. ROWE'S ADD.
 DESCRIPTION: GENOA CITY, WALWORTH CO., WI.
 WORK ORDERED BY: JEROME BERGER
 MAP SCALE IN FEET (XXXXX) = RECORD DIMENSION

MAP LEGEND
 • IRON PIPE STAKE FOUND
 • IRON PIPE STAKE SET
 • IRON ROD STAKE FOUND
 • IRON ROD STAKE SET
 • CONCRETE MONUMENT FOUND
 (XXXXX) = RECORD DIMENSION

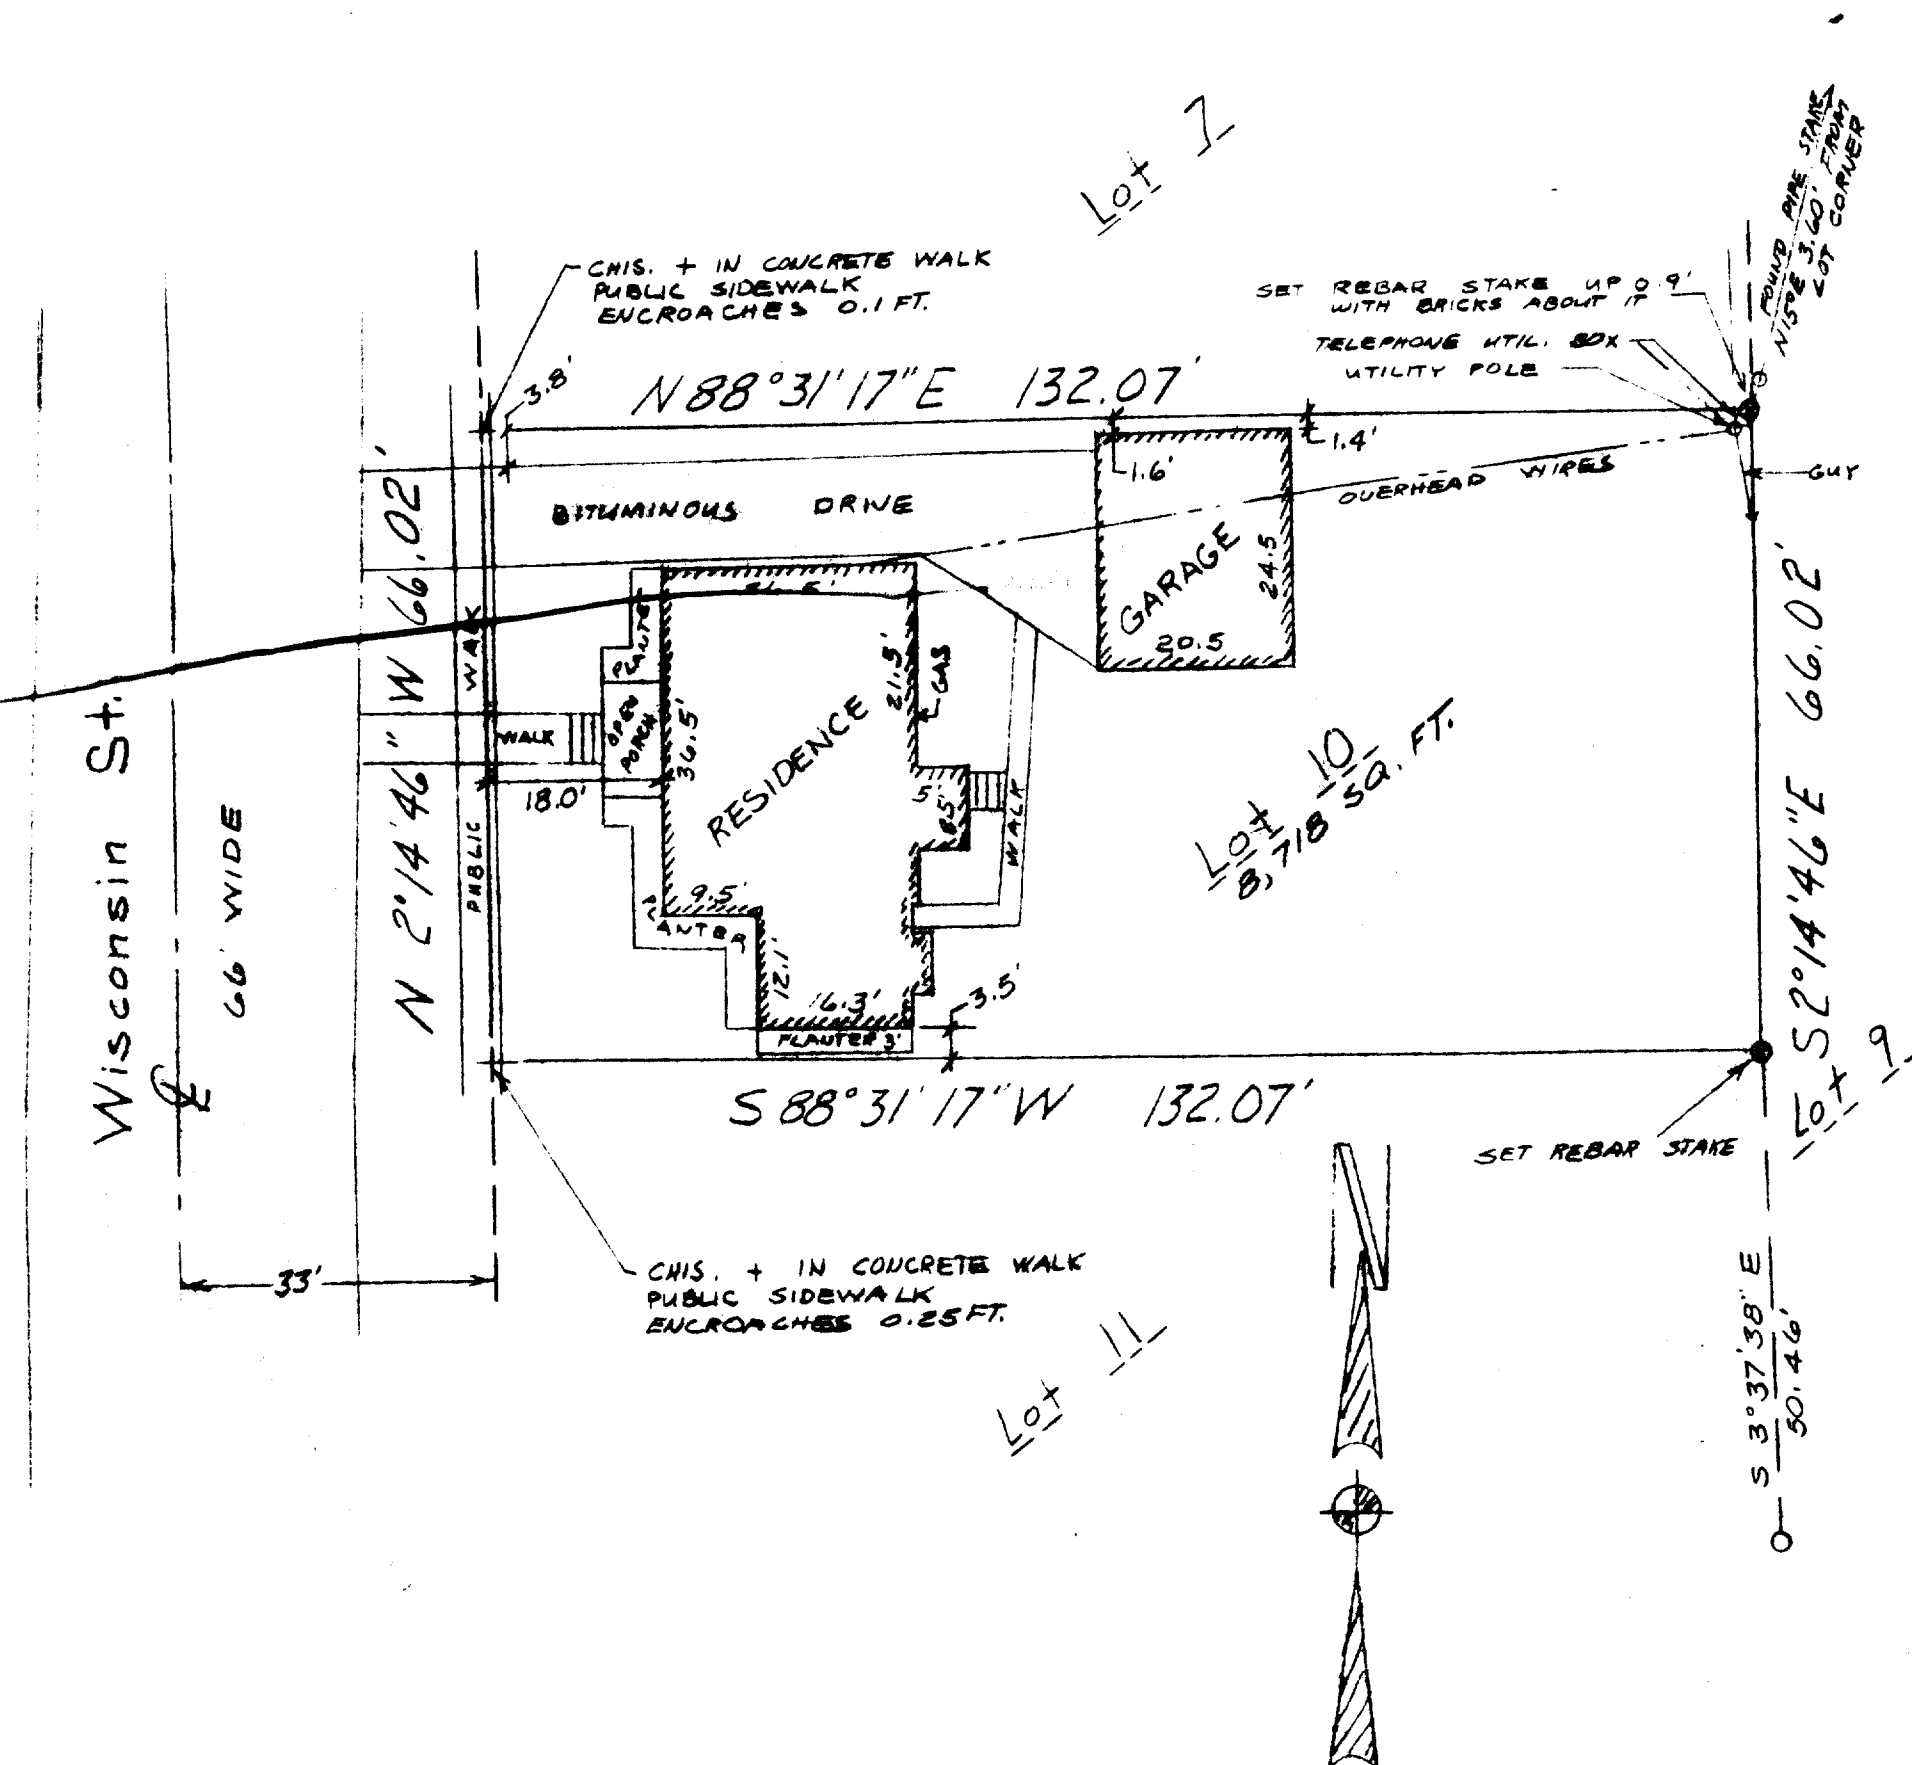

PLAT OF SURVEY


NOTE: COPIES OF THIS MAP TO WHICH THE FOLLOWING CERTIFICATE WILL APPLY ARE BLUE LINE PRINTS SHOWING SURVEYOR'S SEAL AND SIGNATURE IN BLACK INK. COPIES BY ANY OTHER MEANS MAY HAVE ALTERATIONS WHICH DO NOT REPRESENT THE SURVEYOR'S WORK PRODUCT.

I hereby certify that the above described property has been surveyed under my direction and that the above map is a true representation thereof and shows the size and location of the property, its exterior boundaries, the location of all visible structures and dimensions of all principal buildings thereon, boundary fences, apparent easements, road-ways and visible encroachments, if any. This survey is made for the use of the present owners of the property, and also those who purchase, mortgage, or guarantee the title thereto within one year from the date hereof.

DATED: DEC. 11, 1990

PROJ. NO. 3414.10

SHEET 1 of 2 SHEETS

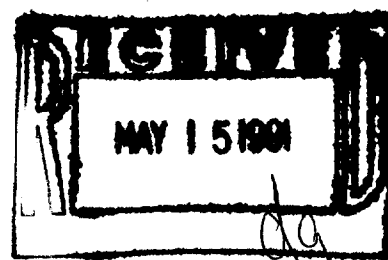


Farris, Hansen & Associates, Inc.

7 RIDGEWAY COURT, P.O. BOX 437, ELKHORN, WISCONSIN TEL. 414-723-2098
 LOCATION: BLOCK 2 J.H. ROWE'S ADD.
 DESCRIPTION: GENOA CITY, WALWORTH CO., WI.
 WORK ORDERED BY: JEROME BERGER
 MAP SCALE IN FEET (XXXXX) = RECORD DIMENSION

MAP LEGEND
 • IRON PIPE STAKE FOUND
 • IRON PIPE STAKE SET
 • IRON ROD STAKE FOUND
 • IRON ROD STAKE SET
 • CONCRETE MONUMENT FOUND
 (XXXXX) = RECORD DIMENSION

NOTE: OTHER STATES EXIST WHICH DO NOT AGREE WITH ANY PLATS OR RECORDS FOUND IN COUNTY SURVEYOR'S FILES

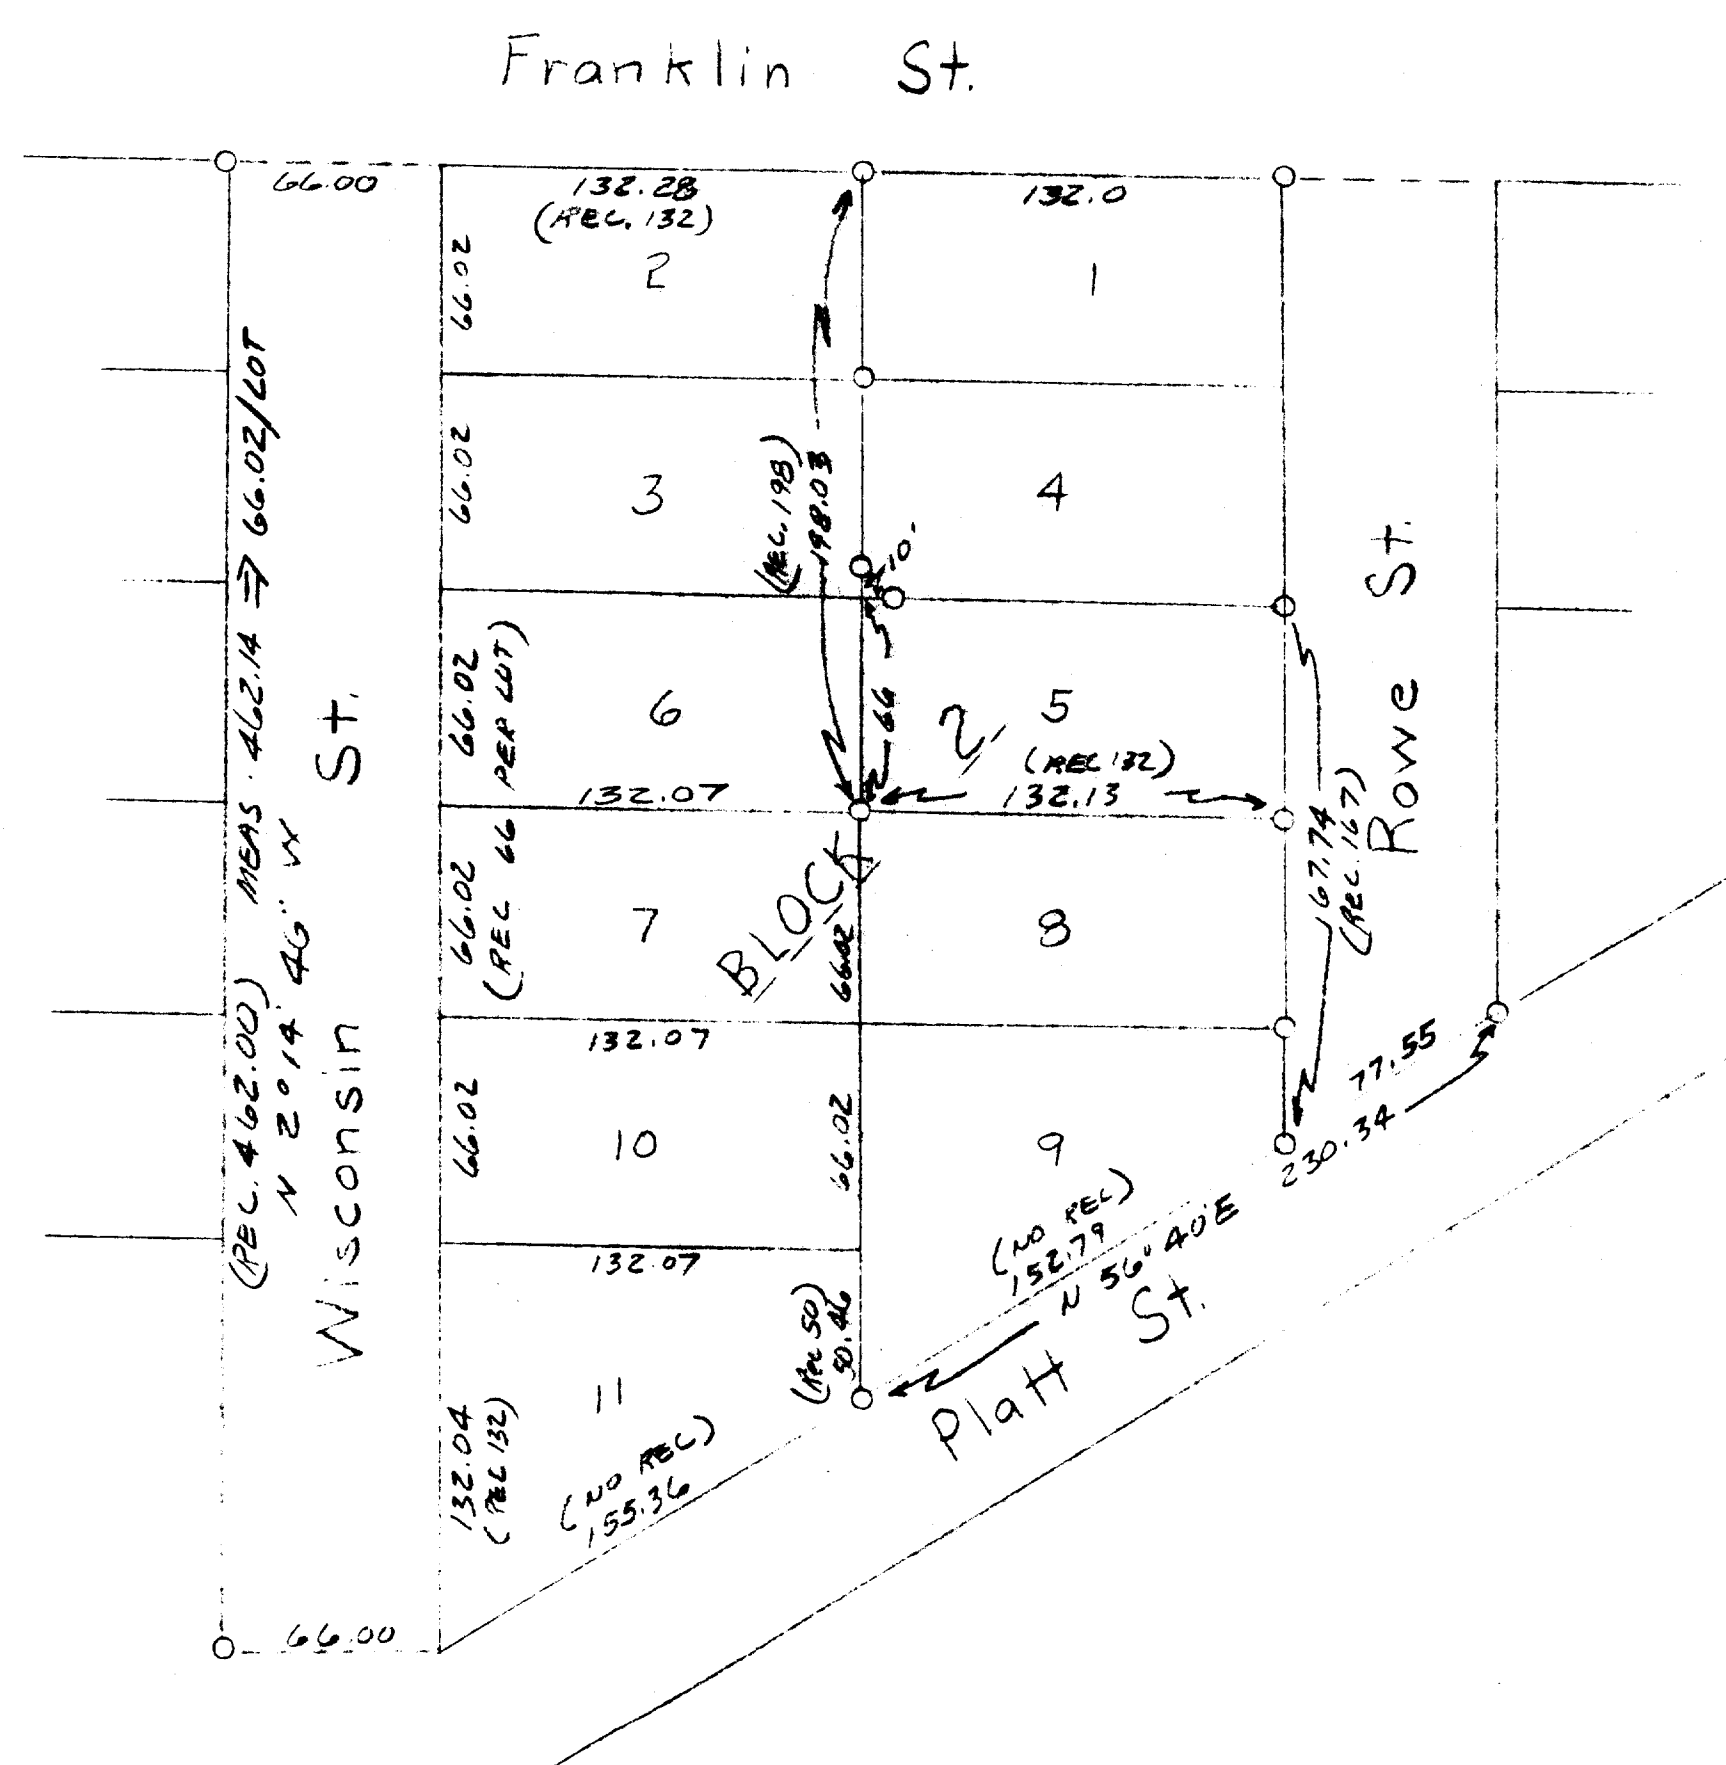

Franklin St.

Wisconsin St.

Platt St.

DATED: DEC. 11, 1990


PROJ. NO. 3414

SHEET 2 OF 2

Farris, Hansen & Associates, Inc.

7 RIDGEWAY COURT, P.O. BOX 437, ELKHORN, WISCONSIN TEL. 414-723-2098
 LOCATION: LOT 11, BLOCK 2, J.H. ROWE'S ADD.
 DESCRIPTION: GENOA CITY, WALWORTH CO., WI.
 WORK ORDERED BY: JEROME BERGER
 MAP SCALE IN FEET (XXXXX) = RECORD DIMENSION

MAP LEGEND
 • IRON PIPE STAKE FOUND
 • IRON PIPE STAKE SET
 • IRON ROD STAKE FOUND
 • IRON ROD STAKE SET
 • CONCRETE MONUMENT FOUND
 (XXXXX) = RECORD DIMENSION

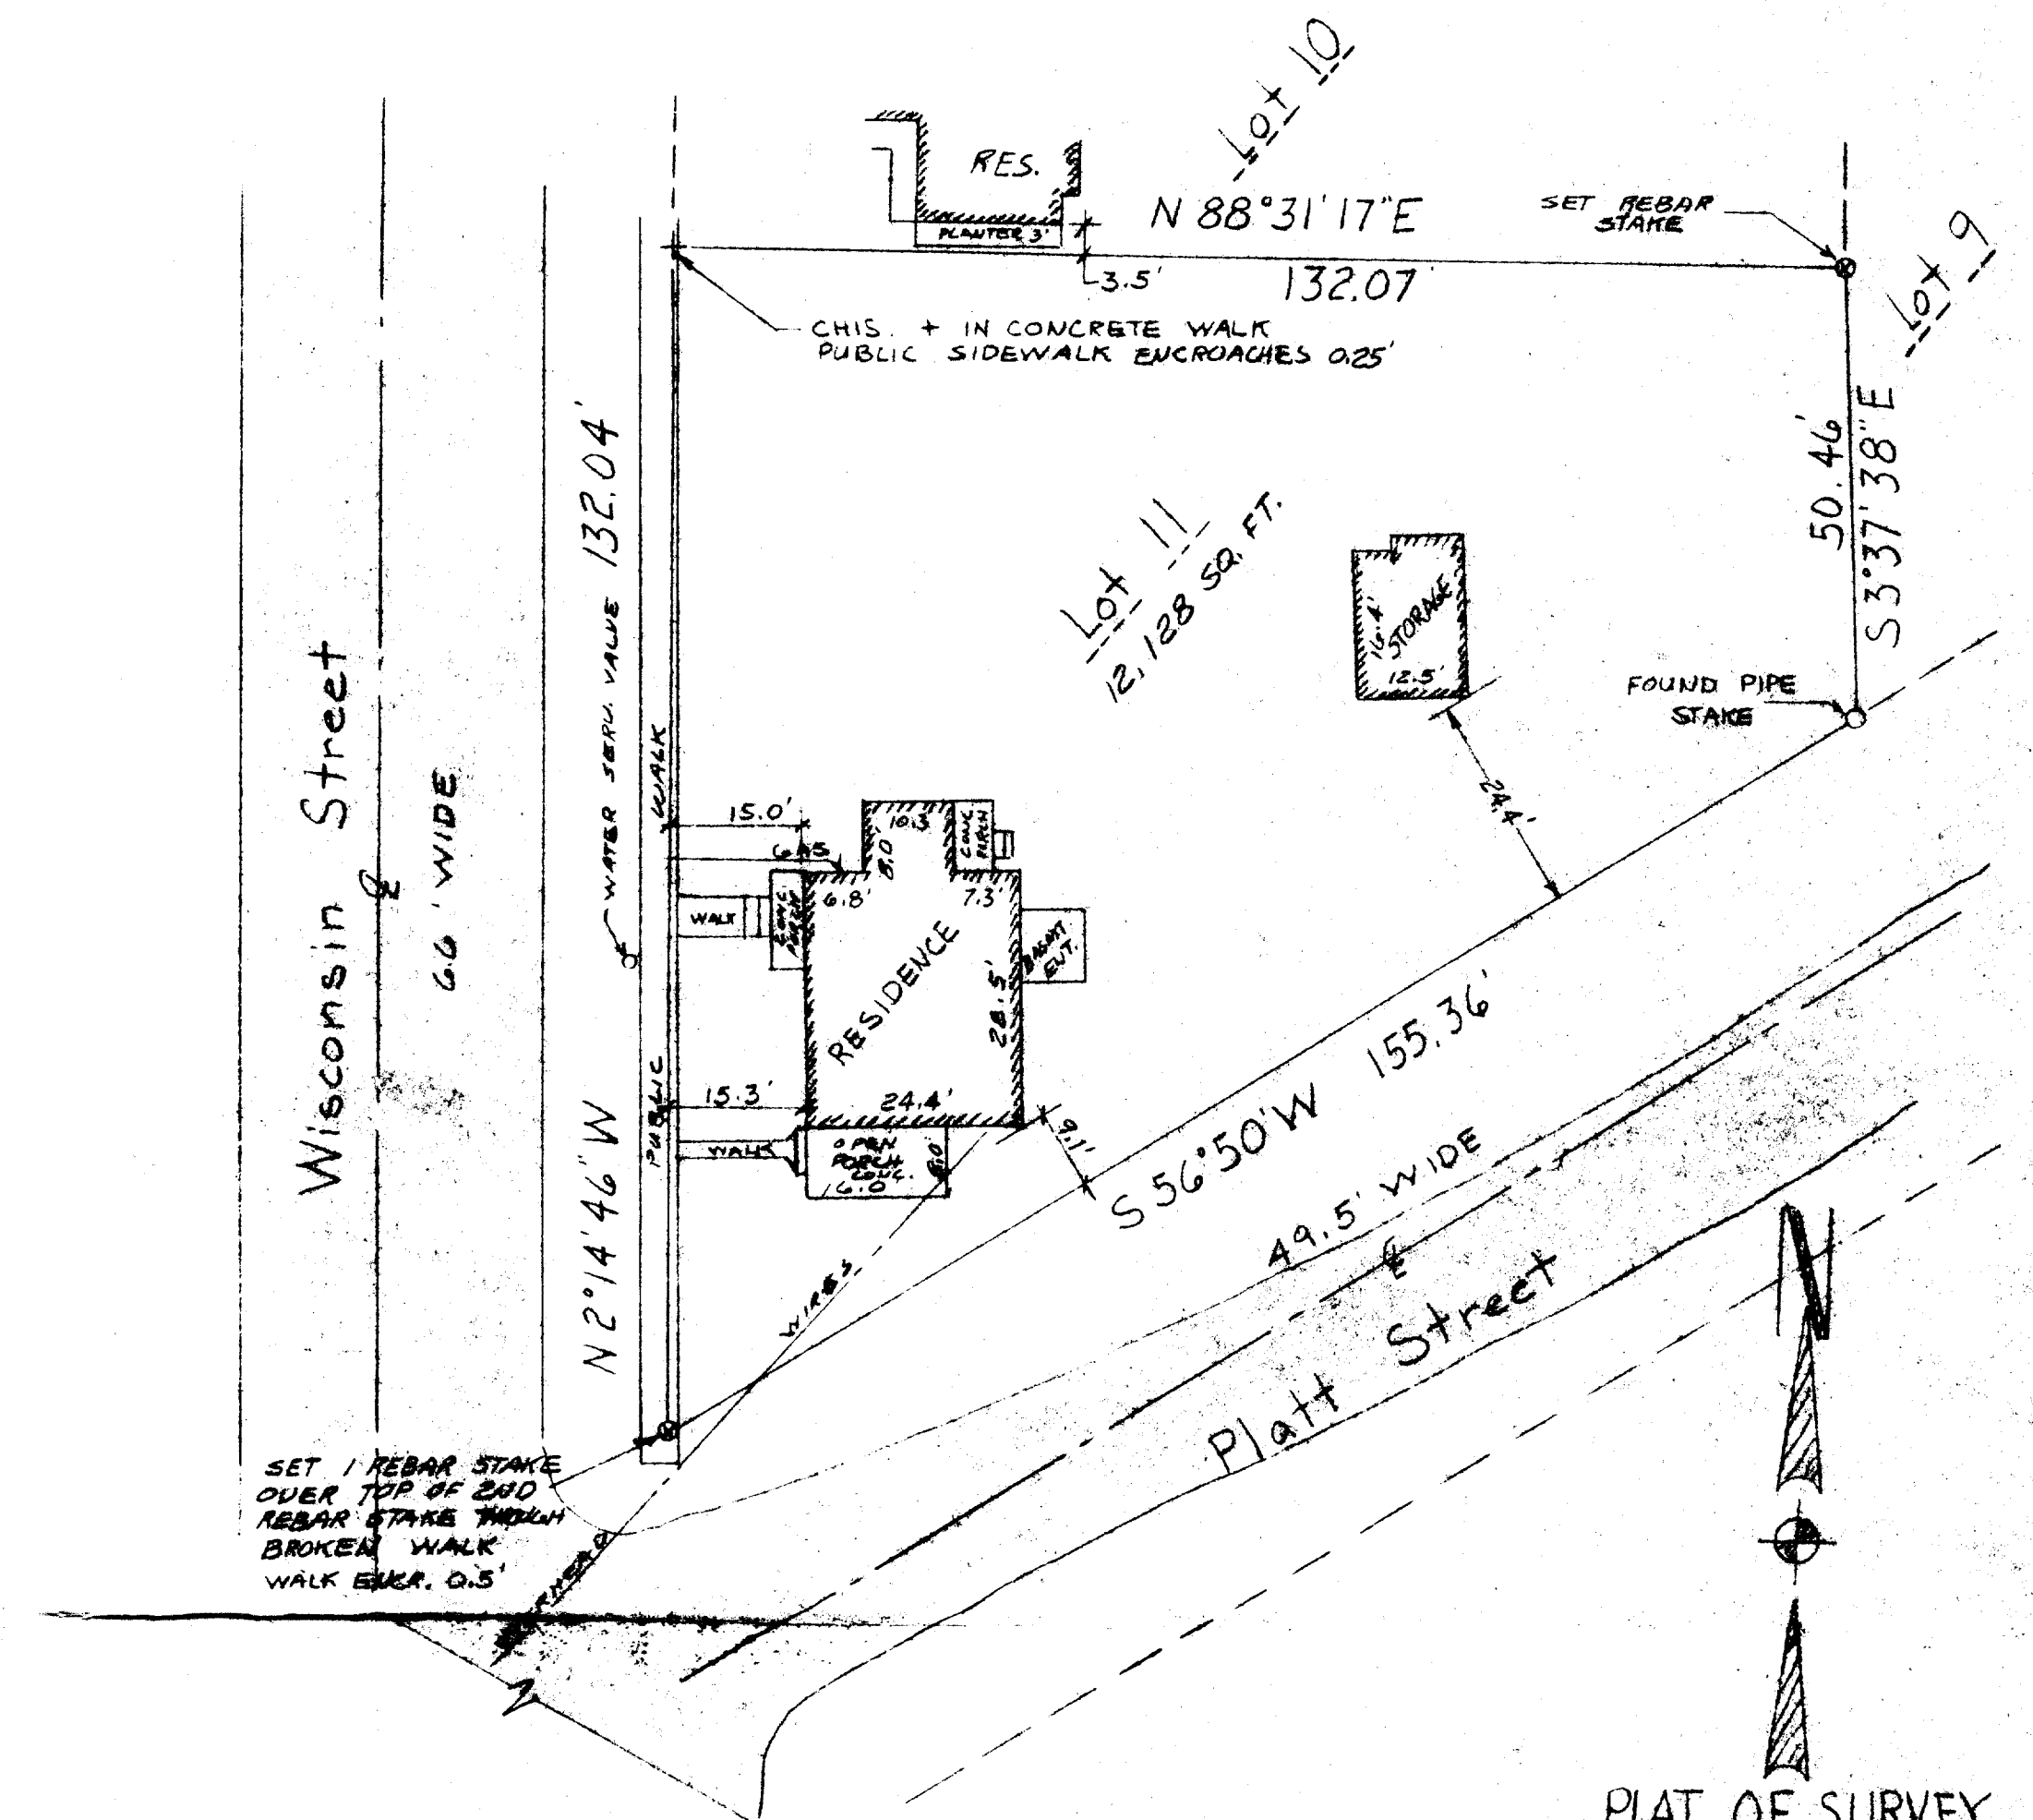

PLAT OF SURVEY

NOTE: COPIES OF THIS MAP TO WHICH THE FOLLOWING CERTIFICATE WILL APPLY ARE BLUE LINE PRINTS SHOWING SURVEYOR'S SEAL AND SIGNATURE IN BLACK INK. COPIES BY ANY OTHER MEANS MAY HAVE ALTERATIONS WHICH DO NOT REPRESENT THE SURVEYOR'S WORK PRODUCT.

I hereby certify that the above described property has been surveyed under my direction and that the above map is a true representation thereof and shows the size and location of the property, its exterior boundaries, the location of all visible structures and dimensions of all principal buildings thereon, boundary fences, apparent easements, road-ways and visible encroachments, if any. This survey is made for the use of the present owners of the property, and also those who purchase, mortgage, or guarantee the title thereto within one year from the date hereof.

DATED: DEC. 11, 1990

PROJ. NO. 3414.11

SHEET 1 of 2 SHEETS

TR00007 TR00014
 TR00008 TR00015
 TR00009 TR00016
 TR00010
 TR00011
 TR00012
 TR00013