
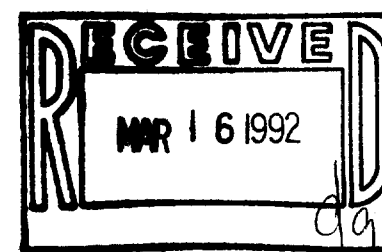
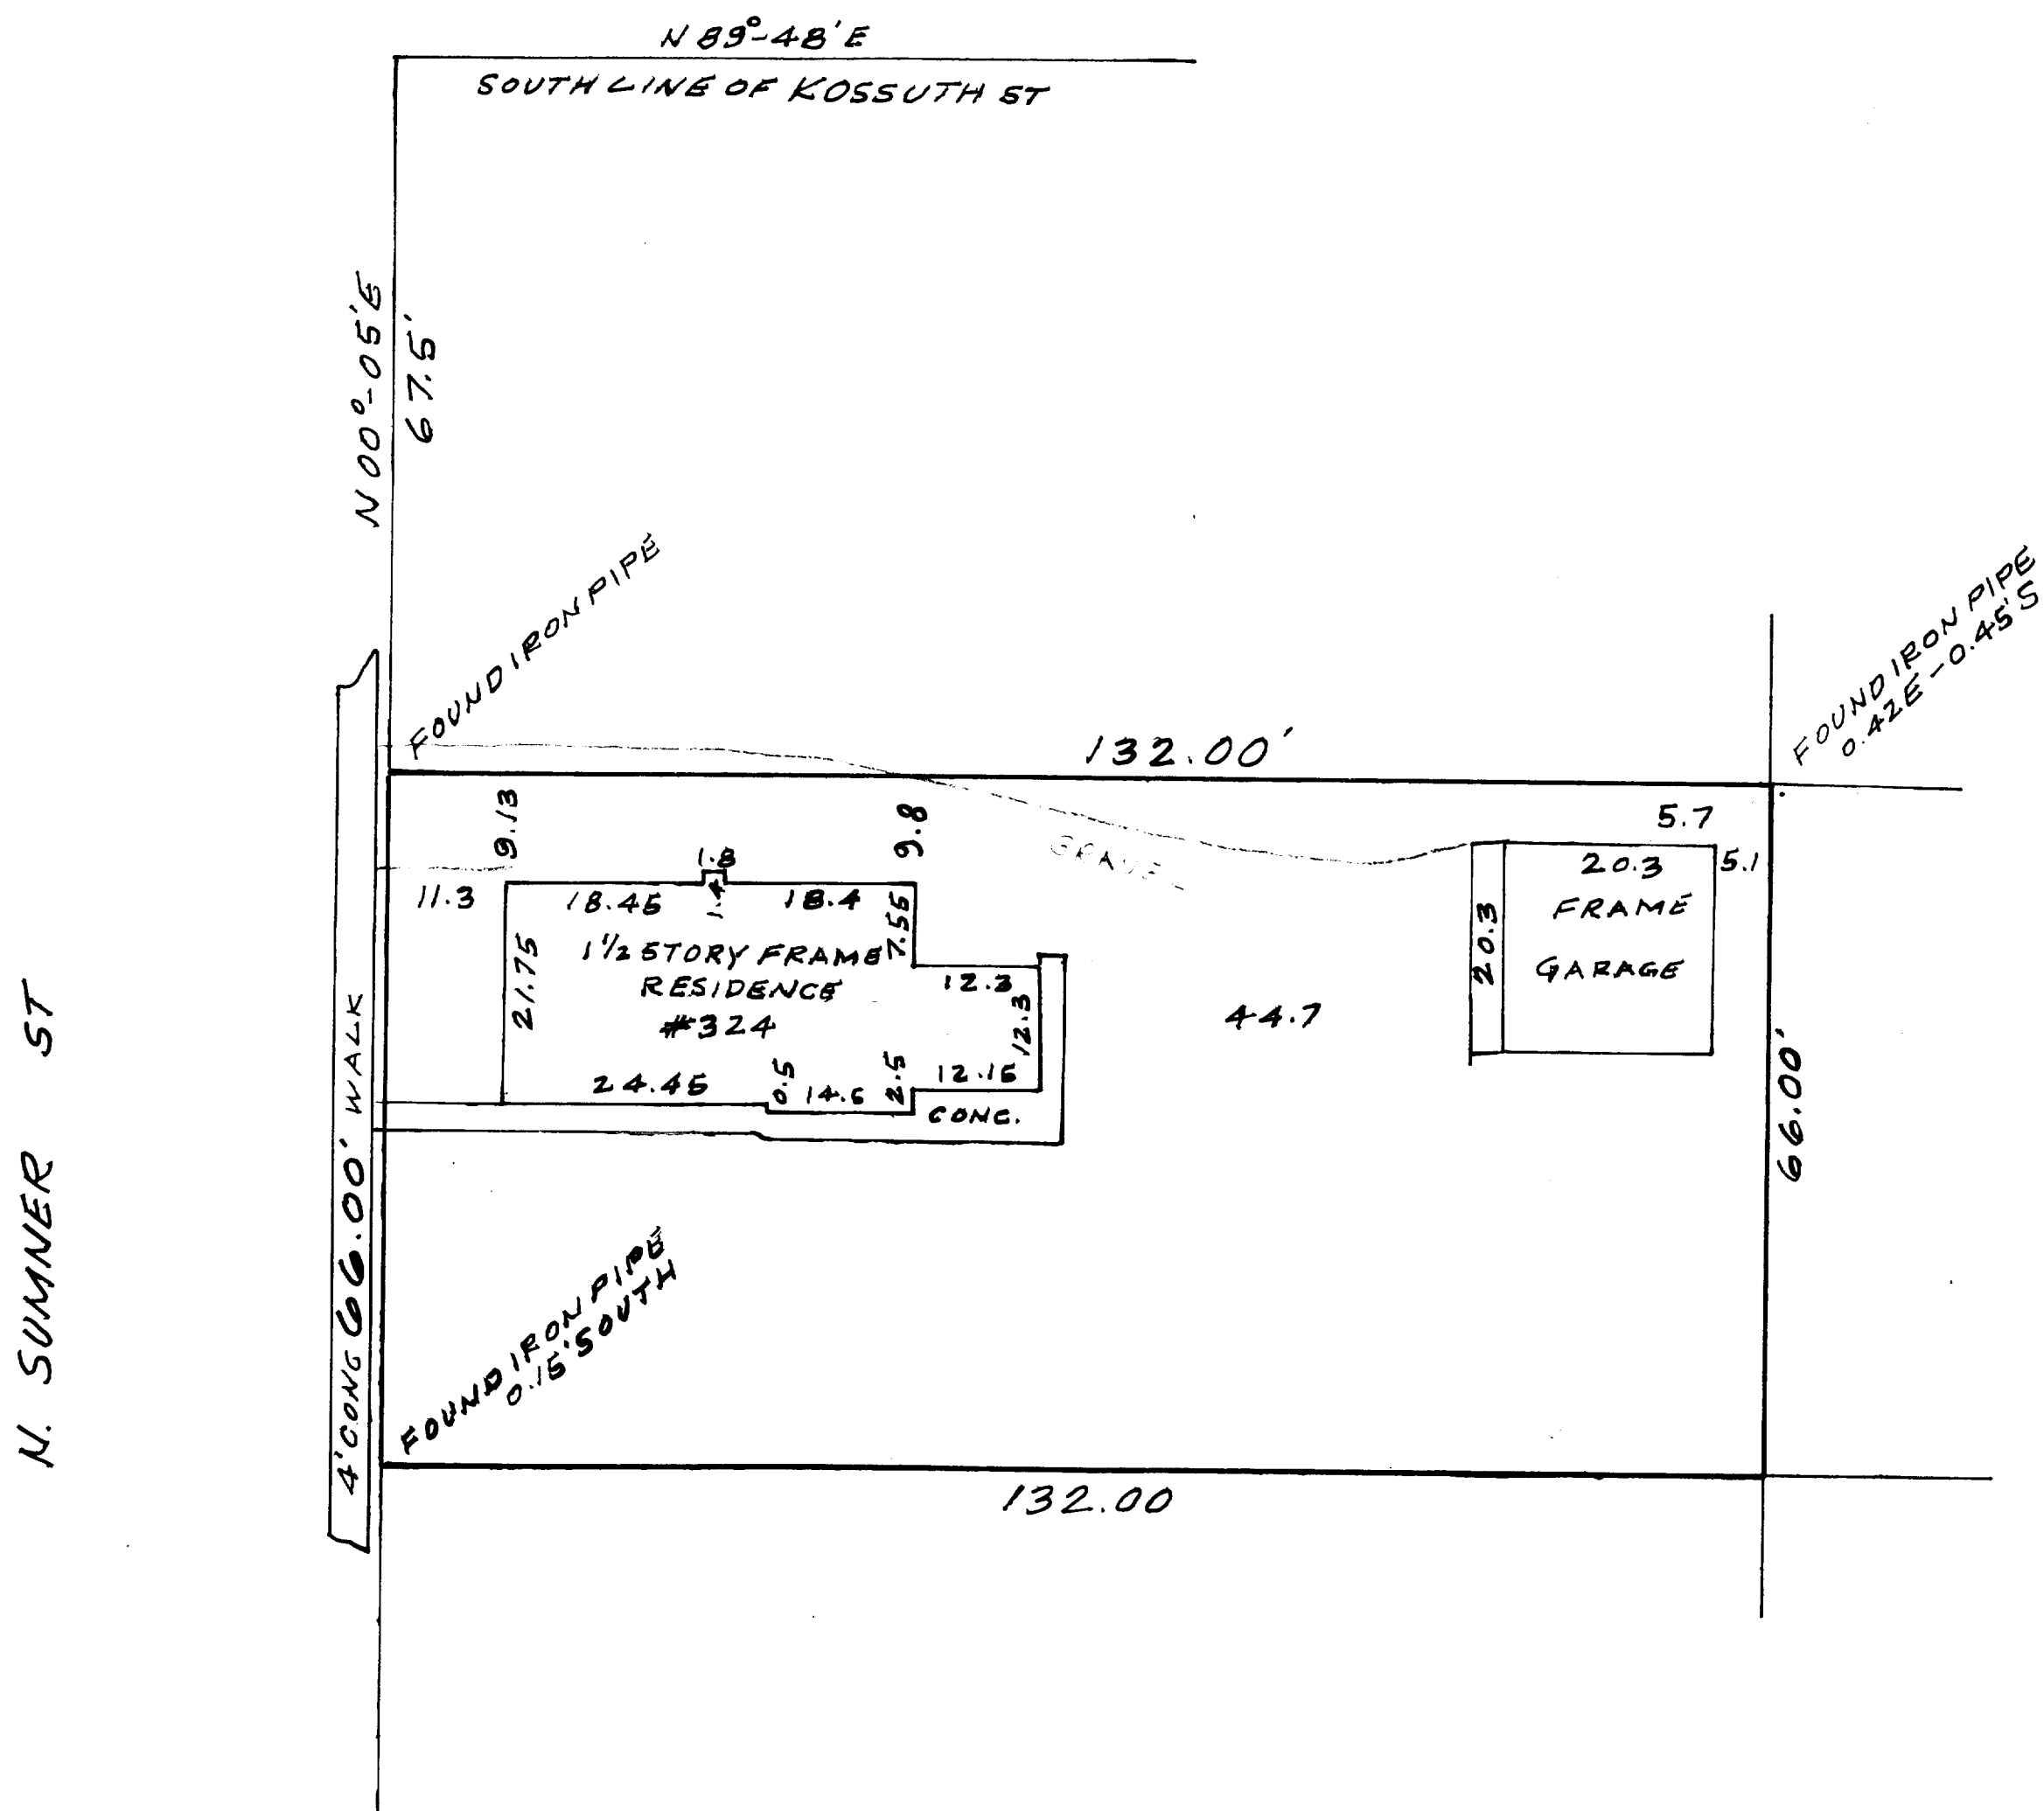


CENTURY LAND SURVEYING

PLAT OF SURVEY OF

LOT 3 IN BLOCK 7 OF FREEMAN'S SECOND ADDITION
TO THE VILLAGE OF GENOA JUNCTION, NOW KNOWN
AS GENOA CITY, WALWORTH COUNTY, WISCONSIN.

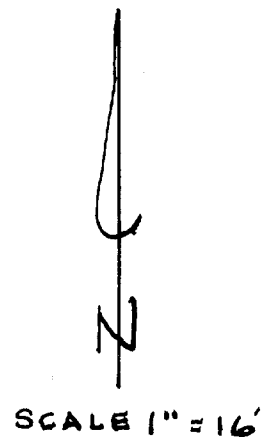

ORDER NO. 210

ORDERED BY M. SIRENO
FIELD BOOK CES PAGE 51

ALL DIMENSIONS ARE GIVEN IN FEET AND
DECIMAL PARTS THEREOF AND ARE CORRECT
AT 68° FAHRENHEIT.

NOTE ANY DISCREPANCY IN MEASUREMENT
DISCOVERED UPON THE GROUND SHOULD
BE PROMPTLY REPORTED TO THE SURVEYOR
FOR EXPLANATION OR CORRECTION.

TELE. 414-248-9423

DATE FEBRUARY 21, 1992

STATE OF WISCONSIN)
WALWORTH COUNTY) SS

CHARLES E. SMITH HEREBY CERTIFIES
THAT HE HAS SURVEYED THE ABOVE
DESCRIBED PROPERTY AND THAT THE
PLAT HEREON DRAWN IS A CORRECT
REPRESENTATION OF SAME.

Charles E. Smith
WISCONSIN REGISTERED
LAND SURVEYOR NO 51038