


KOLB LAND CONSULTING, INC.  
 LAND SURVEYING · SUBDIVIDING · LAND PLANNING

929 WILLIAMS STREET LAKE GENEVA, WISCONSIN 53147 414-248-3697



NOTE: THIS IS A LOT LINE ADJUSTMENT.

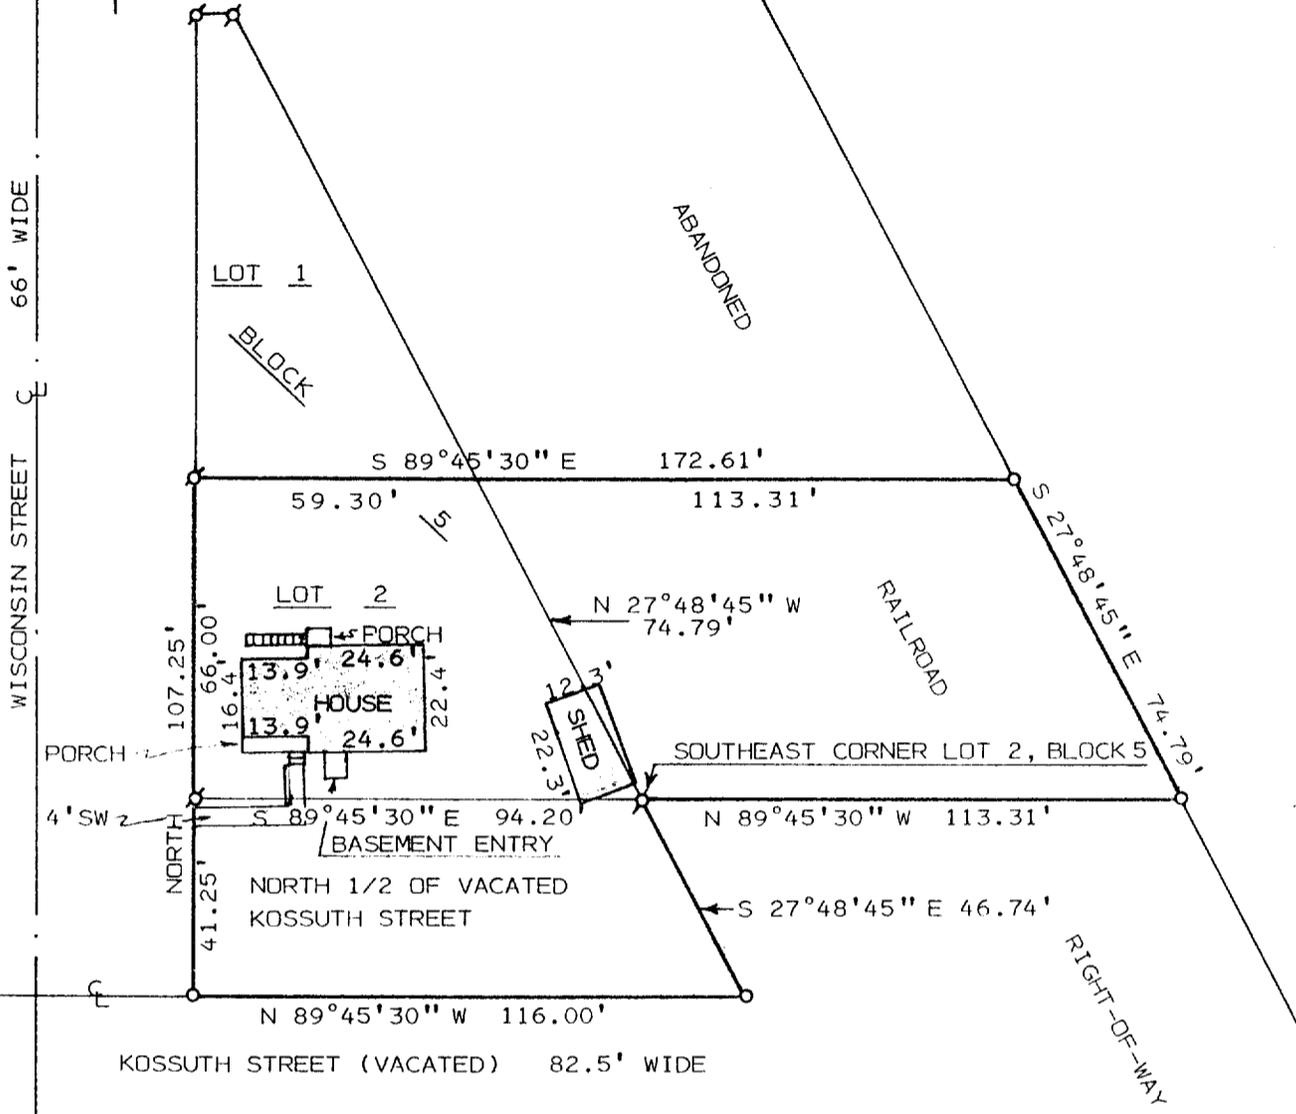

I HEREBY CERTIFY THAT I HAVE SURVEYED THE ABOVE DESCRIBED PROPERTY AND THAT THE ABOVE MAP IS A TRUE REPRESENTATION THEREOF AND SHOWS THE SIZE AND LOCATION OF THE PROPERTY, ITS EXTERIOR BOUNDARIES, THE LOCATION OF ALL VISIBLE STRUCTURES AND DIMENSIONS OF ALL PRINCIPAL BUILDINGS THEREON, BOUNDARY FENCES, APPARENT EASEMENTS, ROADWAYS AND VISIBLE ENCROACHMENTS, IF ANY, TO THE BEST OF MY KNOWLEDGE AND BELIEF.

THIS SURVEY IS MADE FOR THE USE OF THE PRESENT OWNERS OF THE PROPERTY, AND ALSO THOSE WHO PURCHASE, MORTGAGE, OR GUARANTEE THE TITLE THERETO WITHIN ONE (1) YEAR FROM DATE HEREOF. THIS SURVEY IS NOT VALID UNLESS THE SURVEYOR'S SIGNATURE IS IN RED.

SCALE : 1" = 40'  
 LEGEND

- ⊘ - IRON PIPE FOUND
- - IRON PIPE SET
- ⊙ - IRON ROD FOUND
- SW - SIDEWALK

HAROLD H. KOLB  
 WISCONSIN REGISTERED LAND SURVEYOR, S-187  
 DATE DECEMBER 5, 1990  
 REVISED \_\_\_\_\_  
 REVISED \_\_\_\_\_

006-282

KOLB LAND CONSULTING, INC.  
LAND SURVEYING · SUBDIVIDING · LAND PLANNING

929 WILLIAMS STREET LAKE GENEVA, WISCONSIN 53147 414-248-3697

1006-282  
Genoa City

PLAT OF SURVEY OF

LOT 2, BLOCK 5, FREEMAN'S SECOND ADDITION, A SUBDIVISION LOCATED IN THE SOUTHEAST 1/4 OF SECTION 35, T 1 N, R 18 E, VILLAGE OF GENOA CITY, WALWORTH COUNTY, WISCONSIN.

ALSO THE NORTH 1/2 OF VACATED KOSSUTH STREET DESCRIBED AS FOLLOWS: BEGINNING AT THE SOUTHEAST CORNER OF SAID LOT 2, BLOCK 5, THENCE S 27°48'45" E 46.74 FEET TO THE CENTERLINE OF KOSSUTH STREET; THENCE N 89°45'30" W 116.00 FEET ALONG SAID CENTERLINE; THENCE NORTH 41.25 FEET TO THE NORTH LINE OF KOSSUTH STREET; THENCE S 89°45'30" E 94.20 FEET ALONG THE NORTH LINE OF KOSSUTH STREET TO THE PLACE OF BEGINNING.

ALSO A PARCEL OF LAND FORMERLY THE CHICAGO AND NORTHWESTERN RAILROAD (NOW ABANDONED) DESCRIBED AS FOLLOWS: BEGINNING AT THE SOUTHEAST CORNER OF SAID LOT 2, BLOCK 5, THENCE N 27°48'45" W 74.79 FEET; THENCE S 89°45'30" E 113.31 FEET; THENCE S 27°48'45" E 74.79 FEET; THENCE N 89°45'30" W 113.31 FEET TO THE PLACE OF BEGINNING.

NOTE: BEARING OF THE NORTH LINE OF KOSSUTH STREET IS ASSUMED N 89°45'30" W AS SHOWN ON EXISTING SURVEY RECORDS.

ORDERED BY: JOHN HABREL  
P.O. BOX 231  
GENOA CITY WI 53128

HAROLD H. KOLB  
WISCONSIN REGISTERED LAND SURVEYOR, S-187  
DATE DECEMBER , 1990  
REVISED \_\_\_\_\_  
REVISED \_\_\_\_\_

1006-282