

PLAT OF SURVEY
OF

LOT 16, MILLER'S ADDITION TO VILLAGE OF GENOA CITY, WALWORTH COUNTY, WISCONSIN.

I HEREBY CERTIFY THAT I HAVE SURVEYED THE LAND DESCRIBED ABOVE AND THAT THE PLAT DRAWN HEREON IS A CORRECT REPRESENTATION OF SAID SURVEY. I FURTHER CERTIFY THAT THE BUILDINGS ON SAID LAND ARE LOCATED AS SHOWN ON THIS PLAT.

FOR: EVELYN KRUMHOLTZ, SELLER }
JOHN HODGES, BUYER } 1975
AUDREY BUKH, REALTOR }
HABOCD 1992

JOHN F. DEGEN, LAND SURVEYOR S 242
589 N. PINE ST., BURLINGTON, WISCONSIN.

RESURVEYED 12-28-92
4-3-75

SCALE 1" = 30'

Q = IRON PIPE STAKE FOUND.



STREET ADDRESS: 928 FREEMAN ST.,
GENOA CITY, WIS.

I have surveyed the above-described property, and the map hereon is a true representation thereof and shows the size and location of the property, its exterior boundaries, the location and dimensions of all visible structures thereon, fences, apparent easements and roadways and visible encroachments, if any.

This survey is made for the exclusive use of the present owners of the property, and also those who purchase, mortgage, or guarantee the title thereto, within one year from date hereof.

Dated at Burlington, this 28th day,
of DEC, 1975

John F. Degen
John F. Degen, Land Surveyor S 242
589 N. Pine St. Burlington, WI 53105

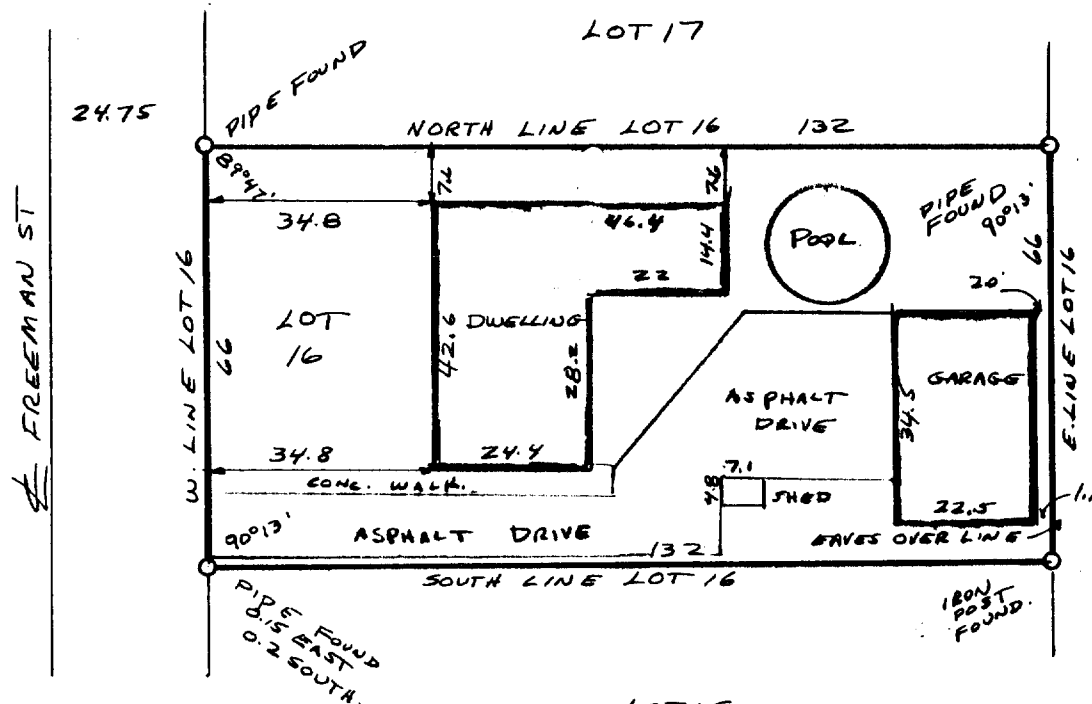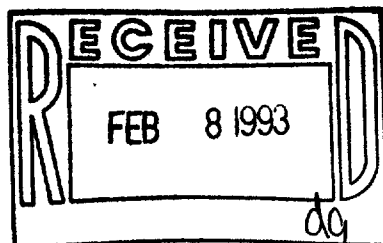

JMA-16