


KOLB LAND CONSULTING, INC.
LAND SURVEYING • SUBDIVIDING • LAND PLANNING

LAKE GENEVA, WISCONSIN 53147

414-248-3697

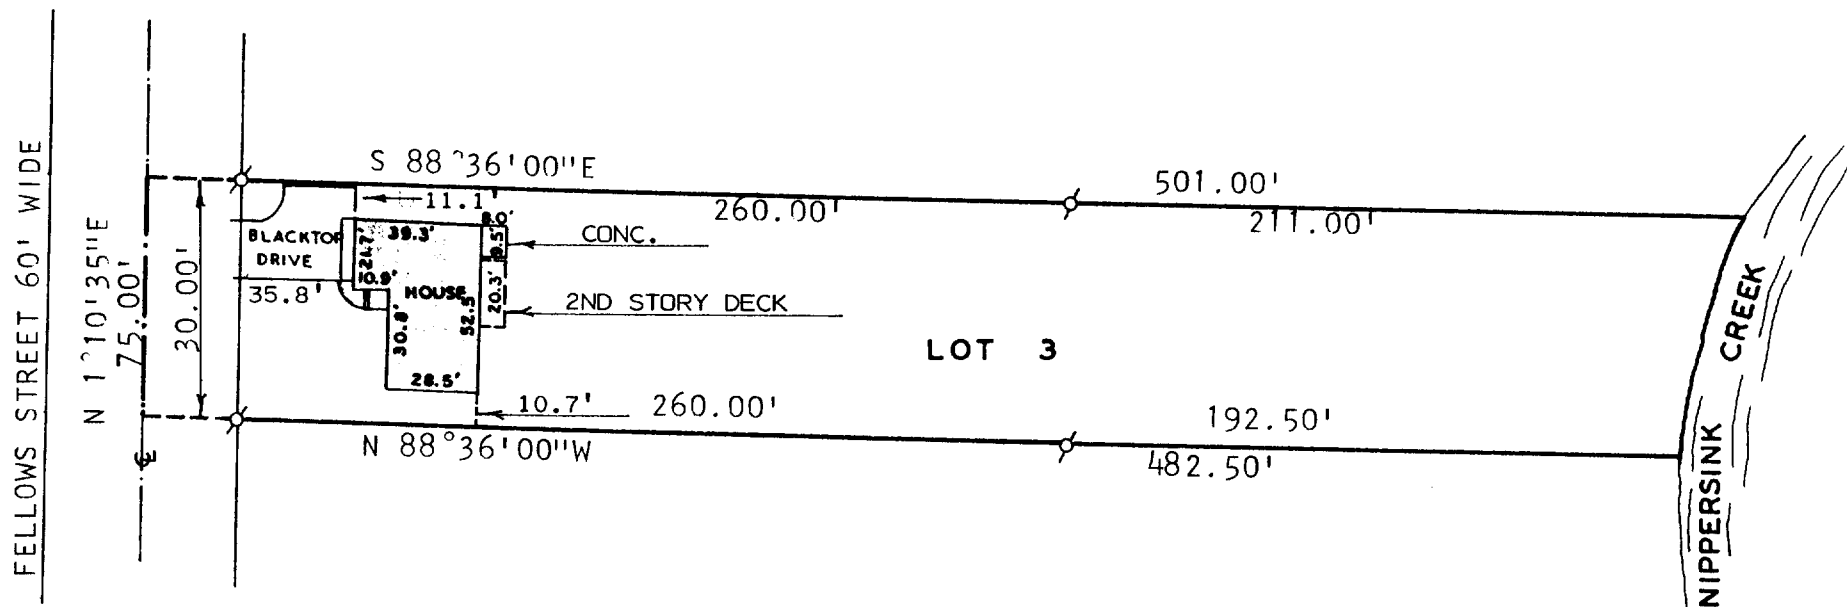

PLAT OF SURVEY OF

A HOUSE LOCATION ON A PARCEL OF LAND LOCATED IN THE
SOUTHEAST 1/4 OF SECTION 35, T 1 N R 18 E, VILLAGE
OF GENOA CITY, WALWORTH COUNTY, WISCONSIN.

LOT 3 OF C.S. 2233


ORDERED BY: RICHARD B. HILLER
3806 N. HILLCREST PL.
JOHNSBURG, IL.

NOTE: BEARINGS ARE ASSUMED AS SHOWN ON RECORDED
CERTIFIED SURVEY MAP.



SCALE: 1" = 60'

LEGEND
Ø - IRON PIPE FOUND

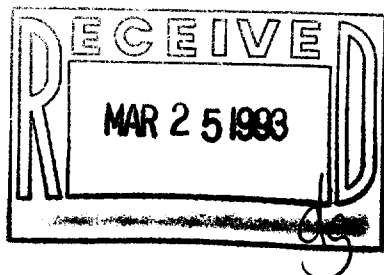

I HEREBY CERTIFY THAT I HAVE SURVEYED THE
ABOVE DESCRIBED PROPERTY AND THAT THE ABOVE
MAP IS A TRUE REPRESENTATION THEREOF AND
SHOWS THE SIZE AND LOCATION OF THE PROPERTY,
ITS EXTERIOR BOUNDARIES, THE LOCATION OF ALL
VISIBLE STRUCTURES AND DIMENSIONS OF ALL
PRINCIPAL BUILDINGS THEREON, BOUNDARY FENCES,
APPARENT EASEMENTS, ROADWAYS AND VISIBLE
ENCROACHMENTS, IF ANY, TO THE BEST OF MY
KNOWLEDGE AND BELIEF.
THIS SURVEY IS MADE FOR THE USE OF THE
PRESENT OWNERS OF THE PROPERTY AND ALSO
THOSE WHO PURCHASE, MORTGAGE OR GUARANTEE
THE TITLE THERETO WITHIN ONE (1) YEAR FROM
DATE HEREOF.
SURVEY NOT VALID UNLESS THE SURVEYOR'S SIGNATURE
IS IN RED.

HAROLD H. KOLB
WISCONSIN REGISTERED LAND SURVEYOR, S-187
DATE SEPT. 16, 1992

TA-2233-3

006-298