


FREEMAN

STREET

KOSSUTH

STREET

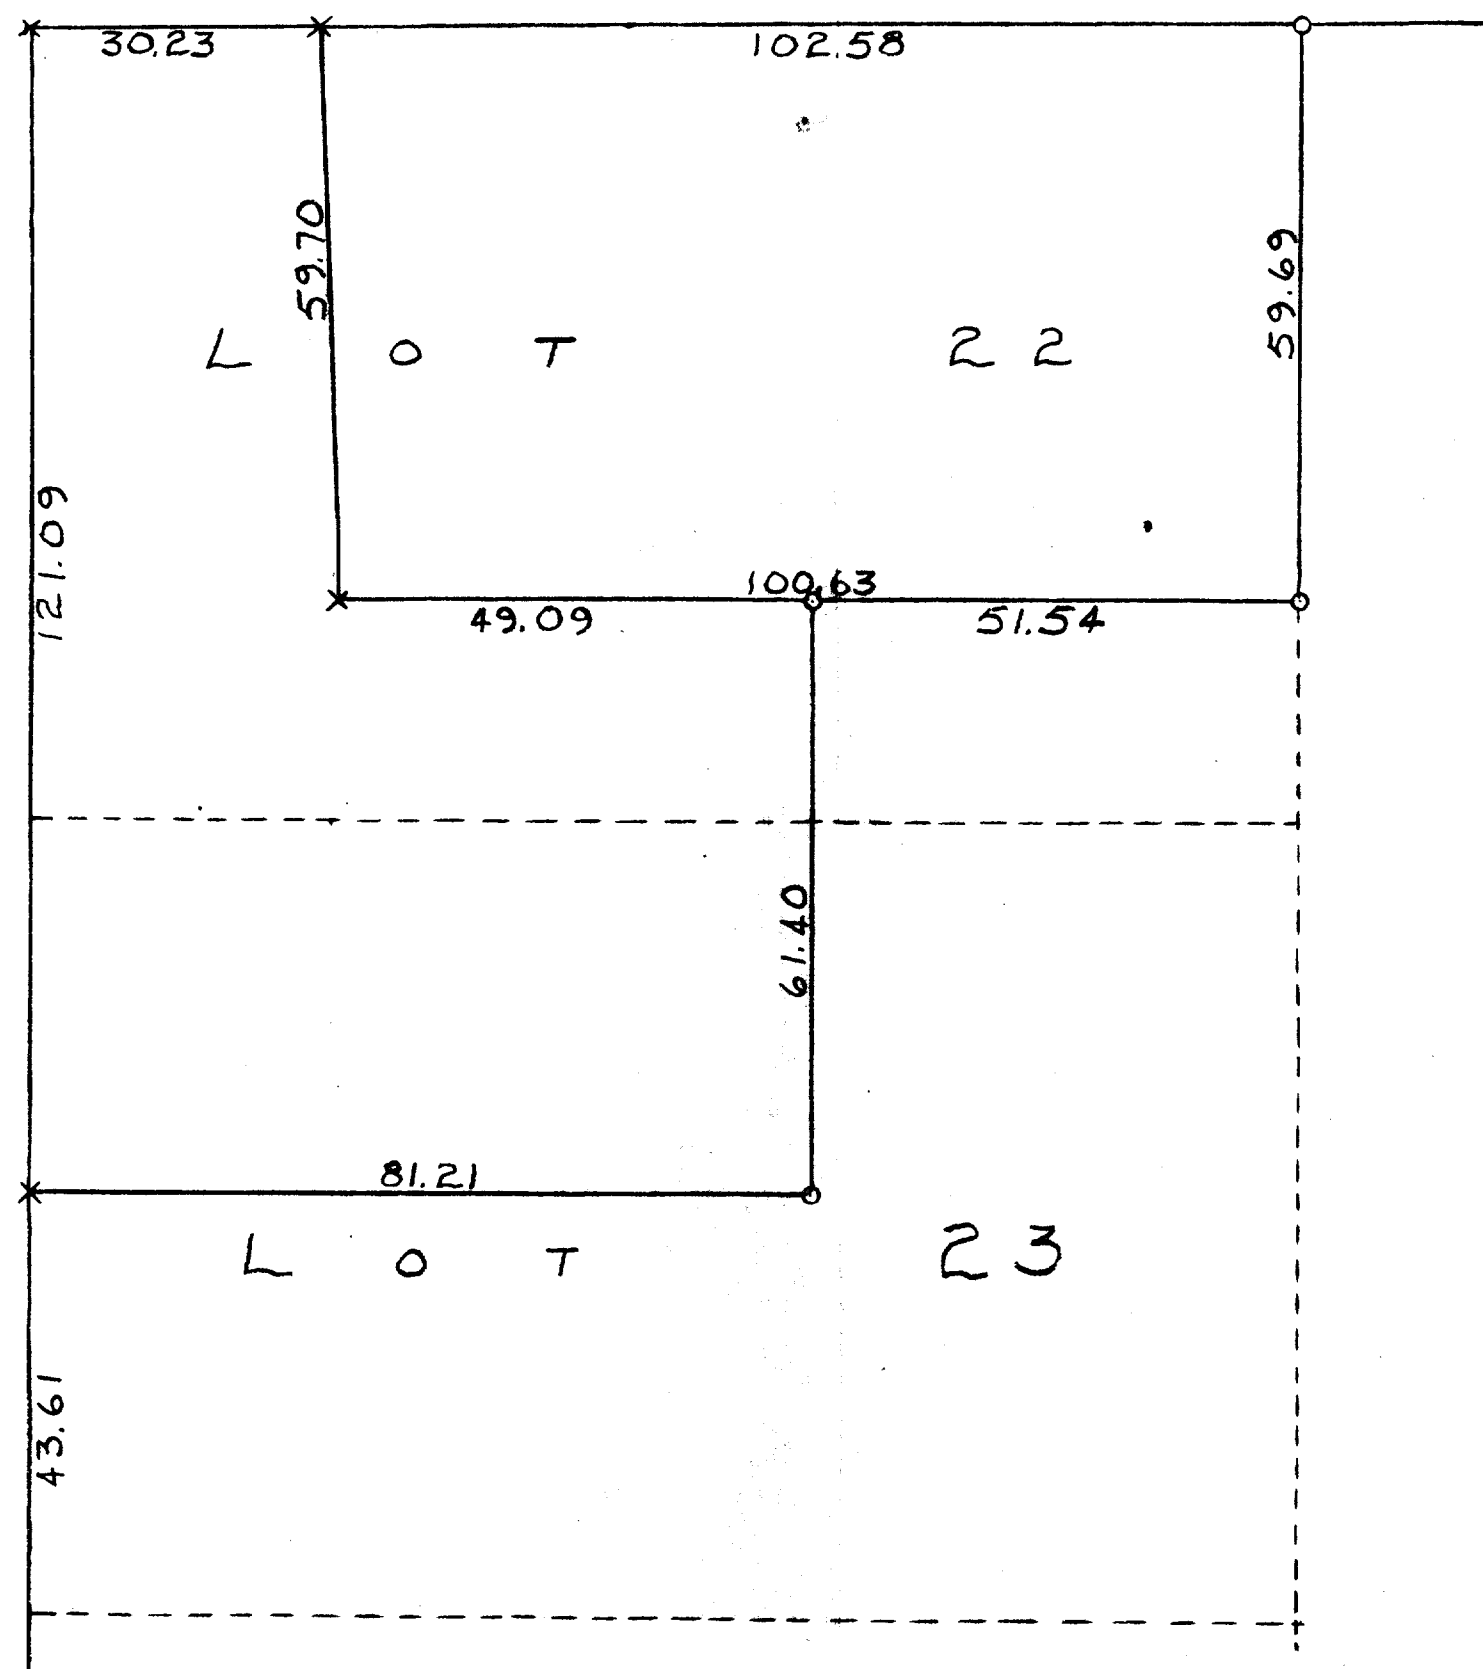

*CROSS IN CONC.
IRON PIPE OR ROD
SCALE - 1" = 20'

STATE OF WISCONSIN)
COUNTY OF WALWORTH)

I, GEORGE T. DUNHAM, DO HEREBY CERTIFY THAT I HAVE SURVEYED A PART OF
LOTS 22 AND 23 OF FREEMAN'S ADDITION TO GENOA JUNCTION (NOW GENOA CITY)
WALWORTH COUNTY, WISCONSIN, AND THAT THE ABOVE PLAT IS A CORRECT
REPRESENTATION OF SUCH SURVEY.
MARCH 13, 1957

George T. Dunham
GEORGE T. DUNHAM,
DELAVER, WISCONSIN
WIS. LAND SURVEYOR No. S-306

6-3