

PLAT OF SURVEY
OF

LOT 3, BLOCK 1, STRAIN'S ADDITION, LOCATED IN SECTION 35, T. 1 N., R. 18 E. OF THE 4TH P.M., VILLAGE OF GENOA CITY, WALWORTH COUNTY, WISCONSIN.

FOR: ERA ACTION REALTY



SCALE 1" = 20'

⌀ = IRON PIPE STAKE FOUND.

ST. ADDRESS: 509 MAIN ST.

GENOA CITY, WI. 53128

o = IRON BOLT SET.

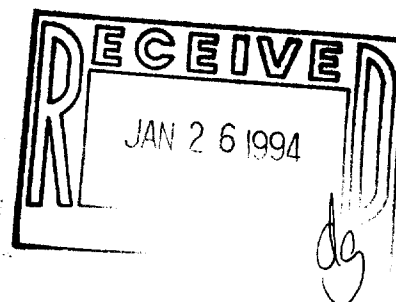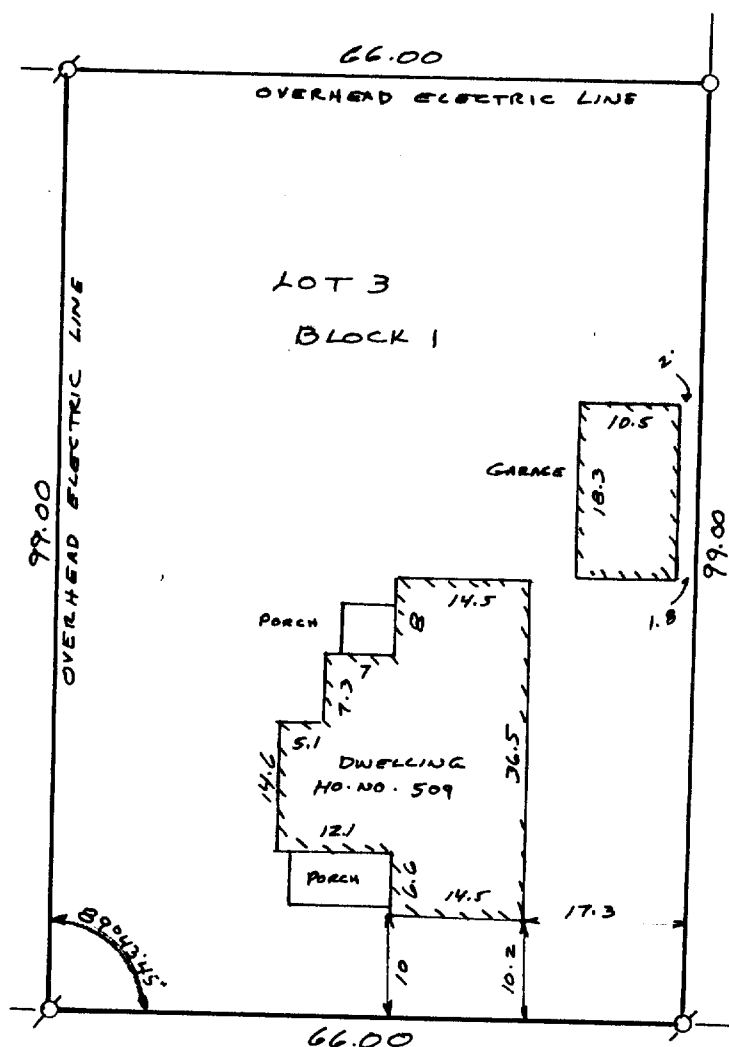

I have surveyed the above-described property, and the map herein is a true representation thereof and shows the size and location of the property, its exterior boundaries, the location and dimensions of all visible structures thereon, fences, apparent easements and roadways and visible encroachments, if any.

This survey is made for the exclusive use of the present owners of the property, and also those who purchase, mortgage, or guarantee the title thereto, within one year from date hereof.

Dated at Burlington, this 21ST day, of JANUARY, 1994

John F. Degen
John F. Degen, Land Surveyor S 242
589 N. Pine St. Burlington, WI 53105

MAIN ST