


Plat of Survey

of




VOL 580 PAGE 337

All the following described real estate except the N. 99.5 ft. thereof, beginning at the S 1/4 corner of Sec. 35 T. 1 N. R. 18 E., of the 4th P.M., Township of Bloomfield, County of Walworth, State of Wisconsin, run thence N. on the N. and S. 1/4 Section line 500.00 ft. to a point, said point marks the place of beginning of parcel of land hereinafter described, run thence S. 89 deg. 58' W. 200.00 ft. to a point, thence S. 187.15 ft. to a point, thence S. 34 deg. 04' W. 15.52 ft. to a point, thence N. 89 deg. 58' E. 206.85 ft. to a point, thence N. 34 deg. 04' E. 3.29 ft. to a point, thence N. 197.26 ft. to a point and the place of beginning, said parcel of land is located in the SW 1/4 of Sec. 35, T. 1 N. R. 18 E. of the 4th P.M., Township of Bloomfield, County of Walworth, State of Wisconsin.

Tax Key No. TVGC-59C

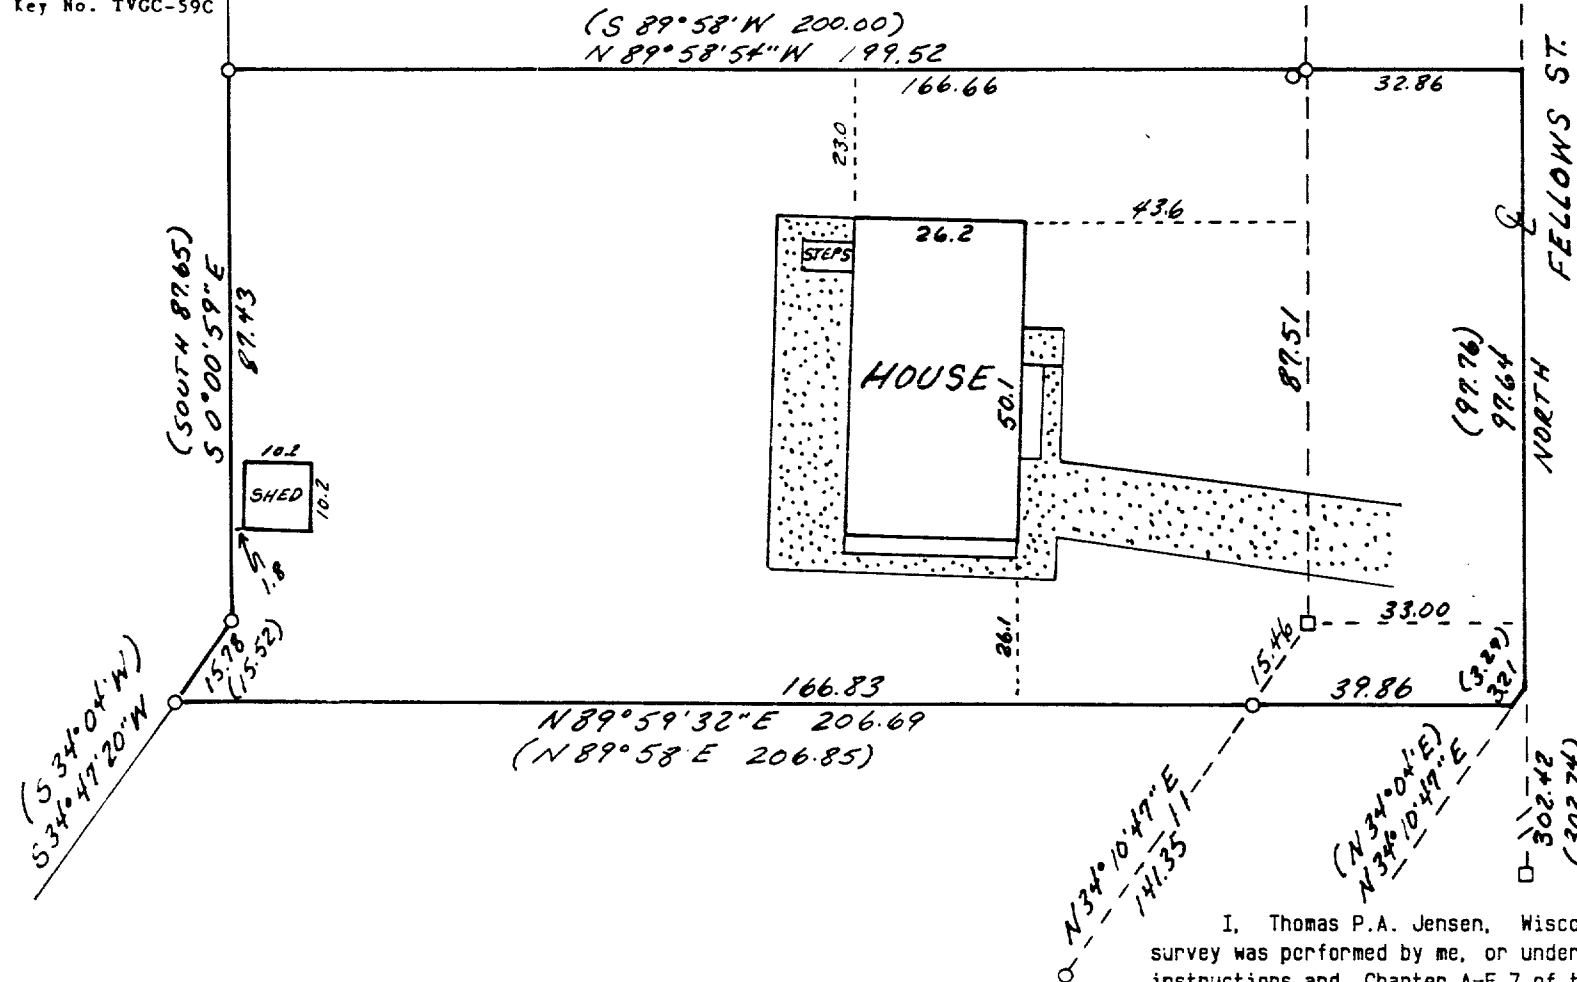

Surveyed for: MARION FROSHIESER
041 FELLOWS STREET
GENOA CITY, WISCONSIN. 53205

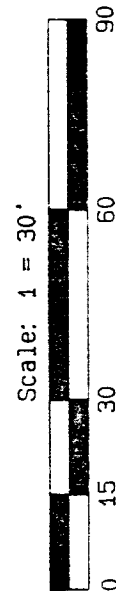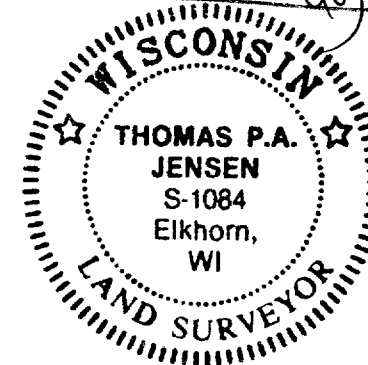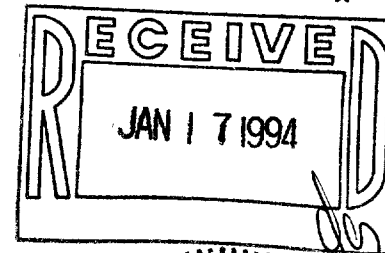

Copyright © 1993 by Jensen Surveying & Mapping S.C.

All rights reserved. No part of this survey plat may be reproduced or transmitted in any form by any means - graphic, electronic, or mechanical, including photocopying, tracing, or information storage and retrieval systems - without permission in writing from Thomas P.A. Jensen.

I, Thomas P.A. Jensen, Wisconsin Registered Land Surveyor, do hereby certify that this survey was performed by me, or under my direction, in full compliance with the owner's/agent's instructions and Chapter A-E 7 of the Wisconsin Administrative Code 'Minimum Standards for Property Surveys', and that this map is an accurate representation thereof to the best of my knowledge and belief.

Note: This survey plat is not certified unless signed and sealed in red ink.

Thomas P.A. Jensen R.L.S. 1084

Jensen Surveying & Mapping S.C.

Mapping date: 8-19-93.

Revisions:

45 South Wisconsin Street P.O. Box 322
Elkhorn, Wisconsin. 53121.

(414) 723-3434

Legend

□ = Found concrete monument
○ = Found iron pipe, 1' dia.
▨ = Concrete surface

Sheet 1 of 1 Sheets

Job reference number:
1993.091

TVGC-59C

6-316