

PLAT OF SURVEY
OF

PARCELS "A" AND "B" OF WALWORTH COUNTY CERTIFIED SURVEY MAP NO. 844 FOR LAND LOCATED IN THE NORTHEAST 1/4 OF SECTION 35, T. 1 N., R. 18 E. OF THE 4TH P.M., VILLAGE OF GENOA CITY, WALWORTH COUNTY, WISCONSIN.

FOR: TYLER CREEK BUILDERS, INC.

SCALE 1" = 30'

○ = IRON PIPE STAKE SET.



⊘ = IRON PIPE STAKE FOUND.

I have surveyed the above-described property, and the map hereon is a true representation thereof and shows the size and location of the property, its exterior boundaries, the location and dimensions of all visible structures thereon, fences, apparent easements and roadways and visible encroachments, if any.

This survey is made for the exclusive use of the present owners of the property, and also those who purchase, mortgage, or guarantee the title thereto, within one year from date hereof.

Dated at Burlington, this 4th day, of May, 1995

John F. Degen
John F. Degen, Land Surveyor S 242
589 N. Pine St. Burlington, WI 53105

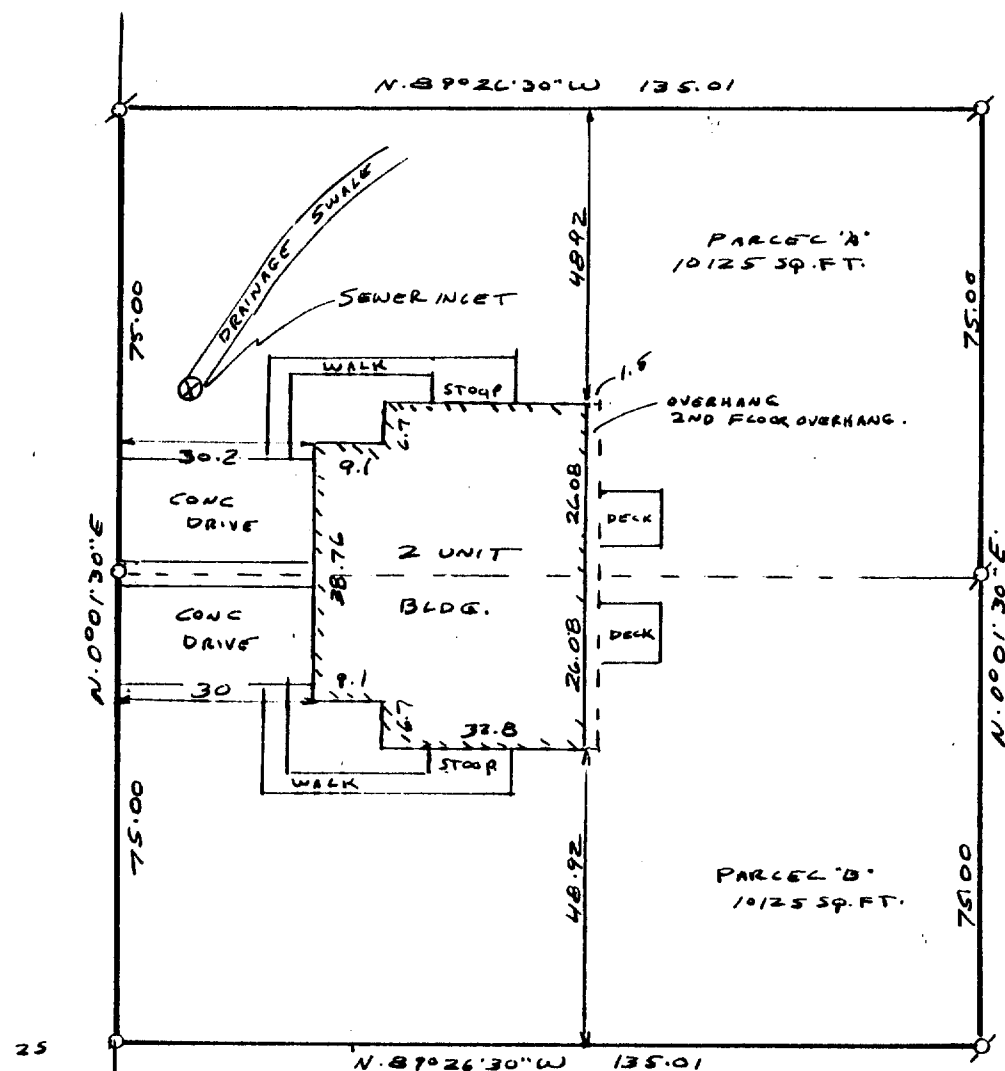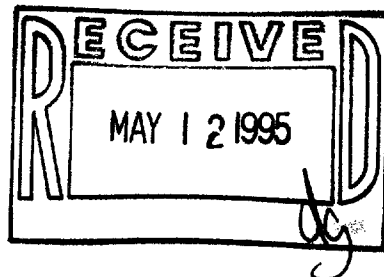

TA-844-1
TA-844-2

006-340