## FARRIS, HANSEN & ASSOCIATES, INC.

ENGINEERING, ARCHITECTURE, SURVEYING


7 RIDGWAY COURT - P.O.BOX 437, ELKHORN, WISCONSIN PHONE: (414) 723-2098 FAX: (414) 723-5886


## PLAT OF SURVEY

LOTS 3 & 4 OF

## GENOA TRAILS SUBDIVISION

A DIVISION OF LOT 3 OF CERTIFIED SURVEY MAP NO. 2191, RECORDED IN VOLUME NO. 10 ON PAGE NO. 277 OF WALWORTH COUNTY CERTIFIED SURVEY MAPS AS DOCUMENT NO. 239621 LOCATED IN THE NW 1/4 OF THE SW 1/4 OF SECTION 36, TOWN 1 NORTH, RANGE 18 EAST, VILLAGE OF GENOA CITY, WALWORTH COUNTY, WISCONSIN

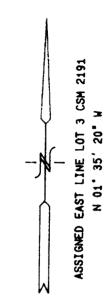

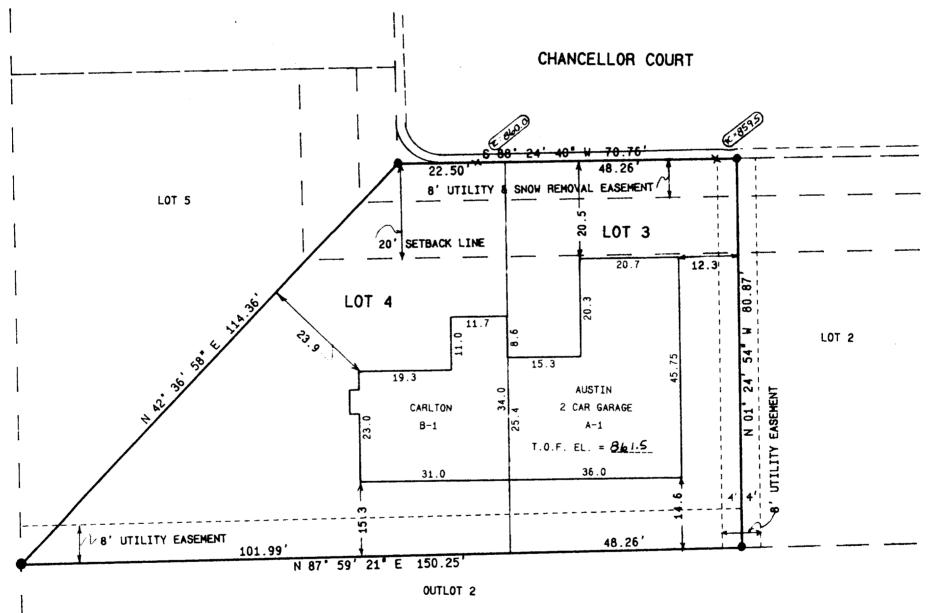

OWNER AND DEVELOPER: JOHN C. TRACY & ASSOCIATES, AN ILLINOIS CORPORATION 509 W. OLD N.W. HIGHWAY BARRINGTON, ILLINOIS 60010

●= FOUND IRON REBAR STAKE = SET IRON REBAR STAKE SET WOOD HUB STAKE

FOUND IRON PIPE STAKE

100

**JUL** 2 5 1995

10 70 ORIGINAL 1" = 20 MAP SCALE IN FEET

PETER S.

**GORDON** S-2101 ELKHORN.

SUR'

☆

NOTE: COPIES OF THIS MAP TO WHICH THE FOLLOWING CERTIFICATE WILL APPLY ARE BLUE LINE PRINTS SHOWING SURVEYOR'S ORIGINAL SEAL AND SIGNATURE IN BLACK INK. COPIES BY ANY OTHER MEANS MAY HAVE ALTERATIONS WHICH DO NOT REPRESENT THE SURVEYOR'S WORK PRODUCT.

I HEREBY CERTIFY THAT THE ABOVE DESCRIBED PROPERTY HAS BEEN SURVEYED UNDER MY DIRECTION AND THAT THE ABOVE MAP IS A TRUE REPRESENTATION THEREOF AND SHOWS THE SIZE AND LOCATION OF THE PROPERTY AND ITS EXTERIOR BOUNDARIES. THIS SURVEY IS MADE FOR THE USE OF THE PRESENT OWNERS OF THE PROPERTY, AND ALSO THOSE WHO PURCHASE, MORTGAGE, OR GUARANTEE THE TITLE THERETO WITHIN ONE YEAR FROM THE DATE HEREOF.

DATED: 6-1-95

PETER S. GORDON R.L.S. 2101

ROJ 3828 SHEET 1 OF 1 006-356