


DUNHAM SURVEYING, S.C.
SURVEYING & SUBDIVIDING
DELAVER, WISCONSIN 53115

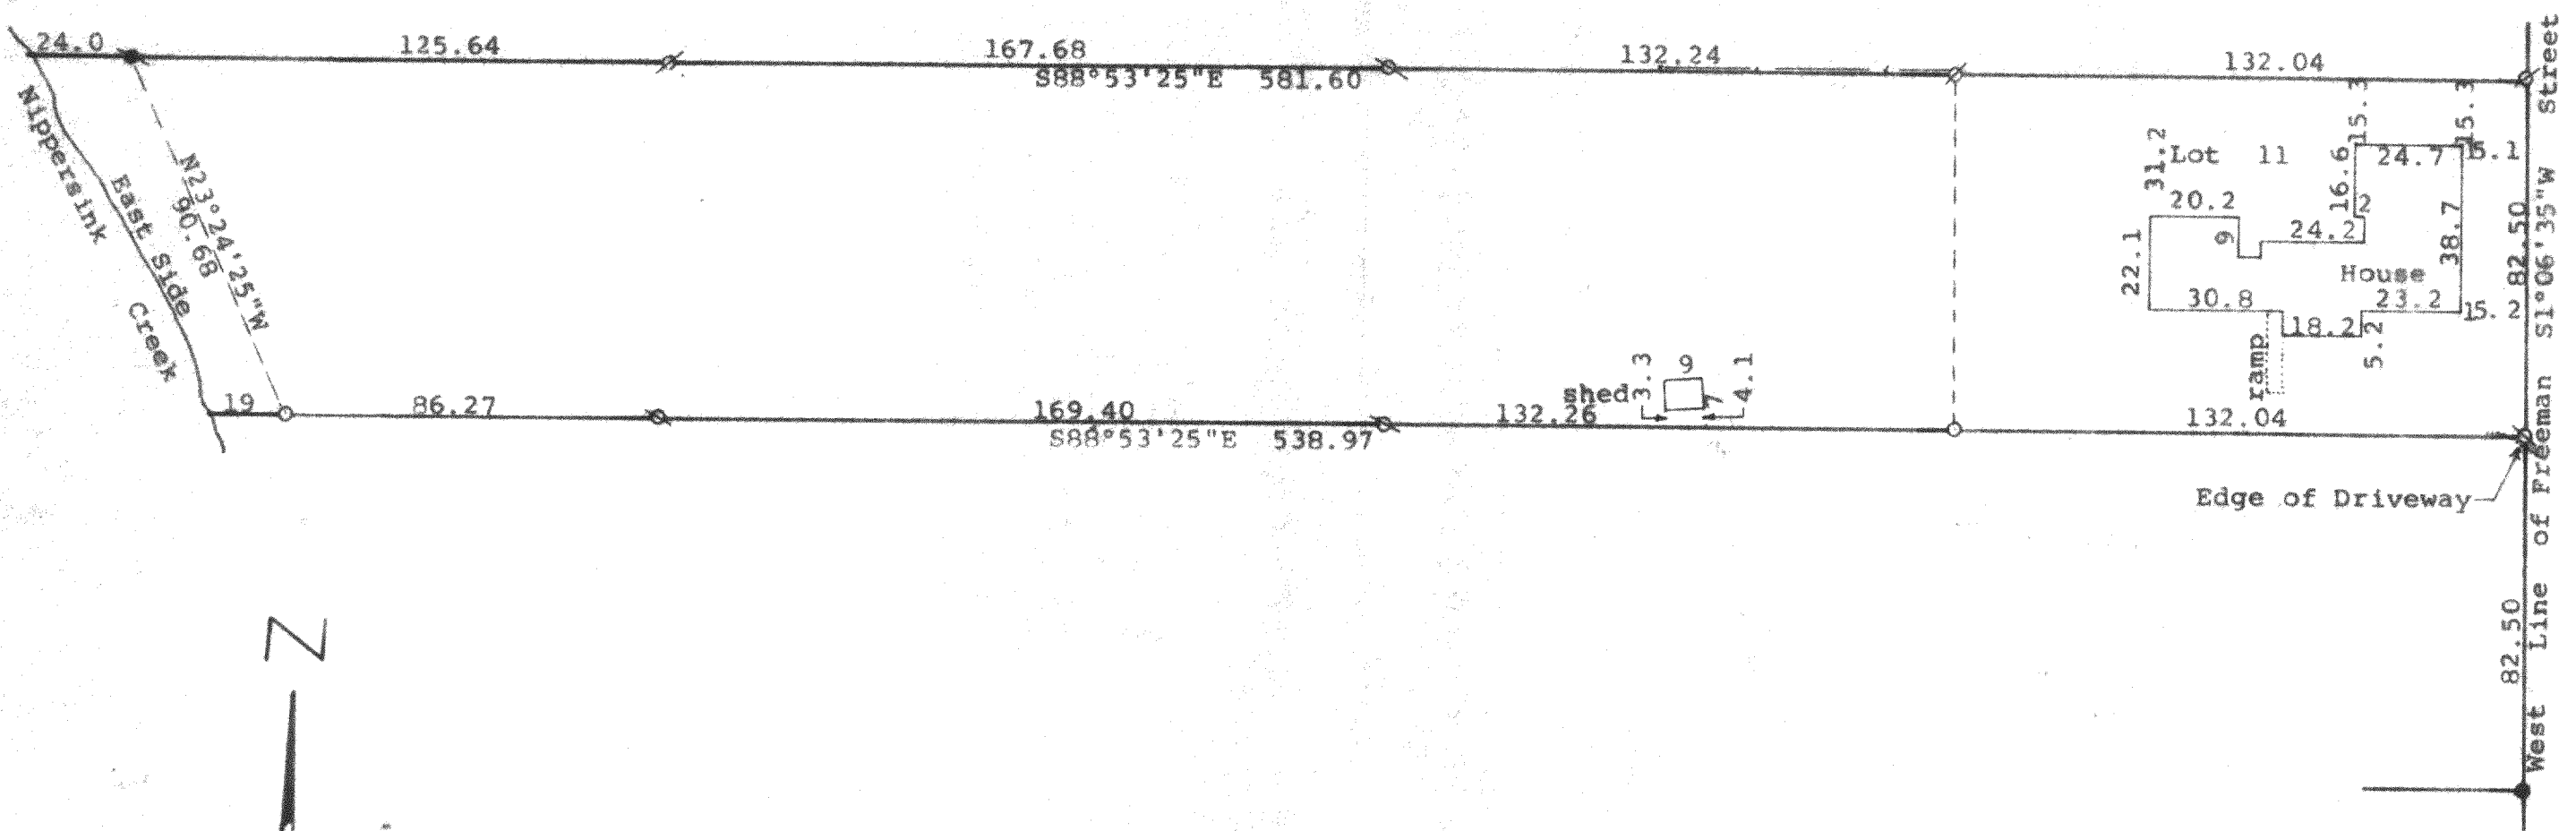

Scale - 1" = 40'
● = 1/2" Iron Rod in Concrete Found
○ = 1" Iron Pipe Found
○ = 1/2" Iron Pipe Set
○ = 1" Iron Pipe Set
○ = 1 1/4" Iron Pipe Set

Bearings referenced to the west line of Freeman Street with the previously assumed bearing of S1°06'25"W

Survey ordered by: Lake Geneva Properties
816 Williams Street
Lake Geneva, WI 53147

--- = Fence Line

STATE OF WISCONSIN) SS
COUNTY OF WALWORTH)

I, George T. Dunham, Surveyor, certify that I have surveyed the property described as follows:

Lot 11 of Freemans Addition to the Village of Genoa Junction (Now Genoa City), Walworth County, Wisconsin. ALSO a parcel of land lying immediately west of and adjoining said Lot 11 in Freemans Addition between the north and south lines of said lot produced West in parallel lines to the Mill Pond. (No Mill pond at this time. Therefore the lines were extended to the east line of Nippersink Creek.)

and that the plat shown hereon is a correct representation thereof and shows the size and location of the property, its exterior boundaries, the location of all visible structures and dimensions of all principal buildings thereon, boundary fences, apparent easements, roadways and visible encroachments, if any, and that I have surveyed the property hereon described, according to the official records, to the best of my knowledge and belief.

Surveyed July 25, 1994
Plat drawn March 30, 1995

George T. Dunham
George T. Dunham, Surveyor

