


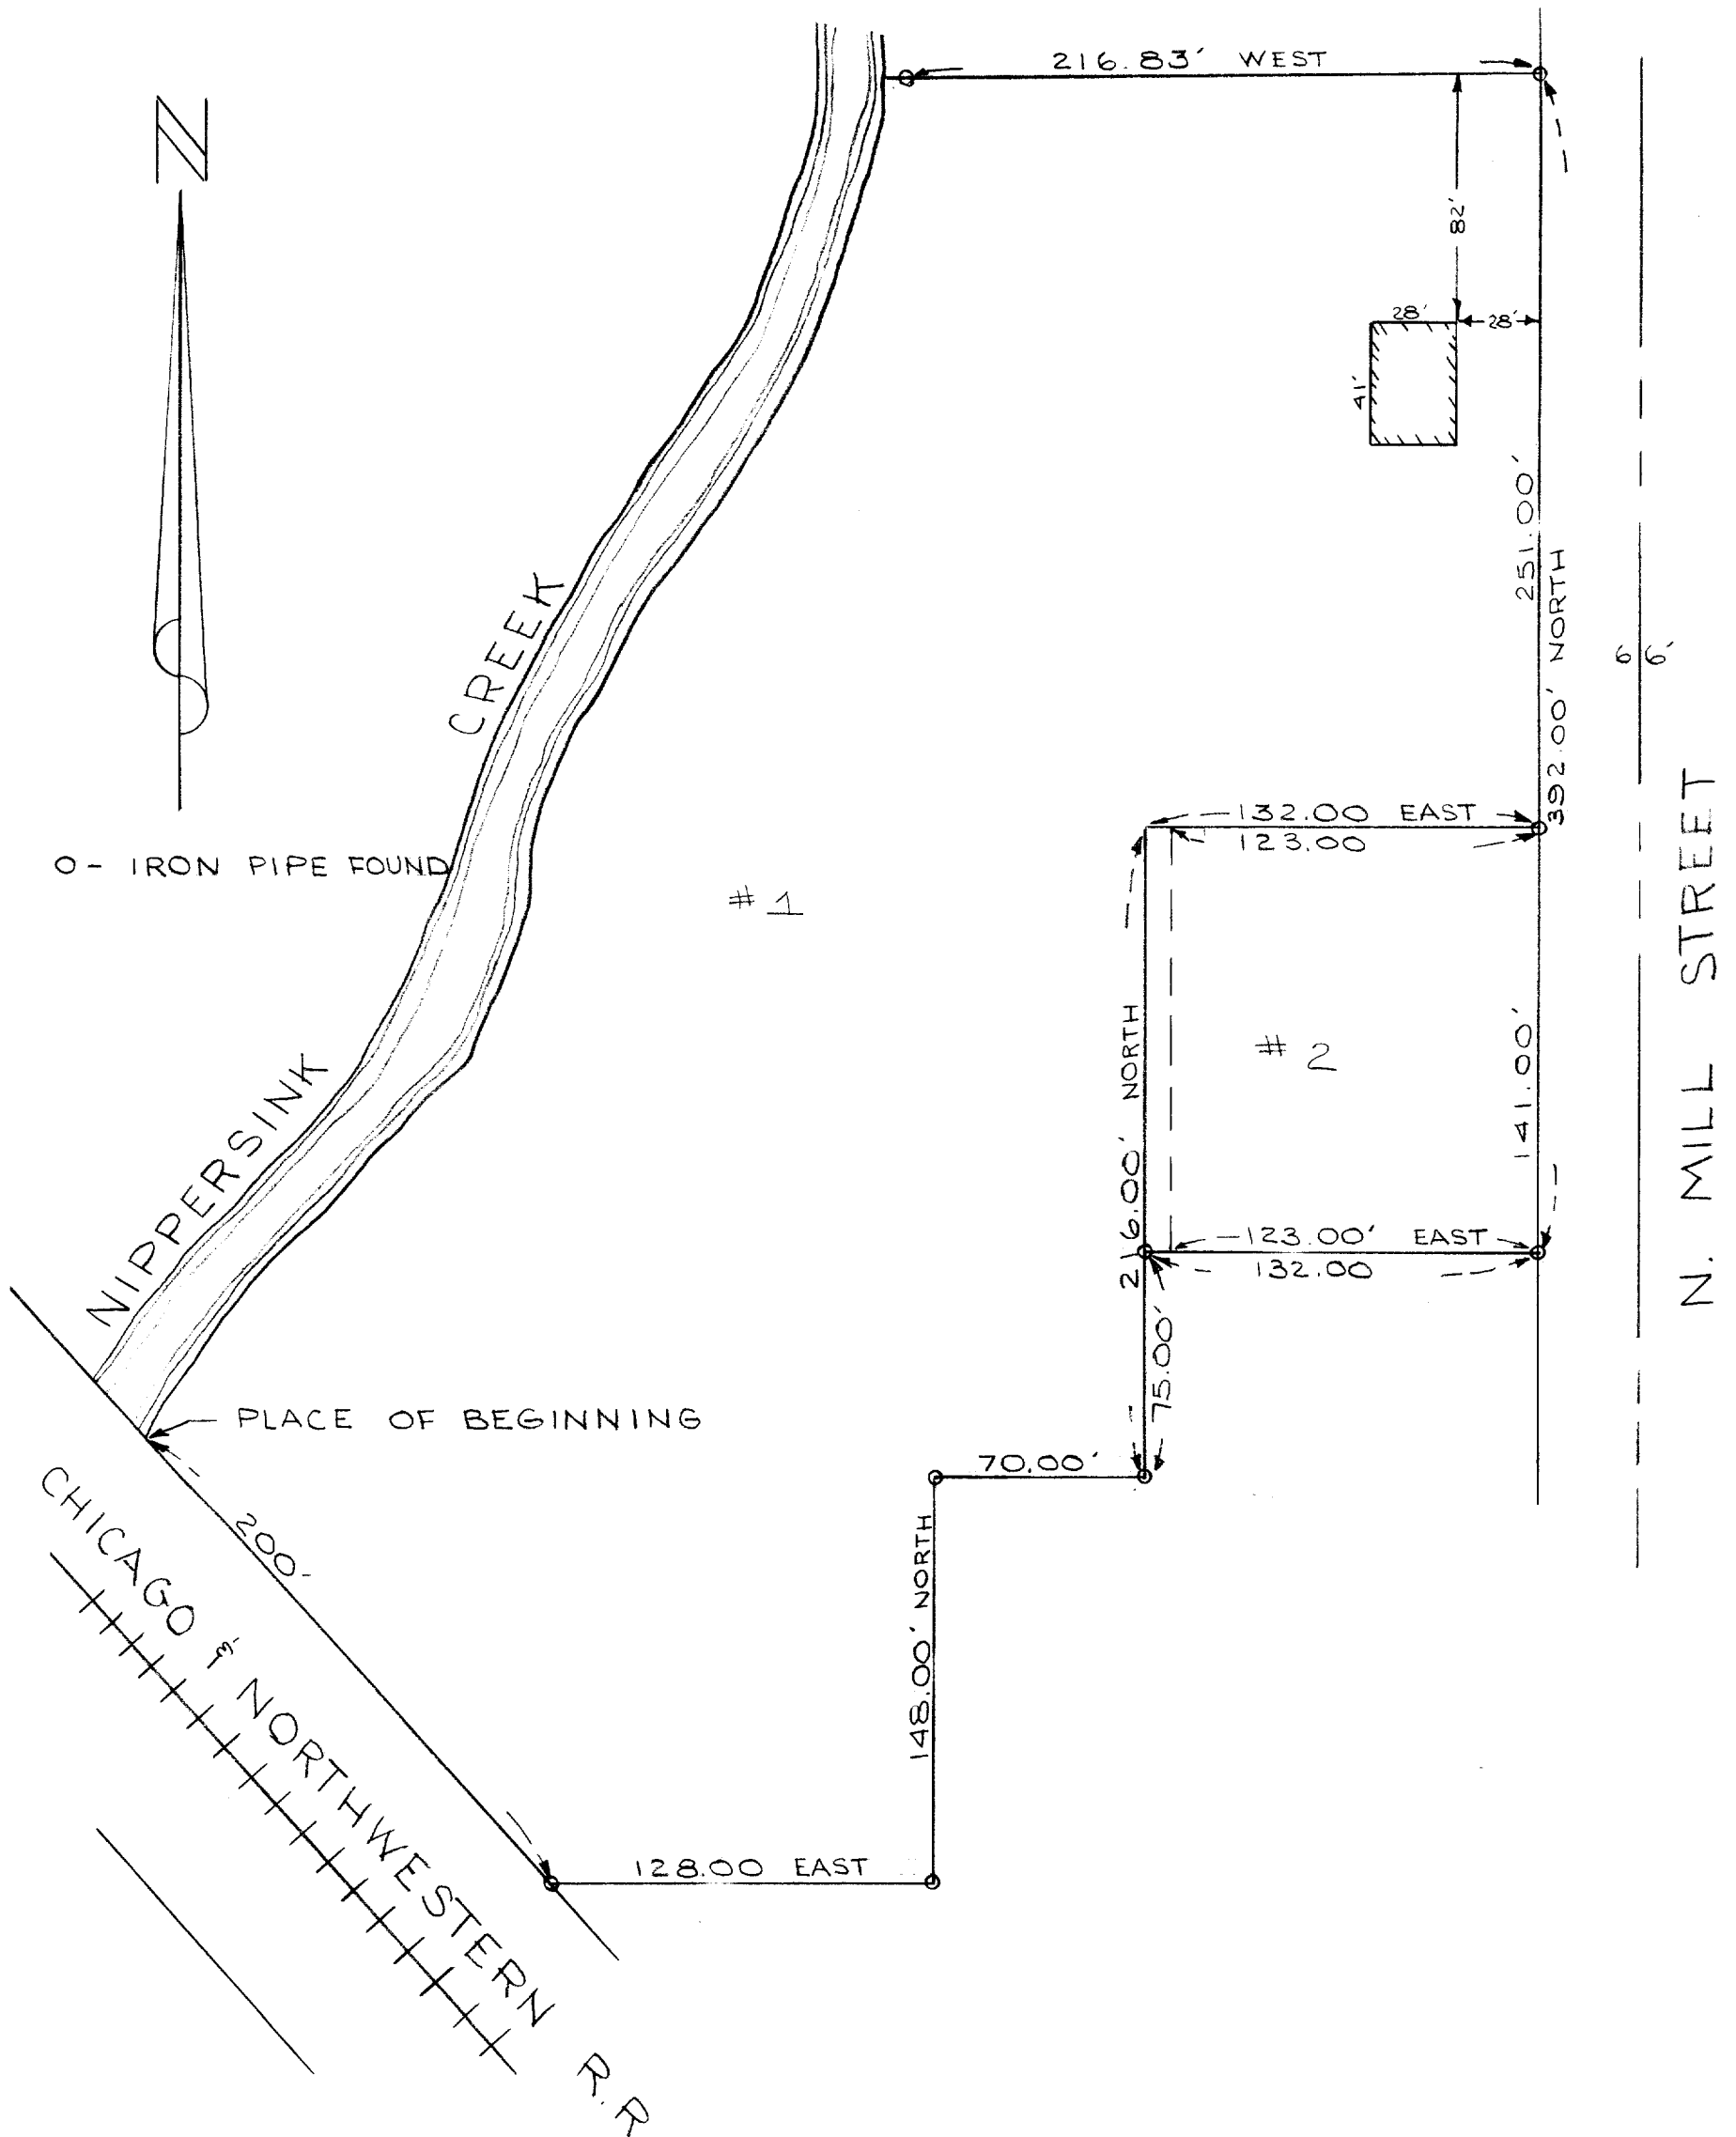

DESCRIPTION PARCEL #1 Beginning at a point where the North edge of the Chicago and Northwestern Railroad right of way intersects the East edge of Nippersink Creek in the Village of Genoa City Walworth County, Wisconsin , also the point of beginning of the lands hereinafter described, to wit; thence southeasterly along the North edge of said Right of Way 200 feet more or less to an iron pipe, thence East 128 feet to an iron pipe, thence north 148 feet more or less to a point, thence East 70 feet to a point, thence North 216 feet to a point, thence East 132 feet to the West edge of North Mill Street, thence North 383 feet more or less to the South edge of Miller's Addition, thence West to the East edge of Nippersink Creek thence Southerly along the East edge of Nippersink Creek as meandering to the place of beginning., excepting therefrom the North 132 feet of the above described parcel, all in the village of Genoa City, Walworth County, Wisconsin.

DESCRIPTION PARCEL #2 Beginning at the N.E. corner of Lot 8, Block 5, of Giffords Addition to the Village of Genoa City, (formerly Genoa Junction) thence North along the highway 141 feet, thence West 123 feet, thence South 141 feet, thence East 123 feet to the place of beginning.

CERTIFICATE: I, James F. Biagi, surveyor, herby certify that I have surveyed the lands hereon described.

SEPTEMBER 30, 1970

James F. Biagi, Reg. No. 272



REVISIONS					
NO.	DATE	BY			
1					
2					
3			DRAWN BY	SCALE	MATERIAL
4			CHK'D	DATE	DRAWING NO.
5			TRACED	APP'D	