


GEORGE T. DUNHAM
SURVEYING & SUBDIVIDING
DELAVER, WISCONSIN



Scale - 1" = 20'
○ = Iron Pipe

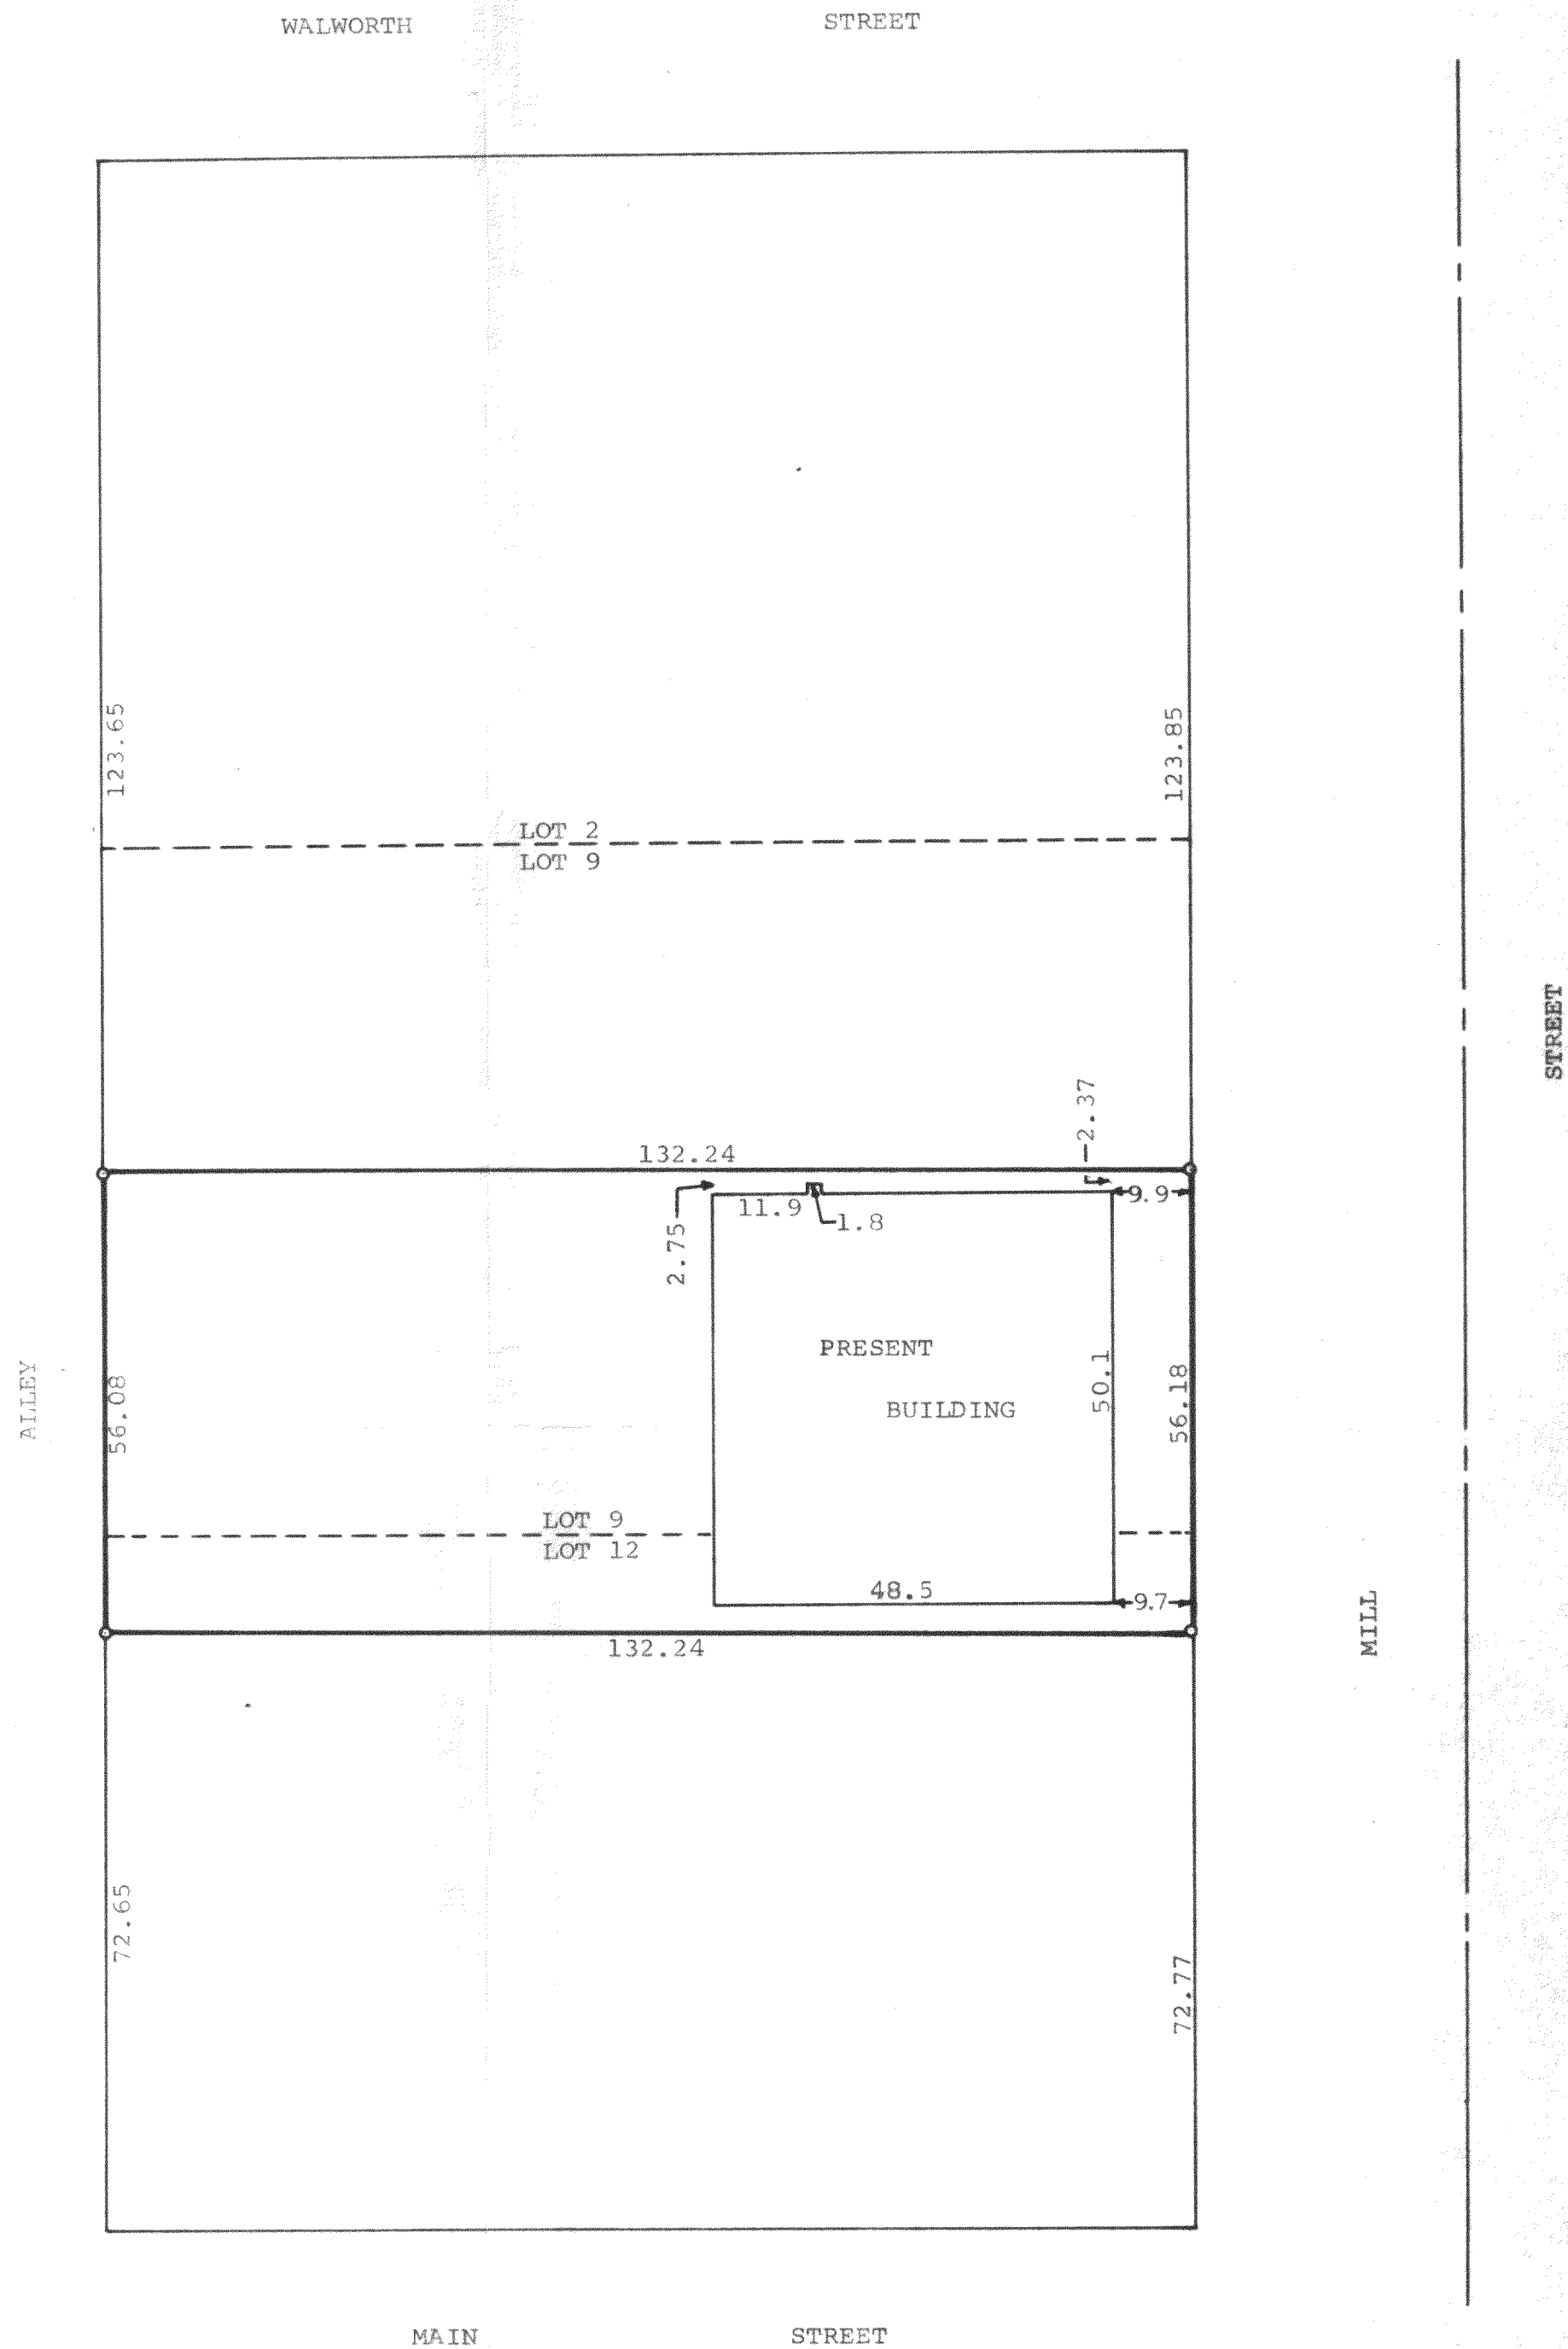

Plat of survey of a parcel of land located in Lots 9 and 12
of the Original Plat of the Village of Genoa City, Walworth
County, Wisconsin as surveyed on April 15, 1970.
January 4, 1972

George T. Dunham
George T. Dunham, Surveyor

