


975023  
975023S1.DWG

763-6737

534-5404


LOT 1, CERTIFIED SURVEY MAP NO. 759, RECORDED IN VOLUME 3, PAGE 281 IN THE OFFICE OF THE REGISTER OF DEEDS FOR WALWORTH COUNTY, WISCONSIN AND BEING PART OF THE NORTHEAST 1/4 OF SECTION 35, TOWN 1 NORTH, RANGE 18 EAST, OF THE 4TH PRINCIPAL MERIDIAN, VILLAGE OF GENOA CITY, WALWORTH COUNTY, WISCONSIN.

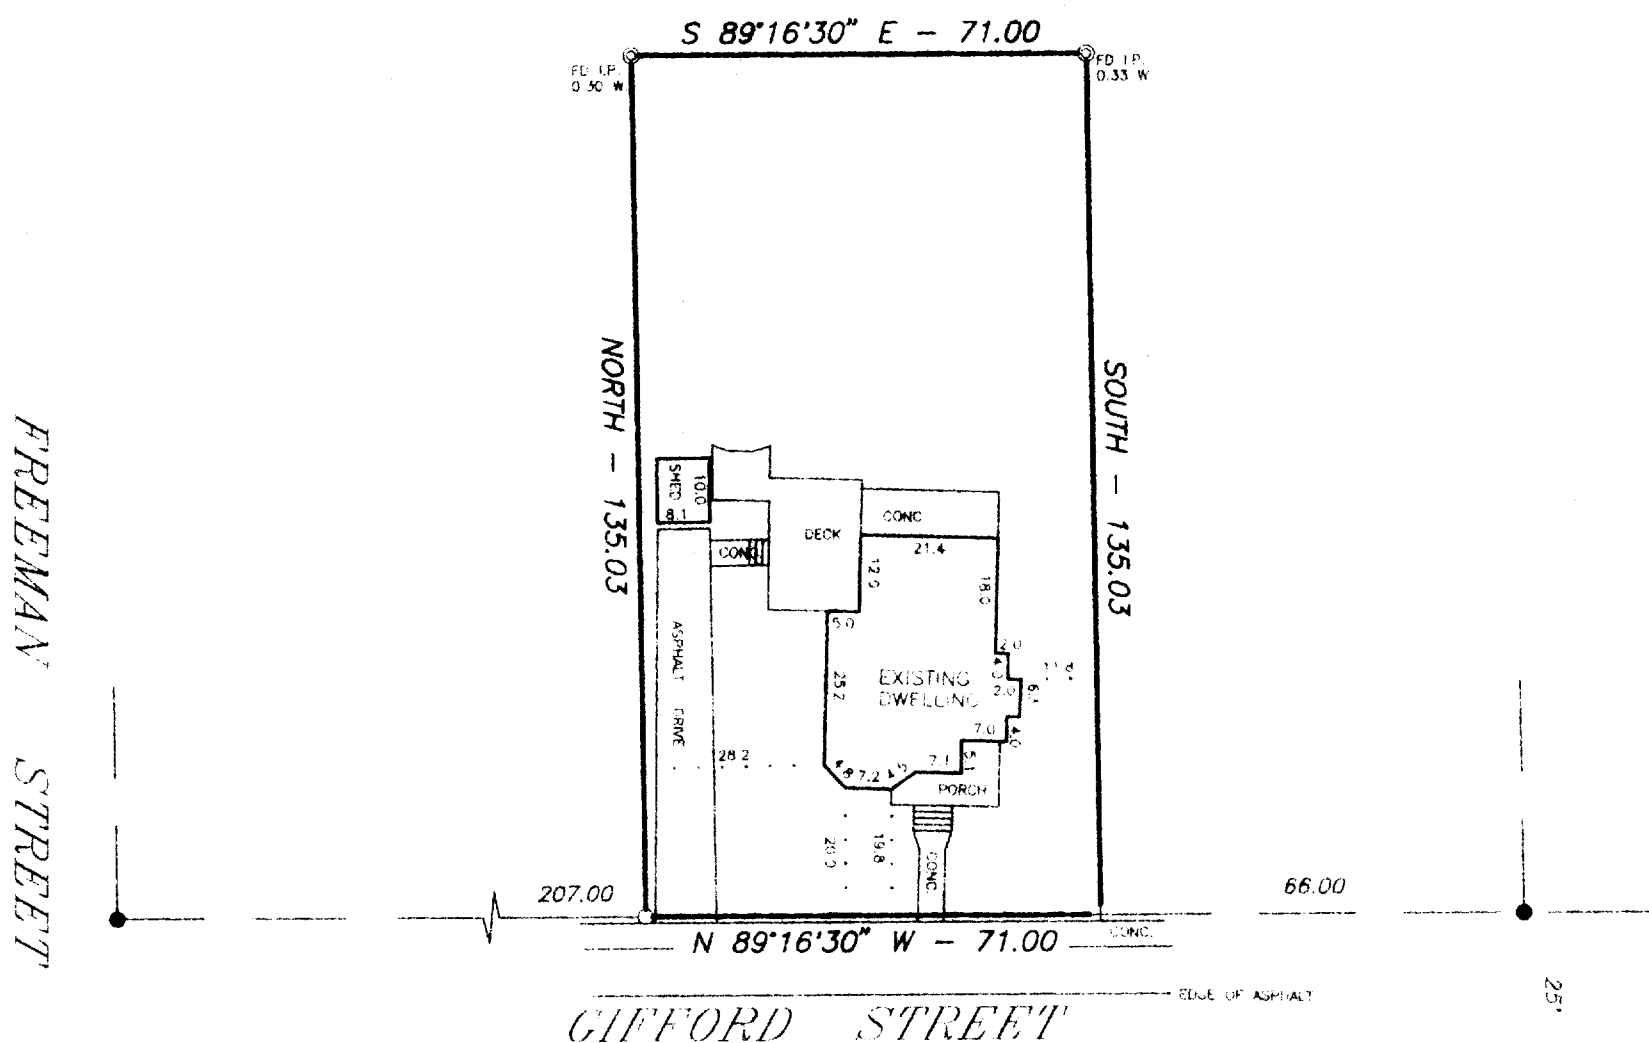

SURVEYED FOR: MARY PEPPER  
CENTURY 21 - ZENK REALTY  
100 ELIZABETH AVE  
GENOA, W. 05148

+ -- FOUND SPIKE IN TIMBER  
 x -- EX NAIL  
 @ -- FOUND 1" IRON PIPE  
 ● -- FOUND 3/4" IRON PIPE  
 ○ -- SET 3/4" IRON PIPE  
 ( ) -- RECORDED AS

SCALE 1" = 30'

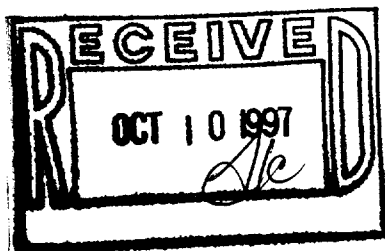

I HEREBY CERTIFY THAT I HAVE SURVEYED THE ABOVE DESCRIBED PROPERTY AND THE ABOVE MAP IS A TRUE REPRESENTATION THEREOF AND SHOWS THE SIZE AND LOCATION OF THE PROPERTY, THE LOCATION OF ALL VISIBLE STRUCTURES AND DIMENSIONS OF ALL PRINCIPAL BUILDINGS THEREON, BOUNDARY LINES, APPARENT EASEMENTS, ROADWAY AND VISIBLE ENCROACHMENTS, IF ANY.

THIS SURVEY IS MADE FOR THE PRESENT OWNERS OF THE PROPERTY AND ALSO THOSE WHO PURCHASE, OR GUARANTEE THE TITLE HERETO WITHIN 10 YEARS FROM THE DATE HEREOF

WATERFORD 345 19TH DAY OF SEPTEMBER 19 97

## REFERENCES

MS. 13111 DAY OF ... 19...

*Gary B. Foat*

975023

TA-759-1  
006-492