

DEGEN, FOAT SURVEYING ASSOCIATES

100 SOUTH SECOND STREET

WATERFORD, WISCONSIN

(414)534-5404

(FAX)534-2022


982096

982096S1.DWG

PLAT OF SURVEY

LOT 2, CERTIFIED SURVEY MAP NO. 1632, RECORDED IN VOLUME 7 OF CERTIFIED SURVEY MAPS ON PAGE 320 IN WALWORTH COUNTY REGISTER OF DEEDS AS DOCUMENT #154108, BEING PART OF THE NORTHWEST 1/4 OF THE SOUTHEAST 1/4 OF SECTION 35, TOWN 1 NORTH, RANGE 18 EAST, VILLAGE OF GENOA CITY, WALWORTH COUNTY, WISCONSIN.

SURVEY ORDERED BY: DEBBIE MCNICHOLS-SARNA
CENTURY 21-ZENK REALTY
100 ELIZABETH LANE
GENOA CITY, WI 53128

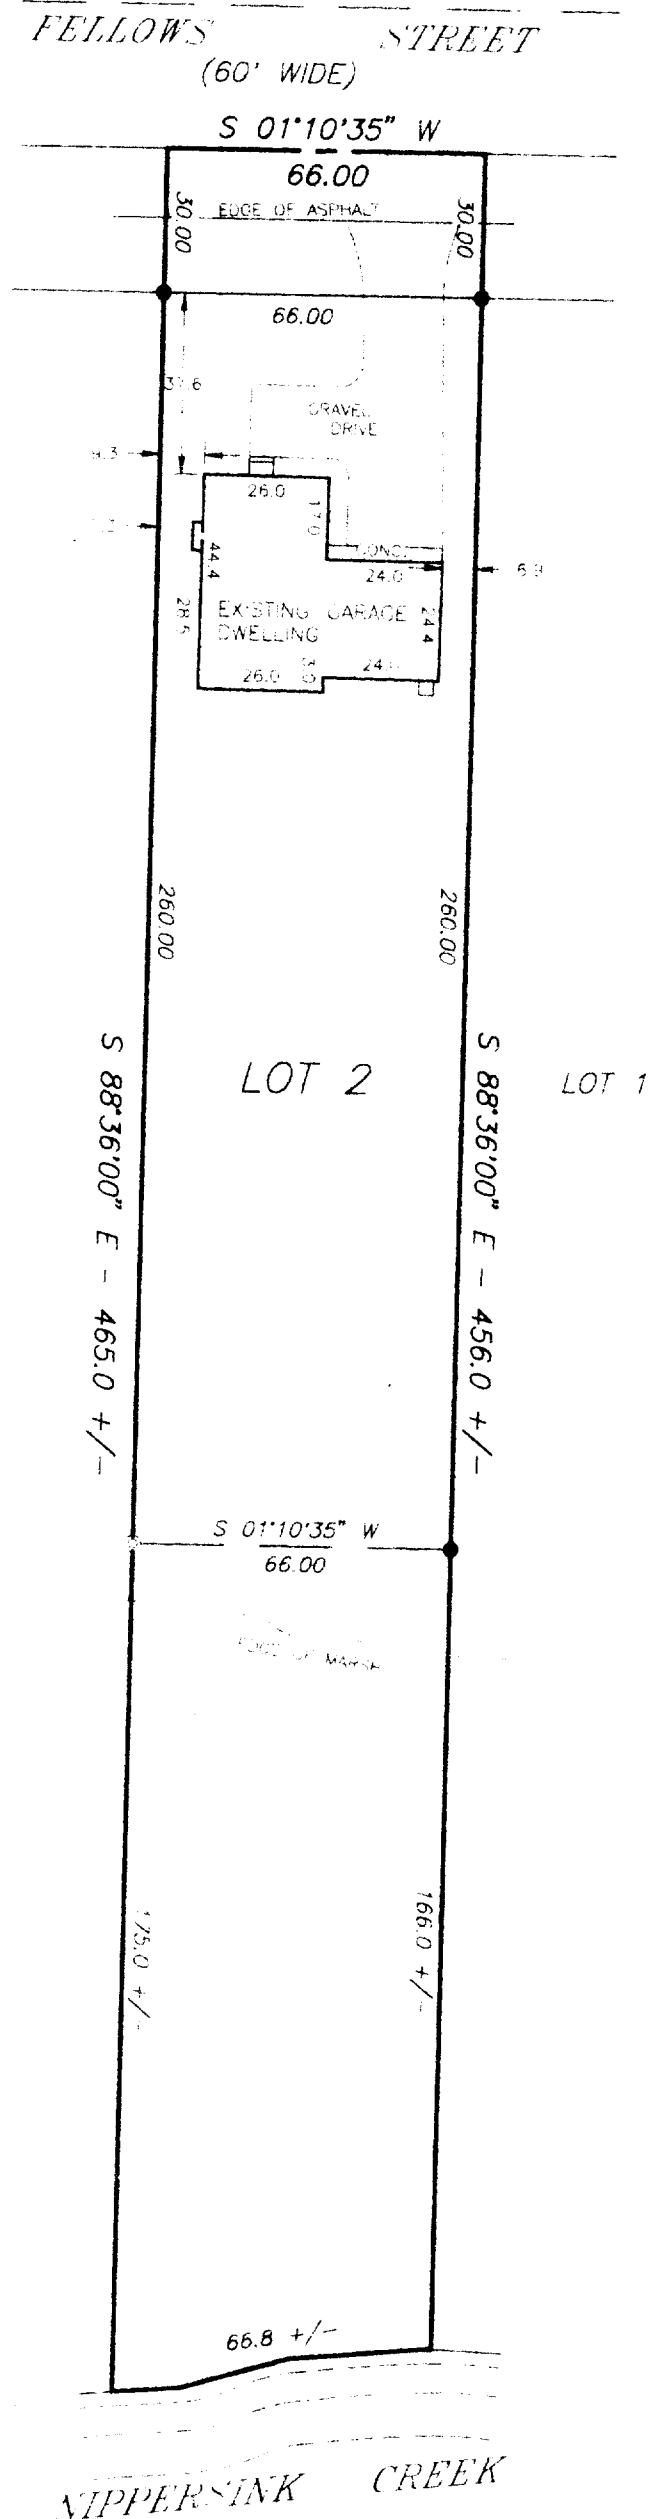

SCALE: 1" = 40'

LEGEND

- ⊙ - FOUND IRON PIPE
- - FOUND IRON ROD
- - SET IRON PIPE
- - FENCE
- - RECORDED AS



I HEREBY CERTIFY THAT I HAVE SURVEYED THE ABOVE DESCRIBED PROPERTY AND THE ABOVE MAP IS A TRUE REPRESENTATION THEREOF AND SHOWS THE SIZE AND LOCATION OF THE PROPERTY, THE LOCATION OF ALL VISIBLE STRUCTURES AND DIMENSIONS OF ALL PRINCIPAL BUILDINGS THEREON, BOUNDARY FENCES, APPARENT EASEMENTS, ROADWAY AND VISIBLE ENCROACHMENTS, IF ANY.

THIS SURVEY WAS MADE FOR THE PRESENT OWNERS OF THE PROPERTY, AND ALSO THOSE WHO PURCHASE OR GUARANTEE THE TITLE THEREON WITHIN ONE YEAR FROM THE DATE HEREOF.

DATED AT WATERFORD WIS. 11TH DAY OF MARCH 1998

RECORDED

[Signature]

0006-520

TA-1632-2