



PLAT OF SURVEY

PATHFINDER SURVEYING
FORMERLY KOLB LAND CONSULTING
929 WILLIAMS STREET LAKE GENEVA, WI. 53147
(414) 870-1894

ORDERED BY:

BRADEN & OLSON
716 WISCONSIN STREET
LAKE GENEVA WI 53147
FOR: CHRISTINE TOMAS

DATE: APRIL 7, 1998

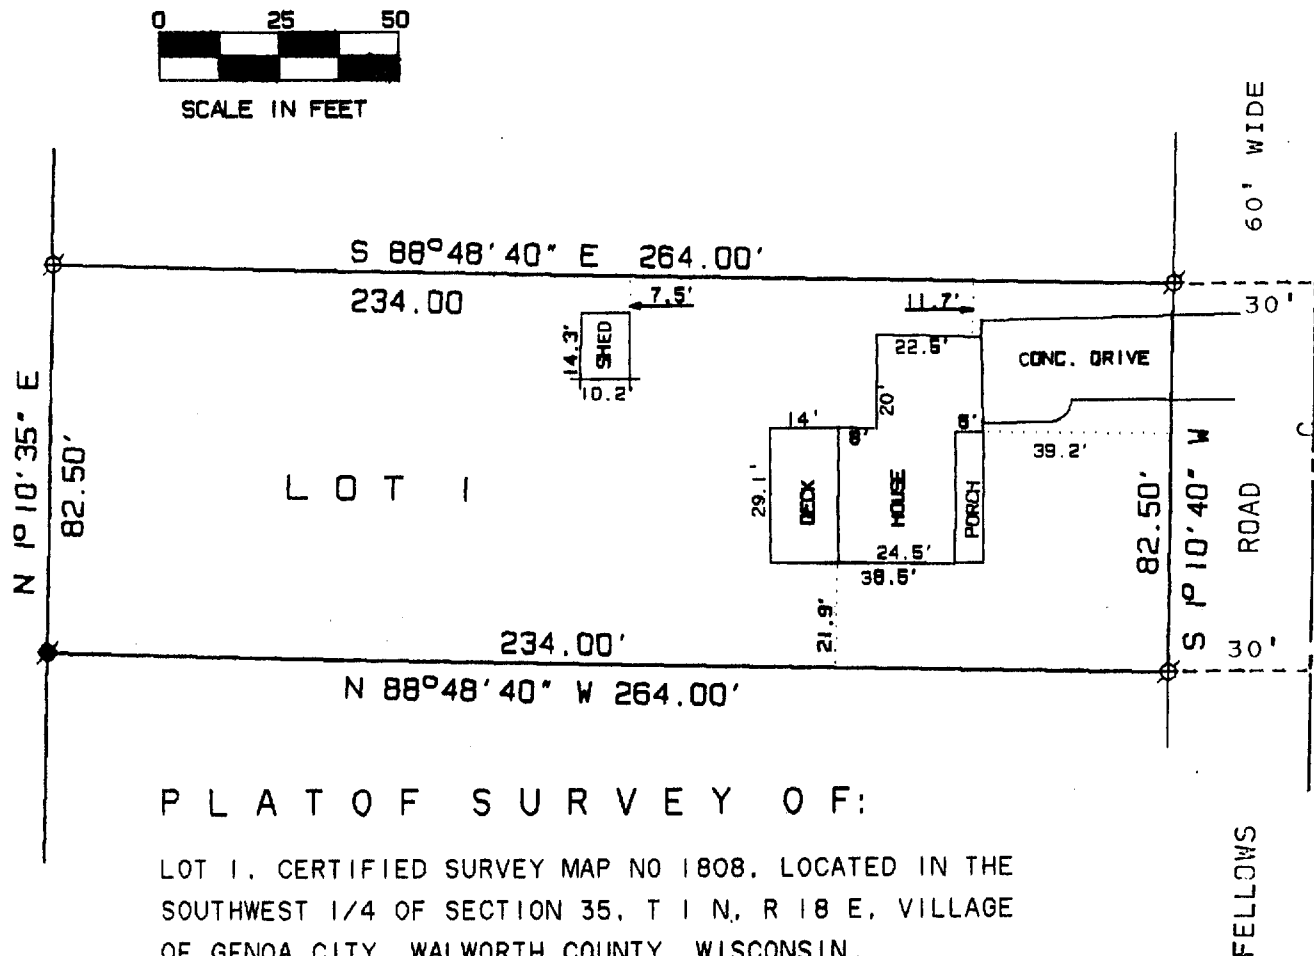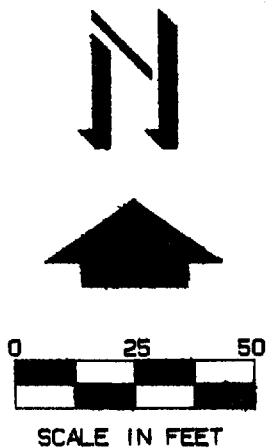

PLAT OF SURVEY OF:



LOT 1, CERTIFIED SURVEY MAP NO 1808, LOCATED IN THE
SOUTHWEST 1/4 OF SECTION 35, T 1 N, R 18 E, VILLAGE
OF GENOA CITY, WALWORTH COUNTY, WISCONSIN.

LEGEND

- IRON PIPE FOUND
- IRON ROD FOUND

THE ABOVE MAP IS A TRUE REPRESENTATION THEREOF AND
SHOWS THE SIZE AND LOCATION OF ALL THE PROPERTY,
EXTERIOR BOUNDARIES, THE LOCATION OF ALL VISIBLE
BOUNDARY FENCES, APPARENT EASEMENTS, ROADWAYS
AND VISIBLE ENCROACHMENTS, IF ANY

THIS SURVEY IS MADE FOR THE USE OF THE PRESENT
OWNERS OF THE PROPERTY, AND ALSO THOSE WHO
PURCHASE, MORTGAGE OR GUARANTEE TITLE THERETO
WITHIN ONE (1) YEAR FROM DATE HERETO.

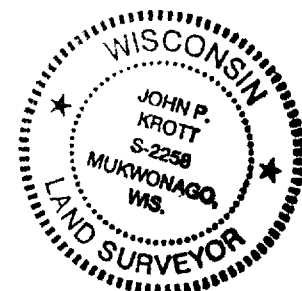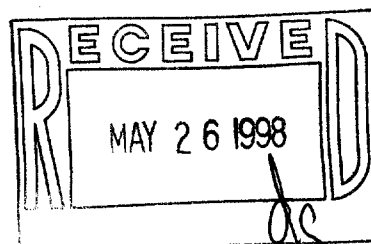

John P. Krott
JOHN P. KROTT, R.L.S. 2258

NOTE: THIS IS NOT A CERTIFIED COPY
UNLESS SEAL IS IN RED.

JOB NUMBER 98045

1-18/TA 1808-1

TA-1808-1
006-527