

PLAT OF SURVEY
OF

LOT 16, MILLER'S ADDITION TO VILLAGE OF GENOA CITY, WALWORTH COUNTY, WISCONSIN.

I HEREBY CERTIFY THAT I HAVE SURVEYED THE LAND DESCRIBED ABOVE AND THAT THE PLAT DRAWN HEREON IS A CORRECT REPRESENTATION OF SAID SURVEY. I FURTHER CERTIFY THAT THE BUILDINGS ON SAID LAND ARE LOCATED AS SHOWN ON THIS PLAT.



FOR: EVELYN KRUMSEE, SELLER
JOHN HODGES, BUYER
AUDREY BUEHN, REALTOR

John F. Degen 4-3-75
JOHN F. DEGEN, LAND SURVEYOR #242
589 N. PINE ST., BURLINGTON, WISCONSIN.

SCALE 1" = 30'

○ = IRON PIPE STAKE FOUND.

STREET ADDRESS: 928 FREEMAN ST.,
GENOA CITY, WIS.

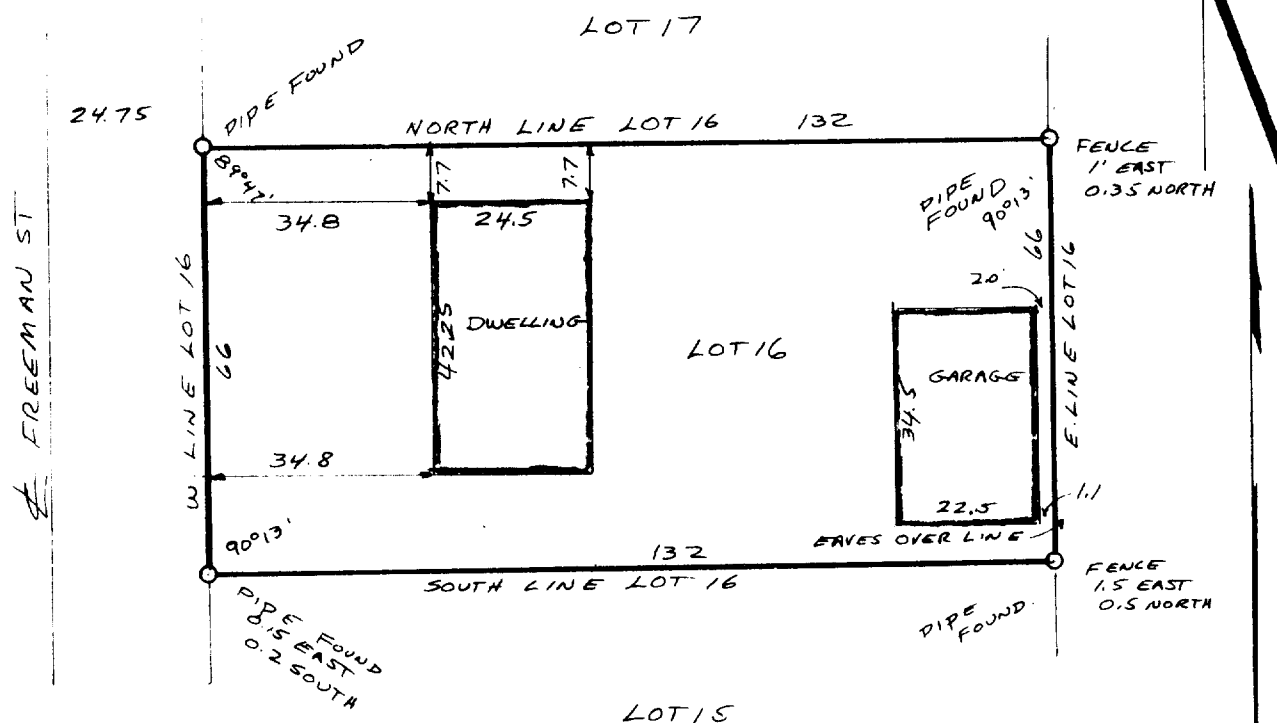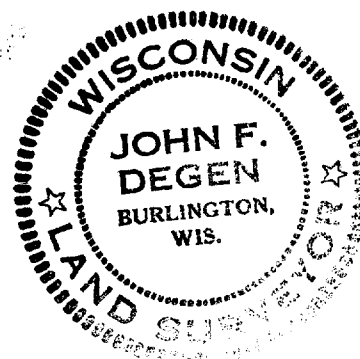

6-56