


PLAT OF SURVEY
-OF-



THE NORTH 1/2 OF LOTS 7 AND 8 OF BLOCK 7, FREEMAN'S SECOND ADDITION
TO THE VILLAGE OF GENOA CITY, WALWORTH COUNTY, WISCONSIN

SURVEY FOR: CENTURY 21- ZENK
SURVEY ADDRESS: 312 SUMNER STREET

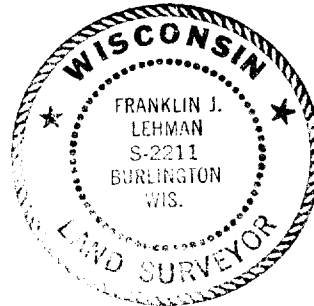

THIS IS NOT AN ORIGINAL PRINT
UNLESS THIS SEAL IS RED.

SUMNER ST.
(66' WIDE)

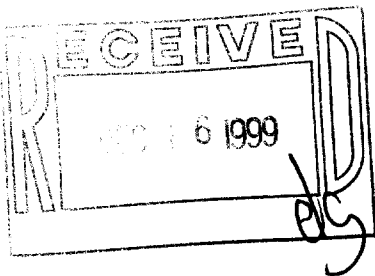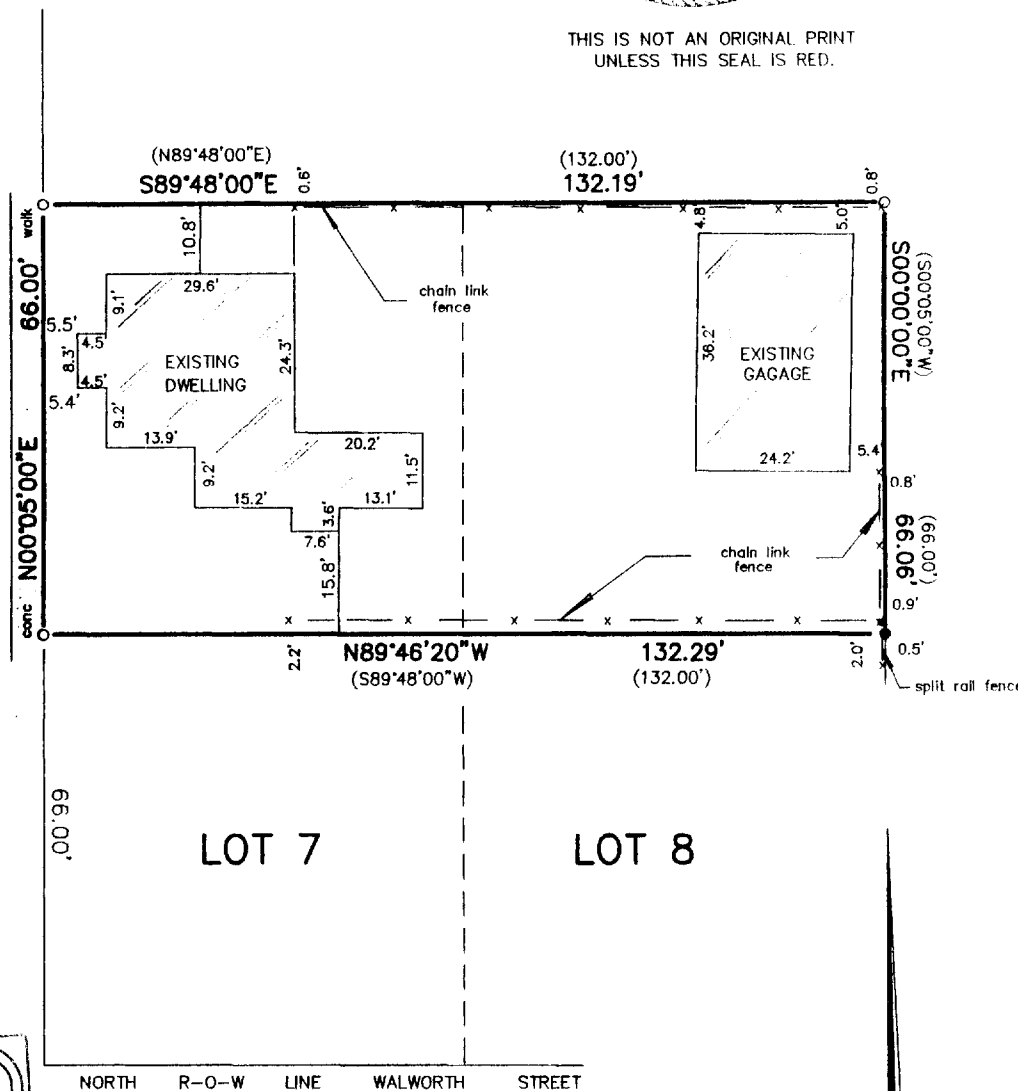


SCALE 1" = 30'

LEGEND

- FOUND IRON PIPE
- SET IRON PIPE

"I hereby certify that I have surveyed the above described property and that the above map is a correct representation thereof and shows the size and location of the property, its exterior boundaries, the location of all visible structures and dimensions of all principal buildings thereon, boundary fences, apparent easements, roadways and encroachments, if any."

"This survey is made for the use of the present owners of the property, and those who purchase, mortgage, or guarantee the title thereto within one year from date hereof."

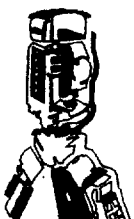

B.W. SURVEYING

412 N. PINE STREET
BURLINGTON, WI 53105
(414)-767-0225

Franklin J. Lehman
FRANKLIN J. LEHMAN S-2211

11-17-99
DATE

4251
JOB NUMBER

TFR2-32

006-691