



PLAT OF SURVEY

PATHFINDER SURVEYING
FORMERLY KOLB LAND CONSULTING
929 WILLIAMS STREET LAKE GENEVA, WI. 53147
(414) 248-3697

ORDERED BY: CENTURY 21 ZENK REALTY LLC
112 ELIZABETH LN
GENOA CITY, WI 53128

DATE: 11-8-1989

DESCRIPTION: THE NORTH 99.5 FEET OF THE FOLLOWING DESCRIBED PREMISES: BEGINNING AT THE S 1/4 CORNER OF SECTION 35, T1N, R18E OF THE 4TH P. M. TSP. OF BLOOMFIELD, COUNTY OF WALWORTH, STATE OF WISCONSIN, RUN THENCE NORTH ON THE NORTH AND SOUTH 1/4 SECTION LINE 500.00 FEET TO A POINT, SAID POINT MARKS THE PLACE OF BEGINNING OF THE PARCEL OF LAND HEREINAFTER DESCRIBED; RUN THENCE S 89°58' W 200.00 FEET TO A POINT; THENCE SOUTH 187.15 FEET TO A POINT; THENCE S 34°04' W 15.52 FEET TO A POINT, THENCE N 89°58' E 206.85 FEET TO A POINT, THENCE N 34°04' E 3.29 FEET TO A POINT, THENCE NORTH 197.26 FEET TO A POINT AND THE PLACE OF BEGINNING. SAID PARCEL OF LAND IS LOCATED IN THE SW 1/4 OF SECTION 35, T1N, R18E, VILLAGE OF GENOA CITY, COUNTY OF WALWORTH, STATE OF WISCONSIN.

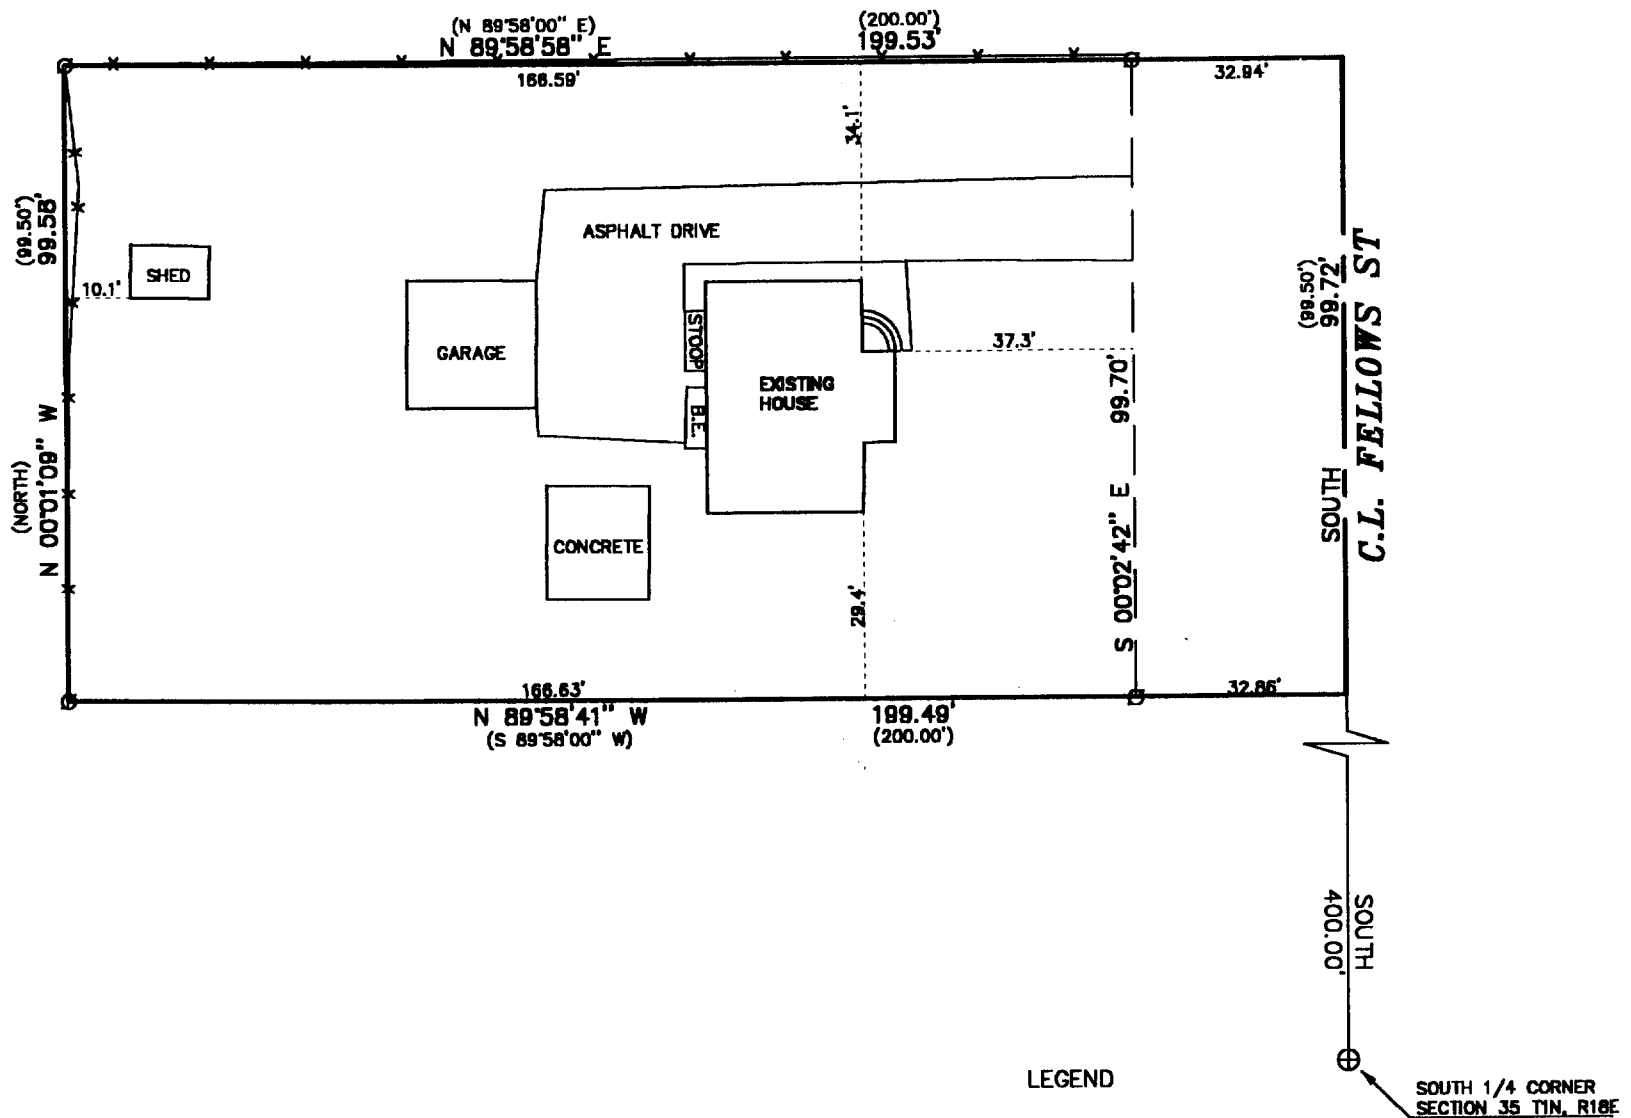
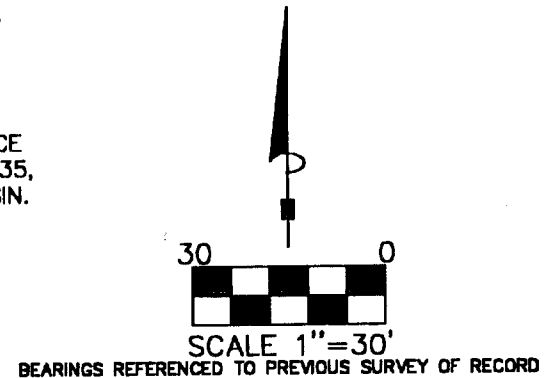


LEGEND
⊗ FOUND IRON PIPE
(XXXX) RECORDED AS
—X— FENCE

THE ABOVE MAP IS A TRUE REPRESENTATION THEREOF AND SHOWS THE SIZE AND LOCATION OF ALL THE PROPERTY, EXTERIOR BOUNDARIES, THE LOCATION OF ALL VISIBLE BOUNDARY FENCES, APPARENT EASEMENTS, ROADWAYS AND VISIBLE ENCROACHMENTS, IF ANY

THIS SURVEY IS MADE FOR THE USE OF THE PRESENT OWNERS OF THE PROPERTY, AND ALSO THOSE WHO PURCHASE, MORTGAGE OR GUARANTEE TITLE THERETO WITHIN ONE (1) YEAR FROM DATE HERETO.

John P. Krott
JOHN P. KROTT, R.L.S. 2258

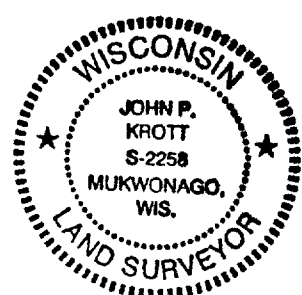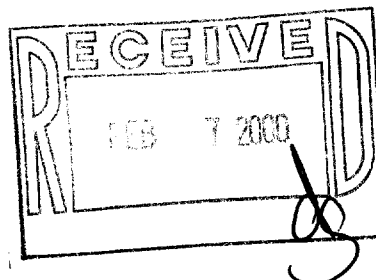

NOTE: THIS IS NOT A CERTIFIED COPY UNLESS SEAL IS IN RED.

JOB NUMBER #99268 TVGC 000 598

TVGC-598
086-703