


FARRIS, HANSEN, & ASSOCIATES, INC.
 ENGINEERING, ARCHITECTURE, SURVEYING
 7 RIDGWAY COURT — P.O. BOX 437, ELKHORN, WISCONSIN, 53121
 PHONE: (414) 723-2098 FAX: (414) 723-5886
PLAT OF SURVEY

LOT 128 OF HUNTERS RIDGE SUBDIVISION
 LOCATED IN ALL 1/4'S OF THE SW 1/4
 SECTION 25, TOWN 1 NORTH, RANGE 18 EAST,
 VILLAGE OF GENOA CITY, WALWORTH COUNTY, WISCONSIN

— WORK ORDERED BY —
 THE TRACY GROUP
 506 W. OLD N.W. HWY.
 BARRINGTON, IL. 60010

● = FOUND IRON REBAR STAKE
 (XXX.X) = PROPOSED TOP OF CURB ELEVATION

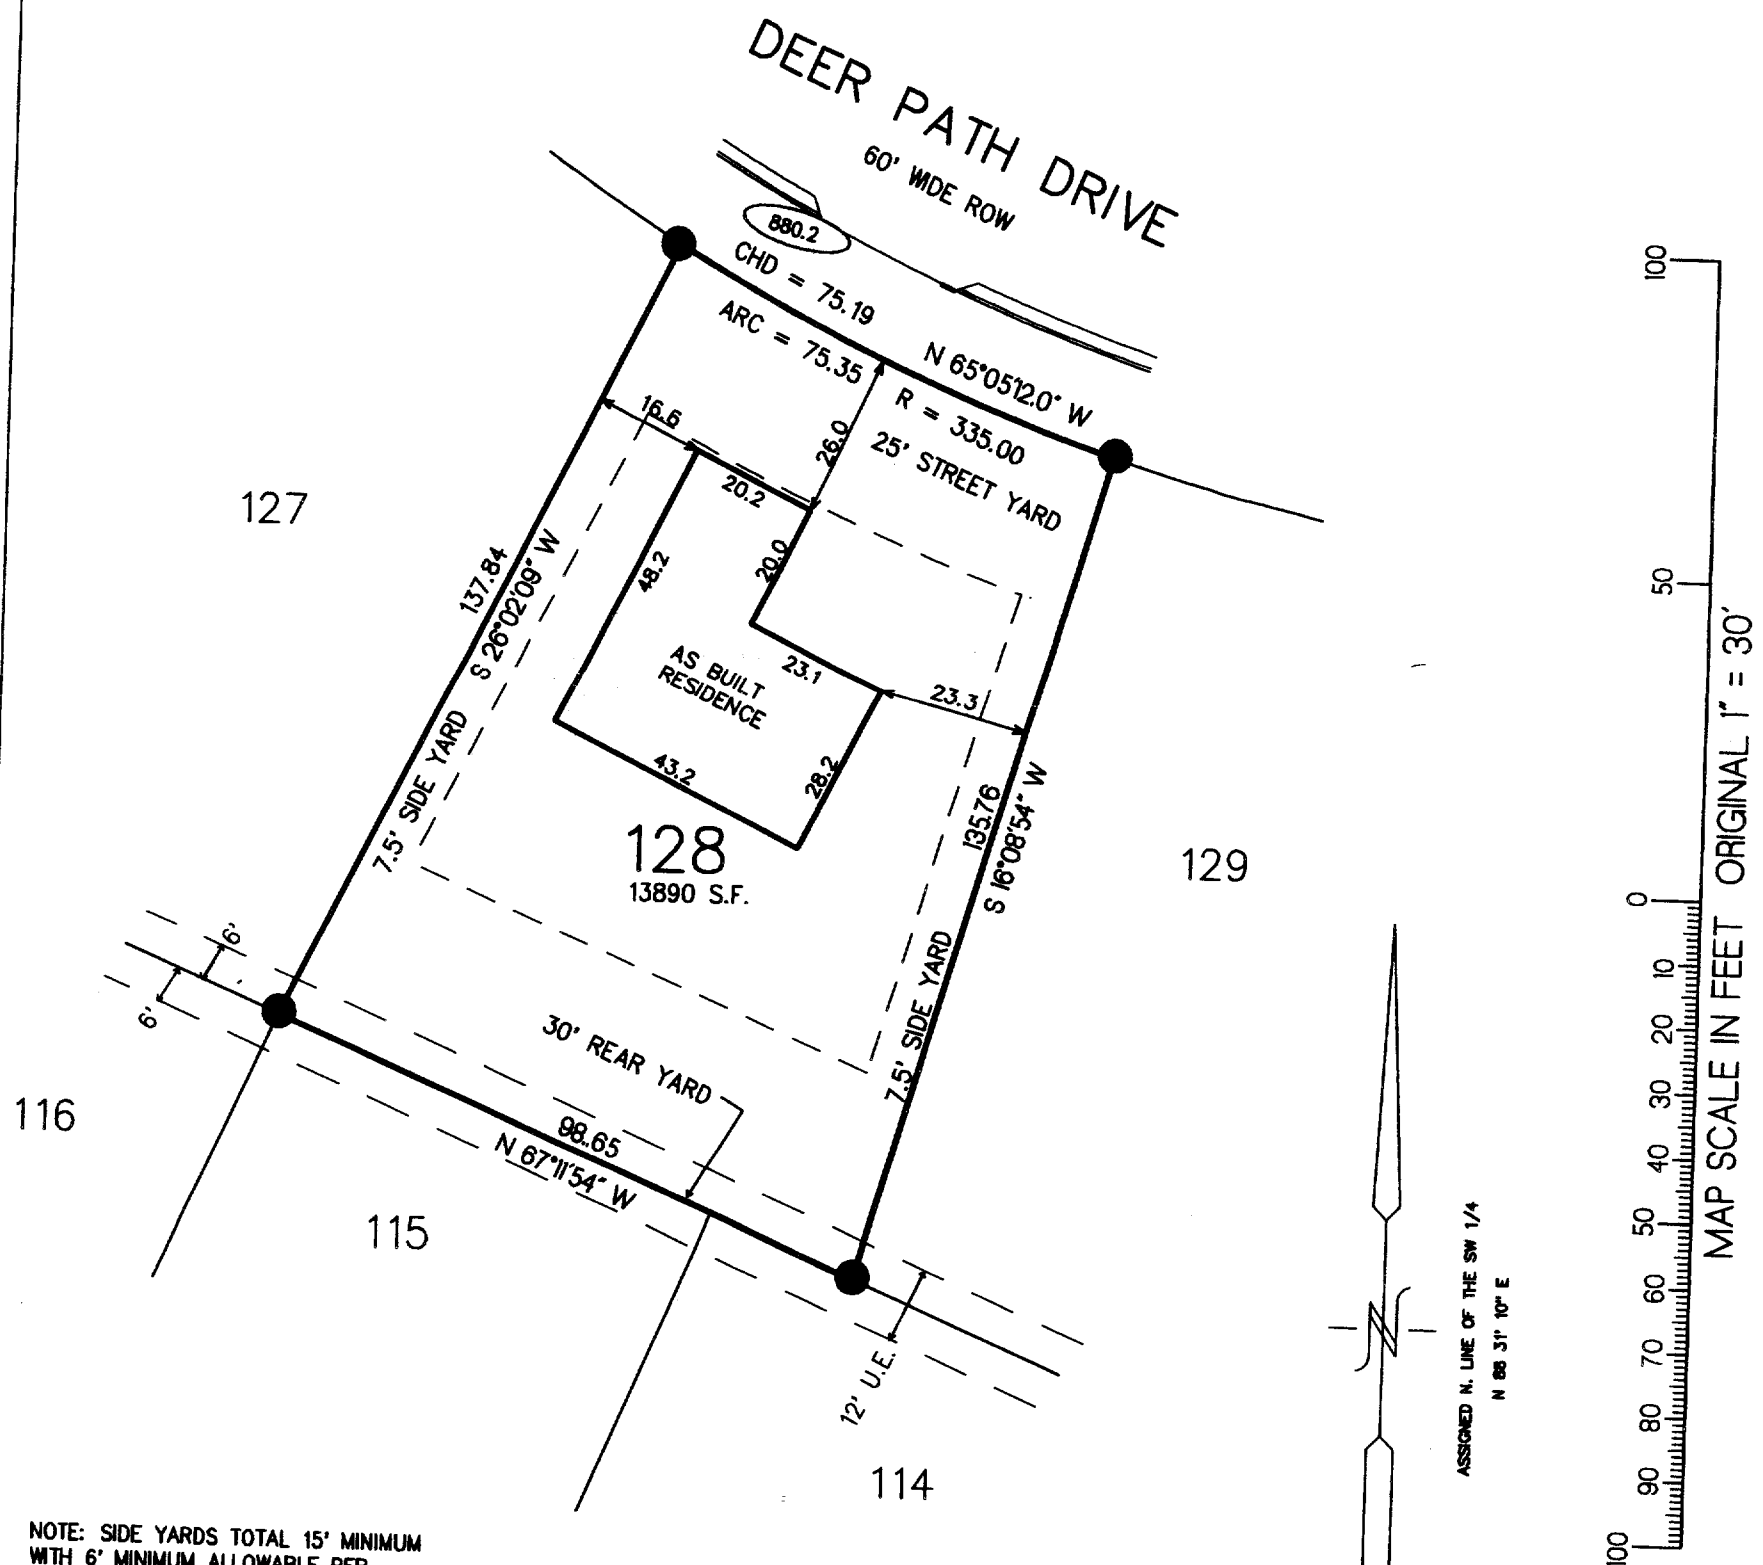


NOTE: SIDE YARDS TOTAL 15' MINIMUM
 WITH 6' MINIMUM ALLOWABLE PER
 VILLAGE ORDINANCE

NOTE: COPIES OF THIS MAP TO WHICH THE FOLLOWING CERTIFICATE WILL APPLY SHOW
 SURVEYOR'S ORIGINAL SEAL AND SIGNATURE IN RED INK. COPIES BY ANY OTHER MEANS MAY HAVE ALTERATIONS
 WHICH DO NOT REPRESENT THE SURVEYOR'S WORK PRODUCT.

I HEREBY CERTIFY THAT THE ABOVE DESCRIBED PROPERTY HAS BEEN SURVEYED UNDER MY DIRECTION AND THAT THE
 ABOVE MAP IS A TRUE REPRESENTATION THEREOF AND SHOWS THE SIZE AND LOCATION OF THE PROPERTY AND ITS
 EXTERIOR BOUNDARIES. THIS SURVEY IS MADE FOR THE USE OF THE PRESENT OWNERS OF THE PROPERTY, AND
 ALSO THOSE WHO PURCHASE, MORTGAGE, OR GUARANTEE THE TITLE THERETO WITHIN ONE YEAR FROM THE DATE
 HEREOF.

DATED: 4-16-2000

Peter S. Gordon
 PETER S. GORDON R.L.S. 2101

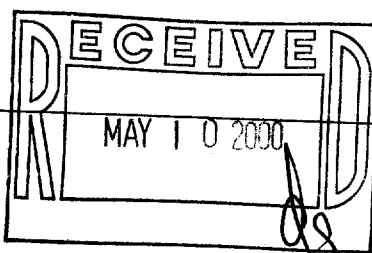

PROJECT 4267.128
 DATE: 02/17/2000
 SHEET 1 OF 1

THR-128
 006-723

APR 16 2000