

116 E. CHESTNUT STREET
BURLINGTON, WISCONSIN 53105
PHONE: 414-763-2652



ROBERS & BOYD, INC.
CONSULTING ENGINEERS
LAND SURVEYORS

809 - 43RD STREET
KENOSHA, WISCONSIN 53140
PHONE: 414-658-4488

PLAT OF SURVEY
FOR
BURLINGTON CONSUMERS COOPERATIVE

The North 270 feet of that part of the Southeast quarter of Section 35, which lies East of the Chicago, Northwestern Railroad right-of-way, all in Section 35, T1N., R18E., of Walworth County, Wisconsin.

Above described land is located in Genoa City, Walworth County, Wisconsin.

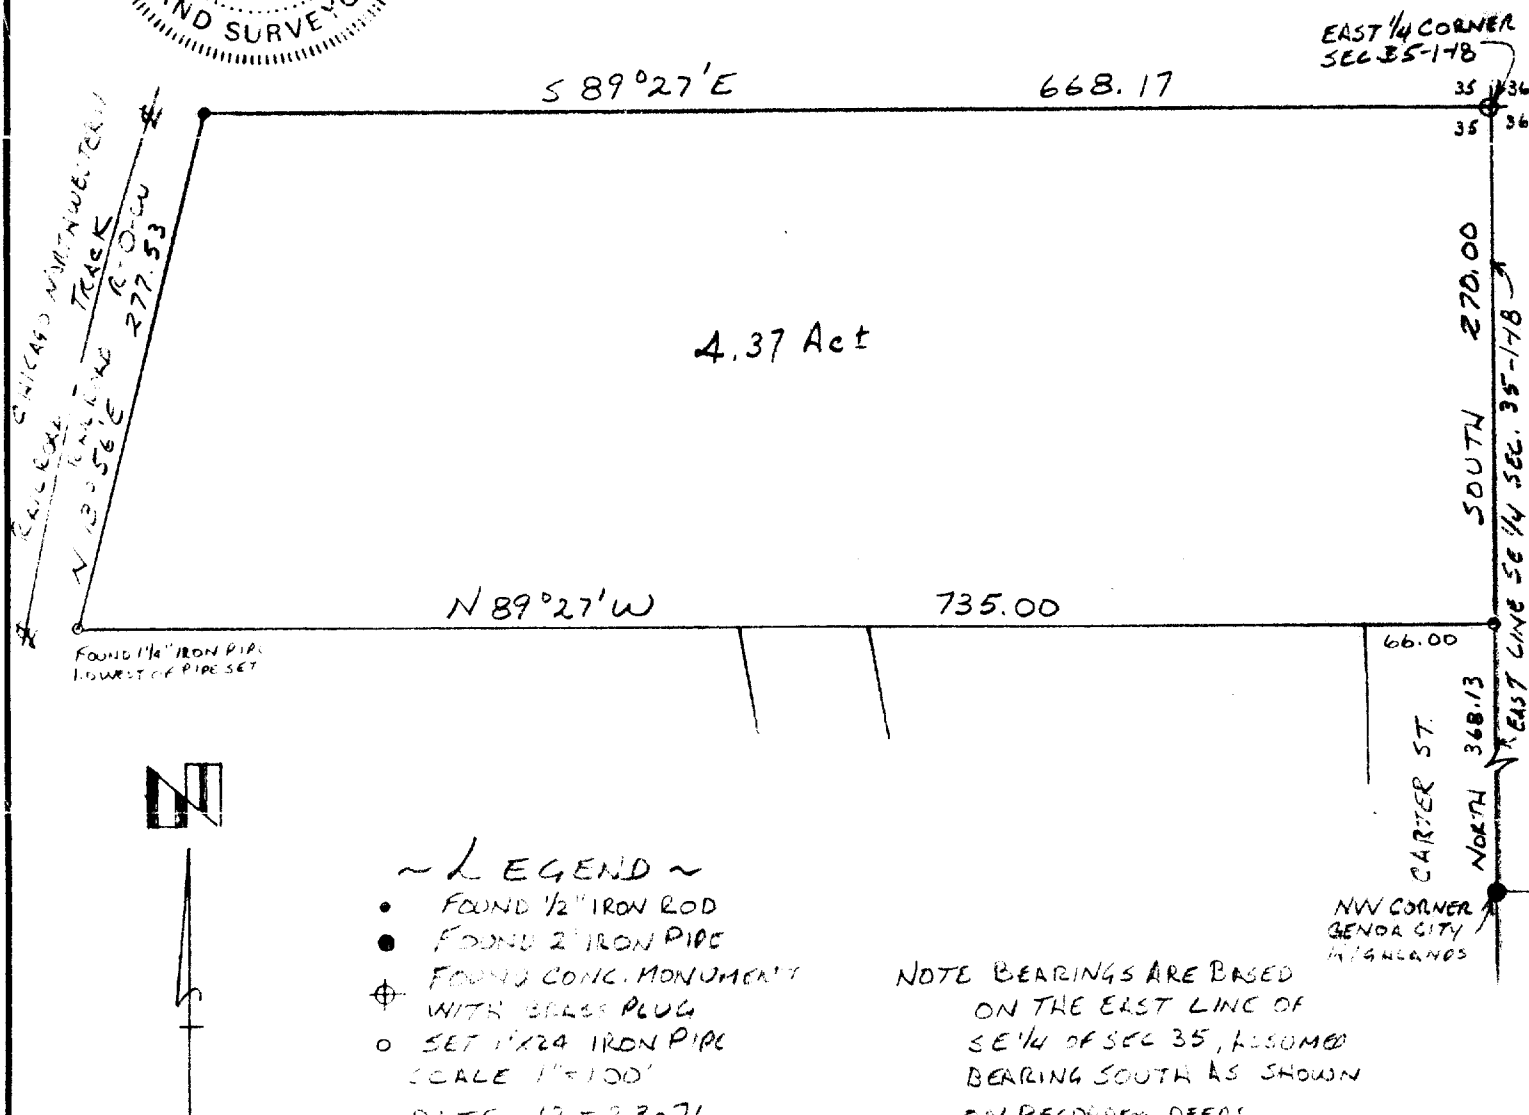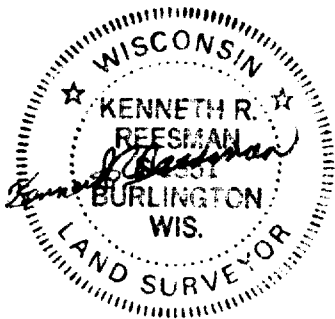

~ LEGEND ~

- FOUND 1/2" IRON ROD
- FOUND 2" IRON PIPE
- ⊕ FOUND CONC. MONUMENT WITH BRASS PLUG
- SET 1/2" IRON PIPE SCALE 1"=100'

DATE 12-23-76

THIS SURVEY WAS BASED ON DESCRIPTION
FROM BURLINGTON CO-OP AND
SURVEY DATED DEC. 1959 BY CLOYD JENSEN.

NOTE BEARINGS ARE BASED
ON THE EAST LINE OF
SE 1/4 OF SEC 35, ASSUMED
BEARING SOUTH AS SHOWN
ON RECORDED DEEDS.

76246