

DEGEN, FOAT SURVEYING ASSOCIATES



100 SOUTH SECOND STREET
WATERFORD, WISCONSIN
(262)534-5404 (FAX)534-2022

004201
004201S1.DWG

PLAT OF SURVEY

LOT 59, GENOA TRAILS SUBDIVISION NO. 1, A REDDIVISION OF LOT 3 CERTIFIED SURVEY MAP NO. 2191, RECORDED IN VOLUME NO. 10 ON PAGE 277 OF THE WALWORTH COUNTY CERTIFIED SURVEY MAPS AS DOCUMENT NO. 239621, LOCATED IN THE NORTHWEST 1/4 OF THE SOUTHWEST 1/4 OF SECTION 36, TOWN 1 NORTH, RANGE 18 EAST, VILLAGE OF GENOA CITY, WALWORTH COUNTY, WISCONSIN.

SURVEY PREPARED FOR: RE/MAX-SOUTHERN LAKES
112 ELIZABETH LANE
GENOA CITY, WI 53128

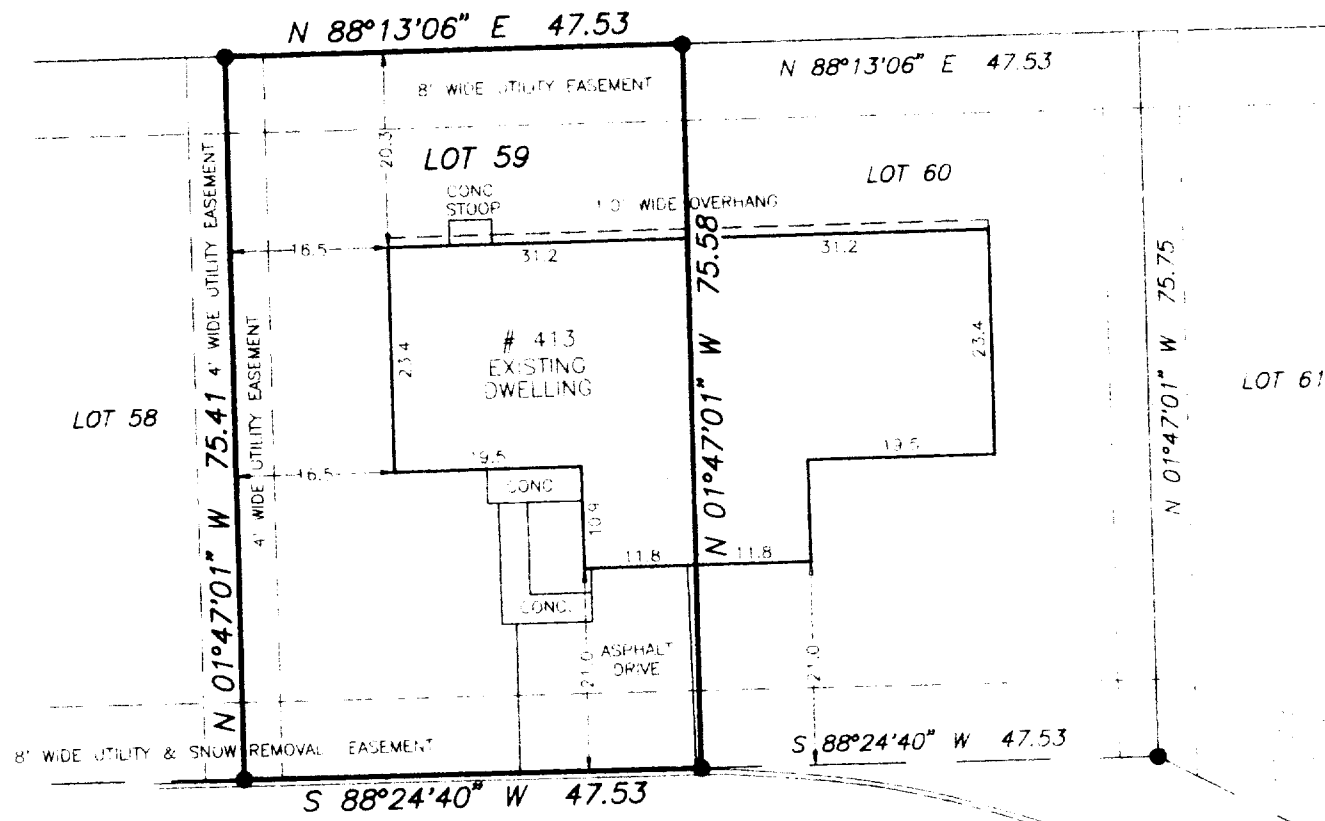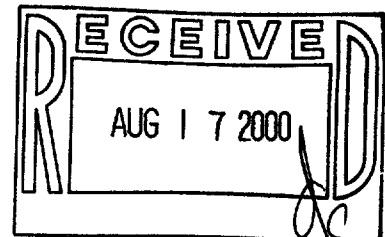

FENMORE COURT
(APPROXIMATE CENTERLINE)

(40' WIDE)

SCALE: 1" = 20'

BEARING BASE AS RECORDED AS

LEGEND

● - FOUND IRON ROD

I HEREBY CERTIFY THAT I HAVE SURVEYED THE ABOVE DESCRIBED PROPERTY AND THE ABOVE MAP IS A TRUE REPRESENTATION THEREOF AND SHOWS THE SIZE AND LOCATION OF THE PROPERTY, THE LOCATION OF ALL VISIBLE STRUCTURES AND DIMENSIONS OF ALL PRINCIPAL BUILDINGS THEREON, BOUNDARY FENCES, APPARENT EASEMENTS, ROADWAYS, AND MOBILE ENCLOSURES, IF ANY.

THIS SURVEY IS MADE FOR THE PRESENT OWNERS OF THE PROPERTY AND I AND MY FIRM DO NOT GUARANTEE THE TITLE THEREOF WITHIN (1) YEAR FROM THE DATE HEREOF.

DATED AT WATERFORD, WI THIS 16th DAY OF JUNE

RECERTIFIED

006-767

TGT1-45