


PLAT OF SURVEY
-OF-

LOT 13 EXCEPT THE WEST 10 FEET ALSO EXCEPTING THE EAST 50 FEET OF THE
THE WEST 60 FEET OF THE ORIGINAL PLAT OF THE VILLAGE OF GENOA CITY, IN
THW WEST 1/2 OF THE SOUTHEAST 1/4 OF SECTION 35, IN THE VILLAGE OF
GENOA CITY, COUNTY OF WALWORTH, STATE OF WISCONSIN.


SURVEY FOR: GAIL REMPERT
SURVEY LOCATION: 720 MAIN STREET

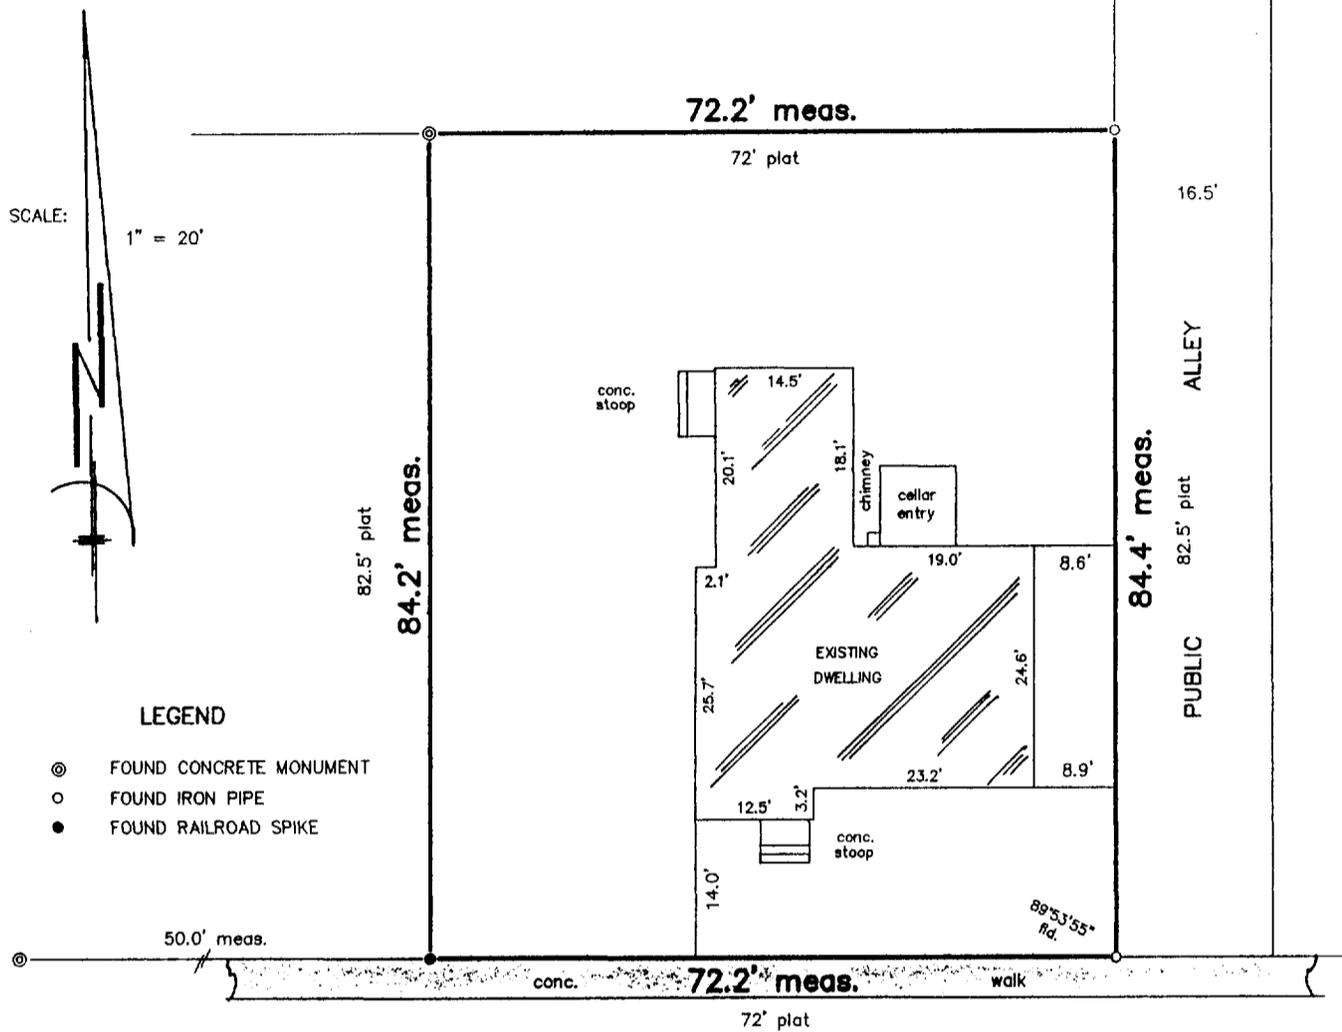

SCALE:
1" = 20'

LEGEND

- ⊙ FOUND CONCRETE MONUMENT
- FOUND IRON PIPE
- FOUND RAILROAD SPIKE

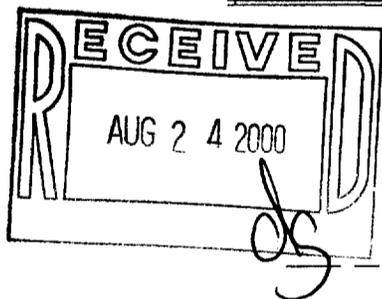


--- MAIN --- STREET ---

"I hereby certify that I have surveyed the above described property and that the above map is a correct representation thereof and shows the size and location of the property, its exterior boundaries, the location of all visible structures and dimensions of all principal buildings thereon, boundary fences, apparent easements, roadways and encroachments, if any."

"This survey is made for the use of the present owners of the property, and those who purchase, mortgage, or guarantee the title thereto within one year from date hereof."



THIS IS NOT AN ORIGINAL PRINT
UNLESS THIS SEAL IS RED.

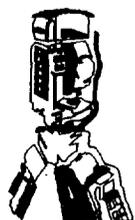

B.W. SURVEYING, INC.

412 N. PINE STREET
BURLINGTON, WI 53105
(262)-767-0225

Robert J. Wetzel
ROBERT J. WETZEL S-1778

6/20/00
DATE

4534
JOB NUMBER

TOP-23

006-769