




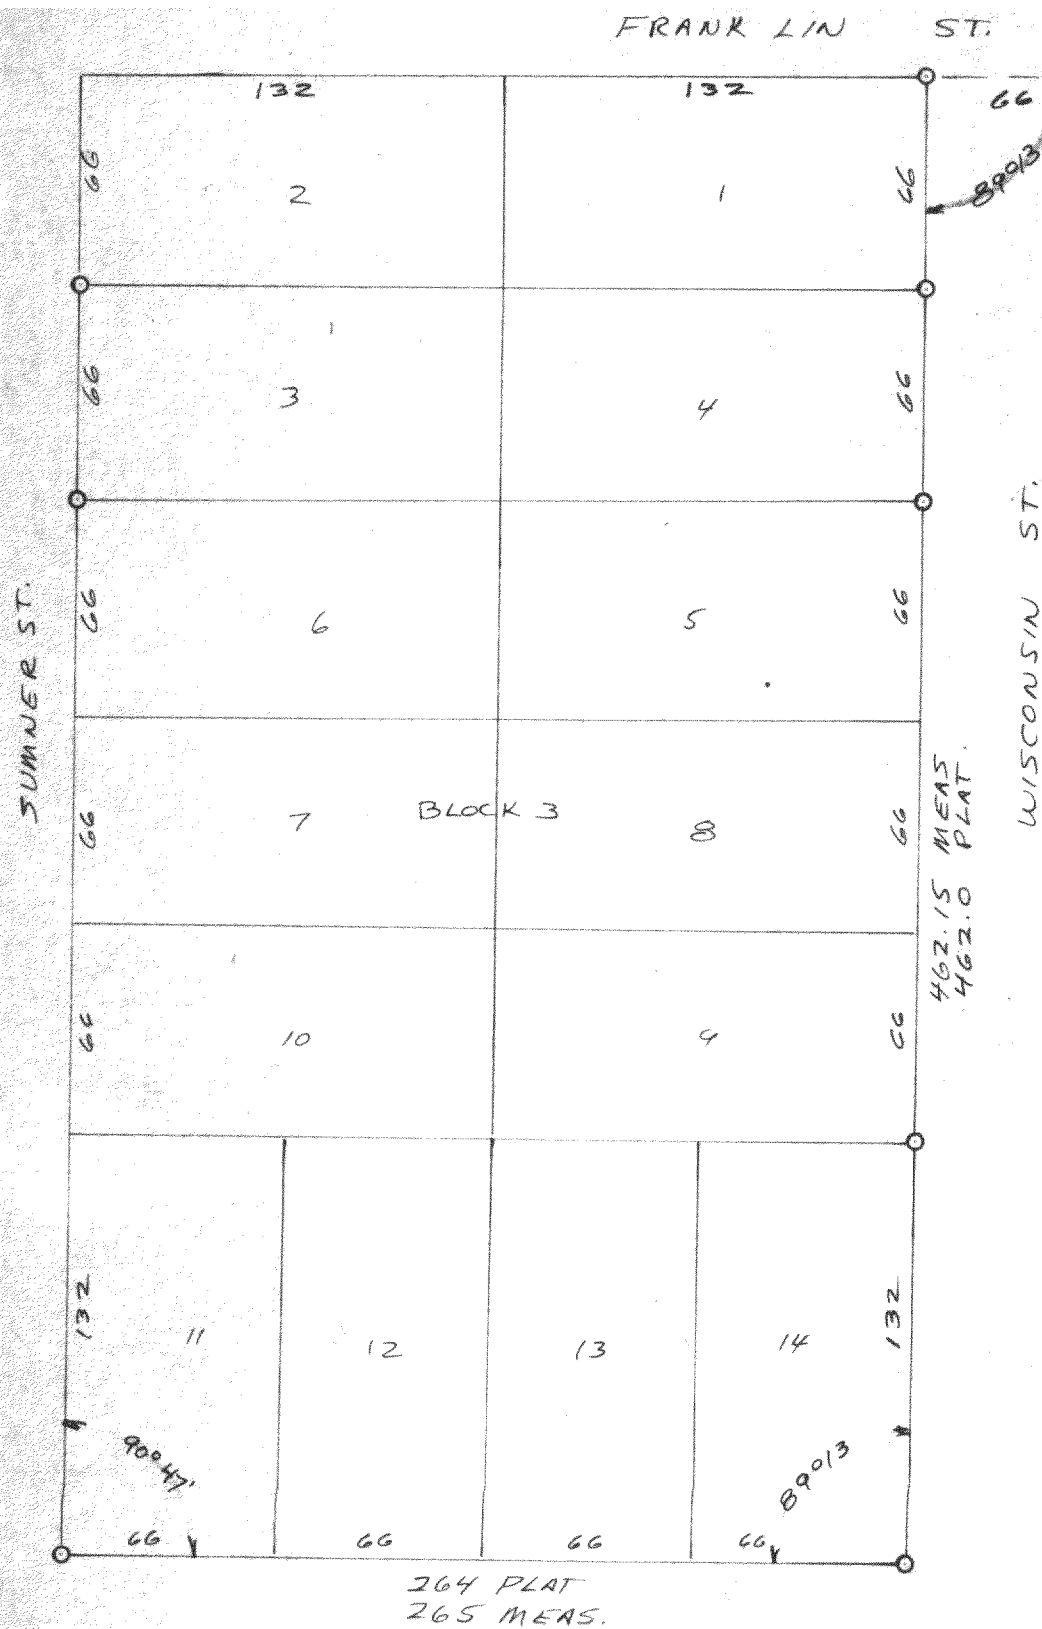


BOND ST.

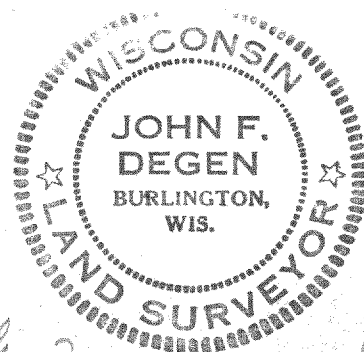

SCALE 1" = 20' (DETAIL)
SCALE 1" = 60' SUB. PLAT.
o = IRON PIPE STAKE FOUND
σ = IRON PIPE STAKE SET
x = CROSS CUT IN CONCRETE.

FOR: LARRY HODGES.

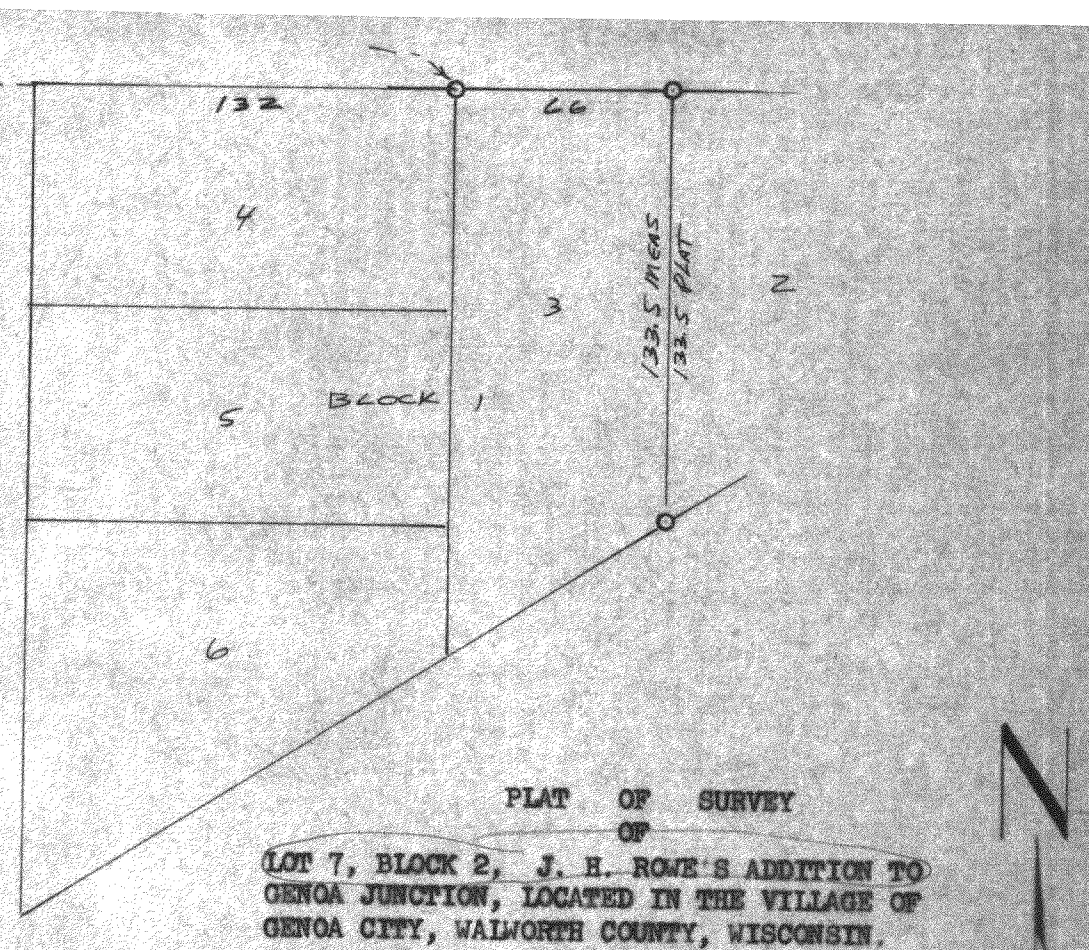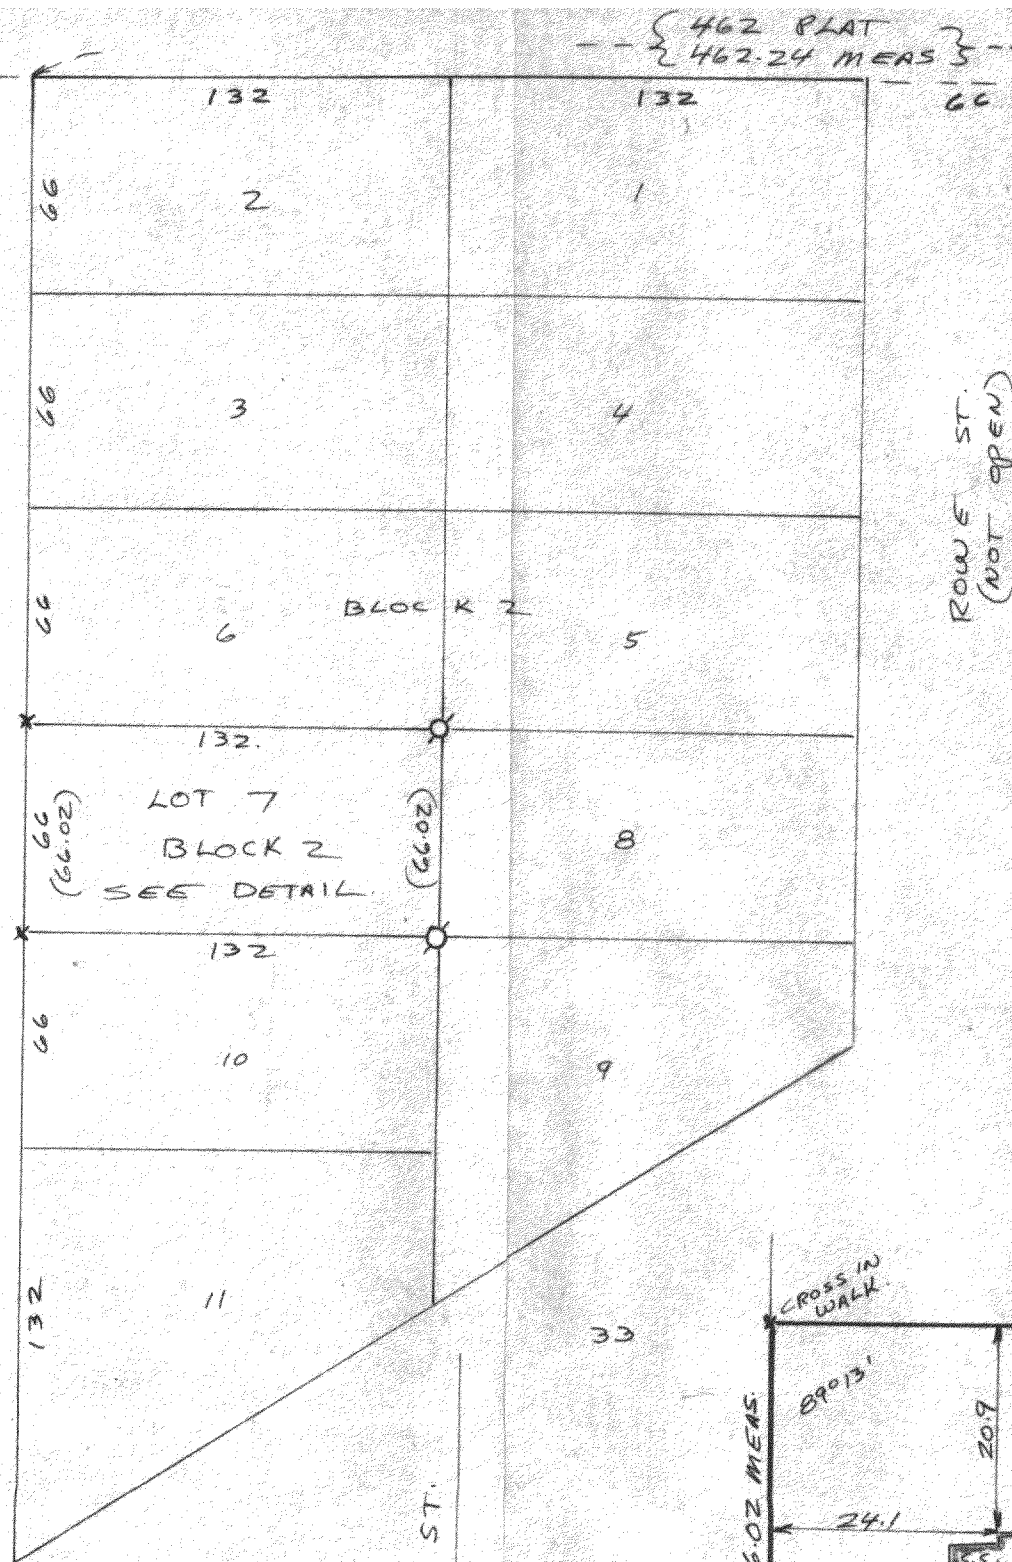

I HEREBY CERTIFY THAT I HAVE SURVEYED LOT 7, BLOCK 2, J. H. ROWE'S ADDITION TO GENOA JUNCTION AND THAT THE PLAT DRAWN HEREON IS A CORRECT REPRESENTATION OF SAID SURVEY. I FURTHER CERTIFY THAT THE BUILDING S ON SAID LAND ARE LOCATED AS SHOWN.

John F. Degen 2-12-77
JOHN F. DEGEN, LAND SURVEYOR 242
BURLINGTON, WIS.

