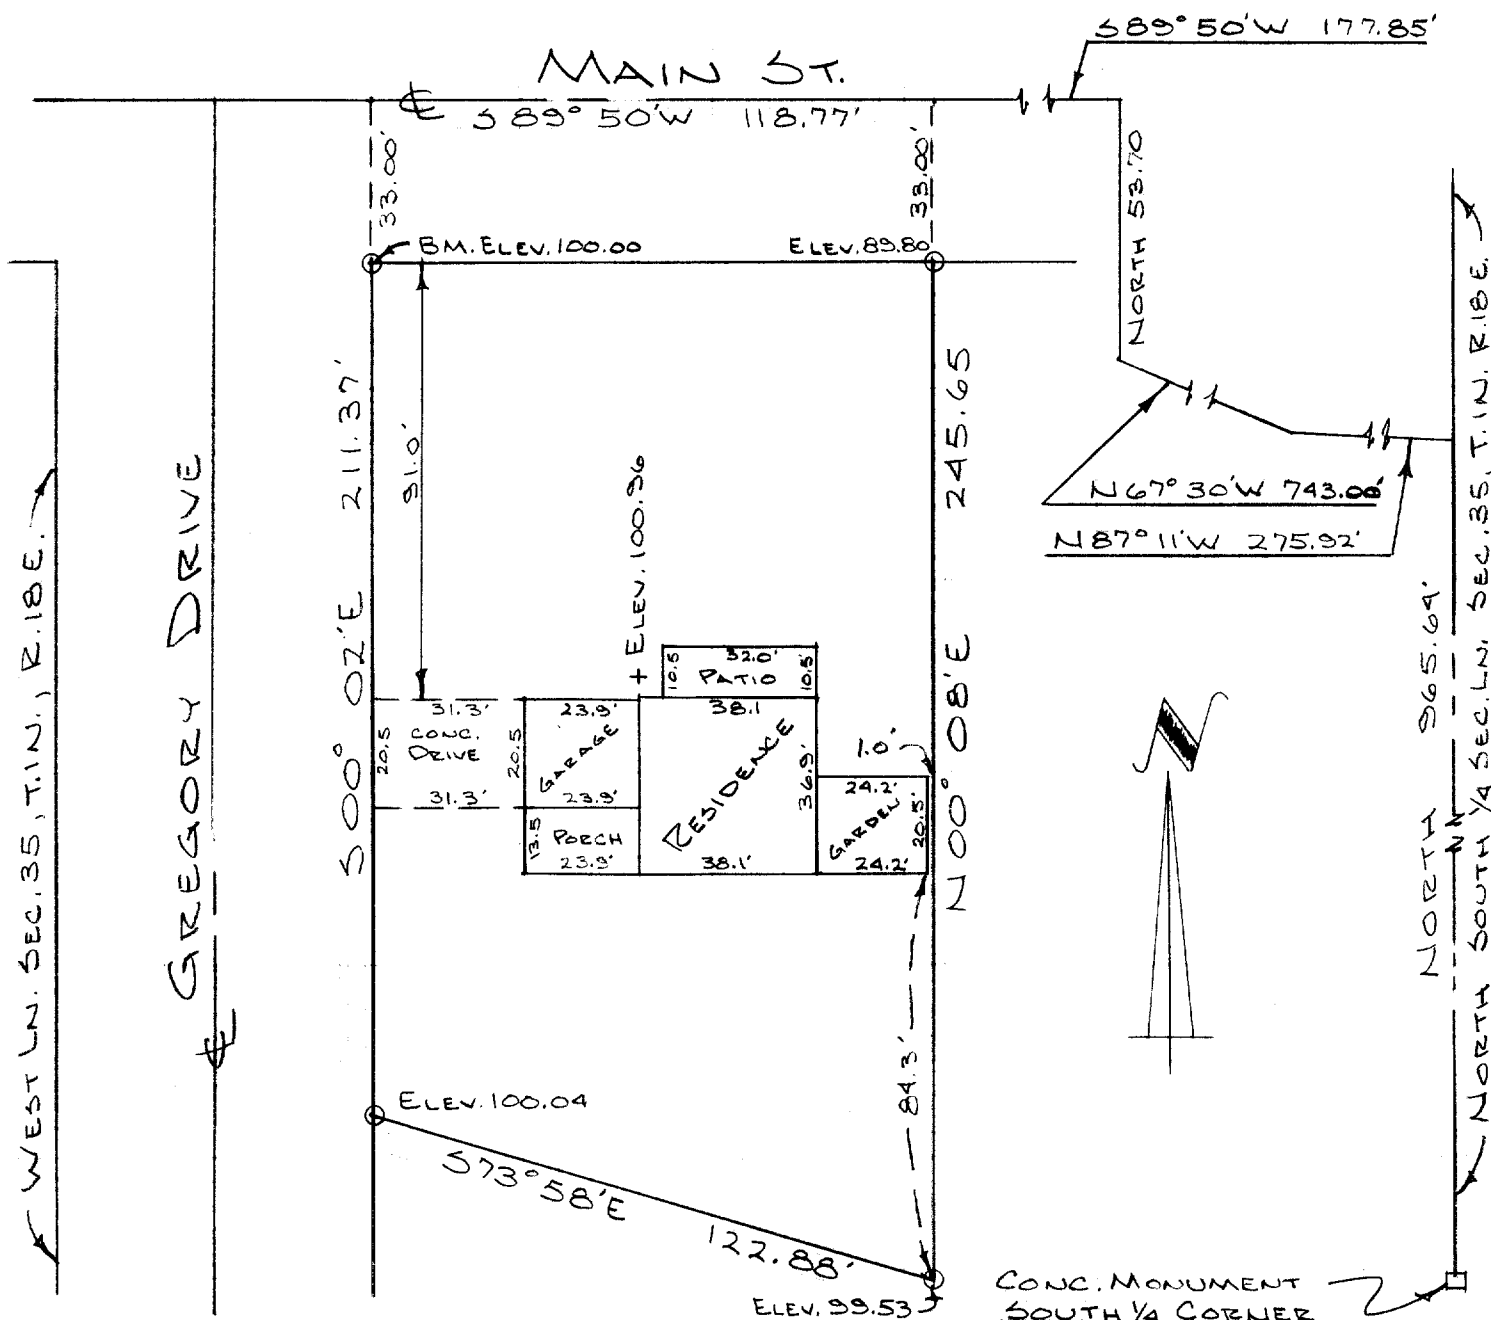


PART OF SE $\frac{1}{4}$  OF SW $\frac{1}{4}$  OF SECTION 35, T1N, R18E**DESCRIPTION:**

Commencing at the South  $\frac{1}{4}$  corner of Section 35, T1N, R18E, Village of Genoa City, Walworth County, Wisconsin, thence North along the East line of the SW $\frac{1}{4}$  of said Section 35, 965.64 feet, thence N 87°11' W, 275.92 feet, thence N 67°30' W, 743.00 feet, thence North 53.70 feet, thence S 89°50' W, 177.85 feet to the place of beginning of the lands hereinafter described, to wit; thence continue S 89°50' W, 118.77 feet to a point that is 66.00 feet of the West line of the SE $\frac{1}{4}$  of the SW $\frac{1}{4}$  of said Section 35, thence S 0°02' E parallel with said West line of the SE $\frac{1}{4}$  of the SW $\frac{1}{4}$  of said Section 35, 211.37 feet, thence S 73°58' E, 122.88 feet, thence N 0°08' E, 245.65 feet to the place of beginning, containing 27061 square feet of land more or less.

**CERTIFICATE:**

I, James F. Biagi, surveyor, do hereby certify that I have surveyed the lands hereon described.

DATED: October 26, 1970

*James F. Biagi*  
James F. Biagi R.L.S. 272