


WALWORTH ST.

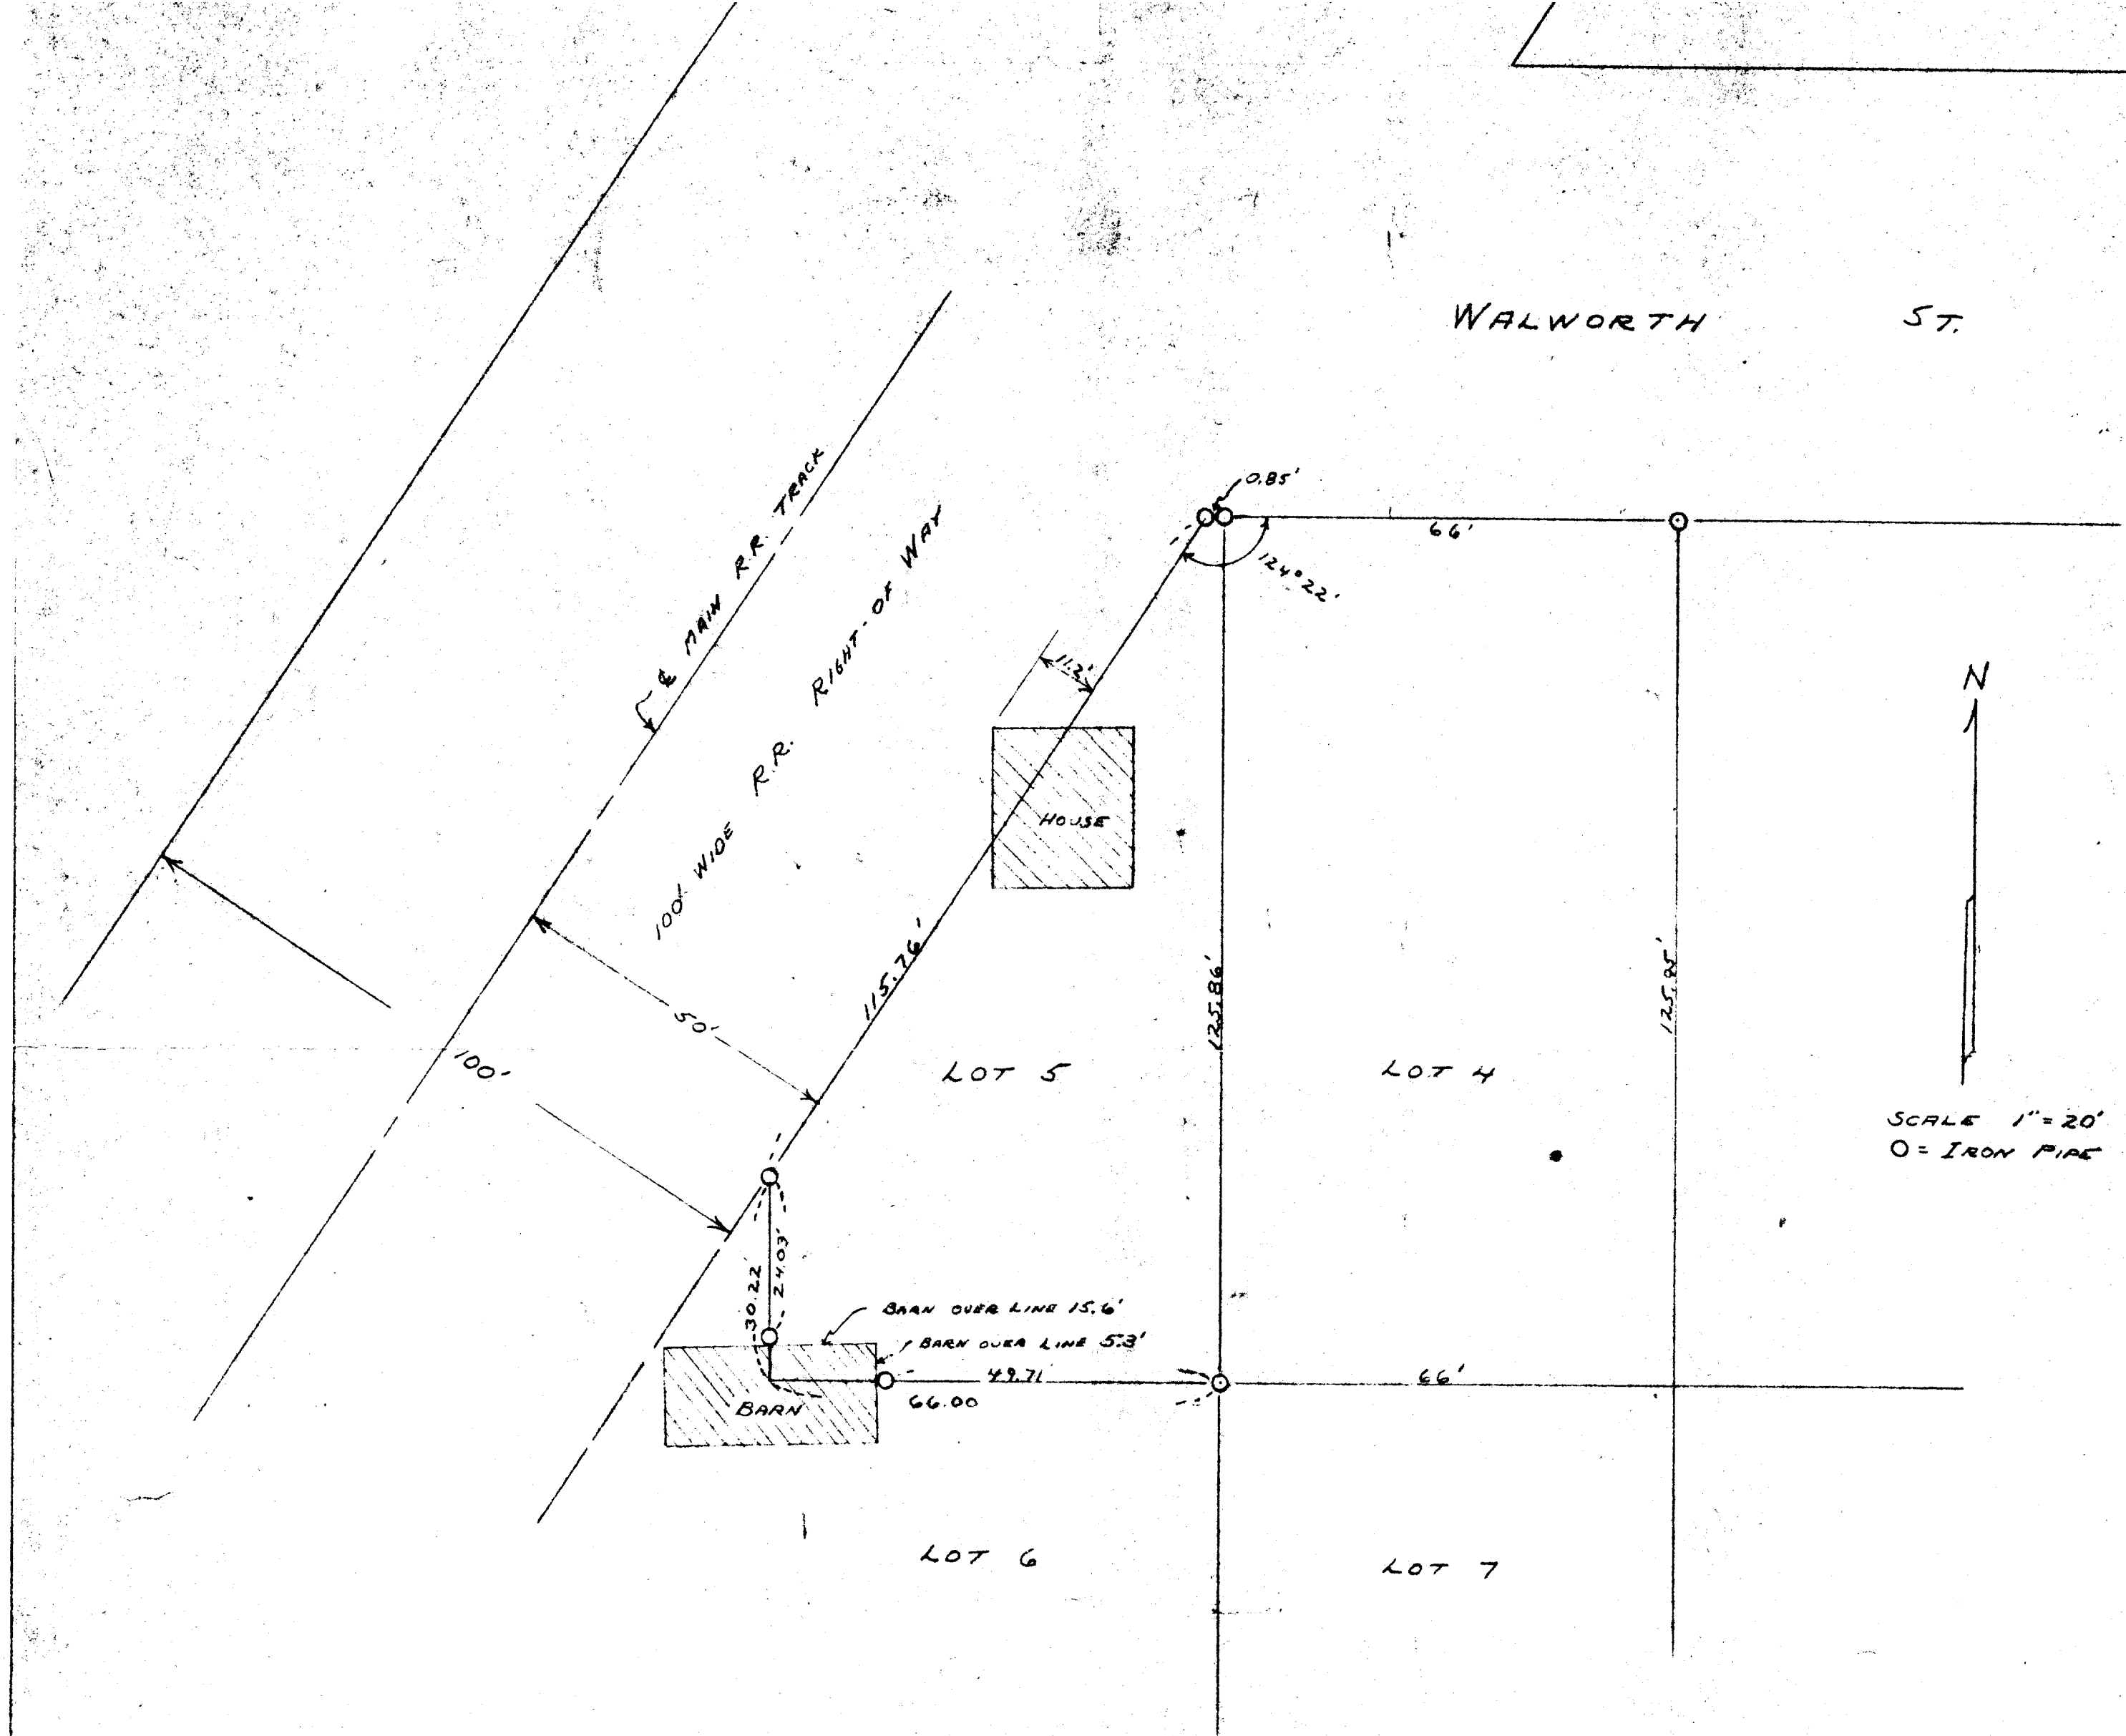

SCALE 1"=20'
O = IRON PIPE

PLAT OF SURVEY
PART LOT 5 OF THE ORIGINAL PLAT OF THE
VILLAGE OF GENOA CITY, WALWORTH COUNTY,
WISCONSIN.
DEC 23, 1950

H. E. Johnson
SURVEYOR

6-7J

OP-1011 OP-11