

PLAT OF SURVEY **-OF-**

LOT 13, OF CAREY'S ADDITION TO THE
VILLAGE OF GENOA CITY, LOCATED IN
THE COUNTY OF WALWORTH AND STATE
OF WISCONSIN.

SURVEY FOR: REMAX OF SOUTHERN LAKES
SURVEY LOCATION: 121 WISCONSIN ST.

LEGEND

- △ FOUND SOLID IRON STAKE
- FOUND IRON PIPE
- SET P.K. NAIL



"I hereby certify that I have surveyed the above described property and that the above map is a correct representation thereof and shows the size and location of the property, its exterior boundaries, the location of all visible structures and dimensions of all principal buildings thereon, boundary fences, apparent easements, roadways and encroachments, if any."

"This survey is made for the use of the present owners of the property, and those who purchase, mortgage, or guarantee the title thereto within one year from date hereof."



B.W. SURVEYING, INC.

412 N. PINE STREET
BURLINGTON, WI 53105
(262)-767-0225

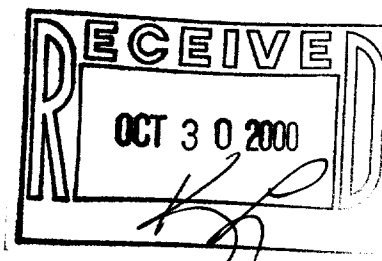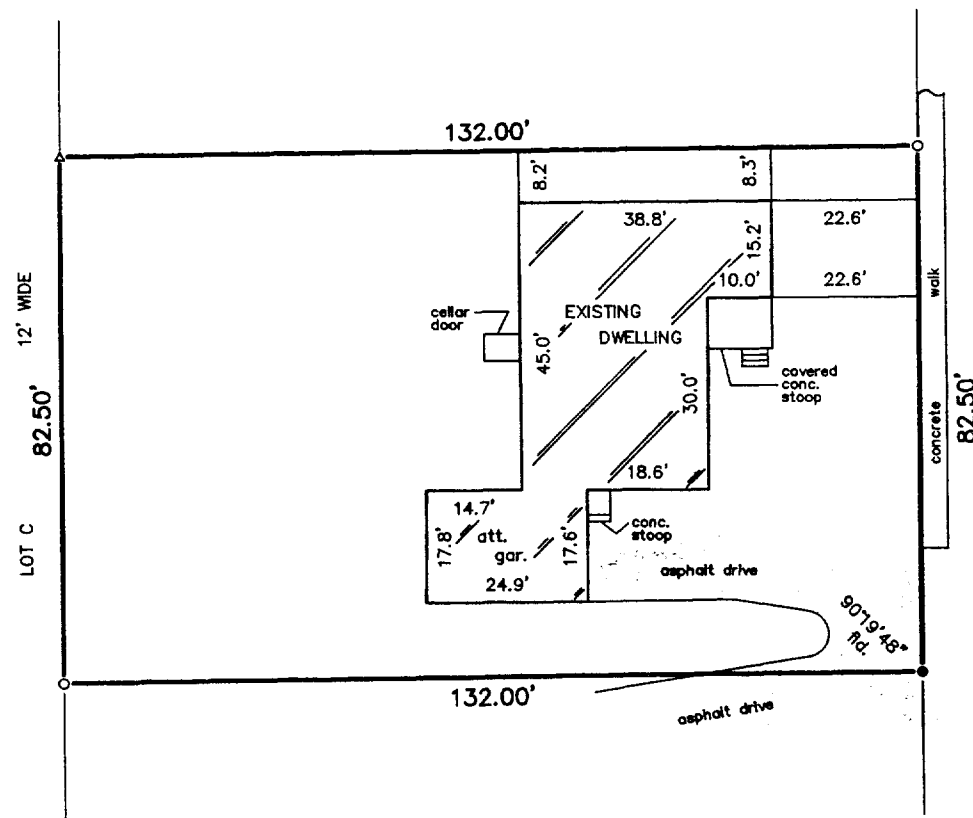


THIS IS NOT AN ORIGINAL PRINT
UNLESS THIS SEAL IS RED.

WISCONSIN STREET

SCALE:

1" = 30'

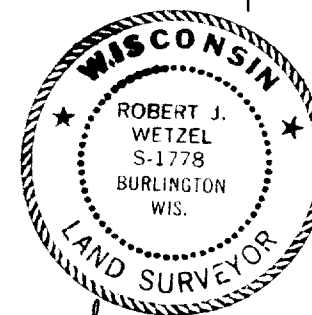

Robert J. Wetzel
ROBERT J. WETZEL S-1778

AUGUST 21, 2000
DATE

4633
JOB NUMBER