


PLAT OF SURVEY

-OF-

LOT 110 IN HUNTERS RIDGE SUBDIVISION, LOCATED IN THE SOUTHWEST 1/4 OF SECTION 25, TOWN 1 NORTH, RANGE 18 EAST, VILLAGE OF GENOA CITY, WALWORTH COUNTY, WISCONSIN.


SURVEY FOR: RODNEY LESTER

SURVEY LOCATION: 246 HIGHLAND AVENUE

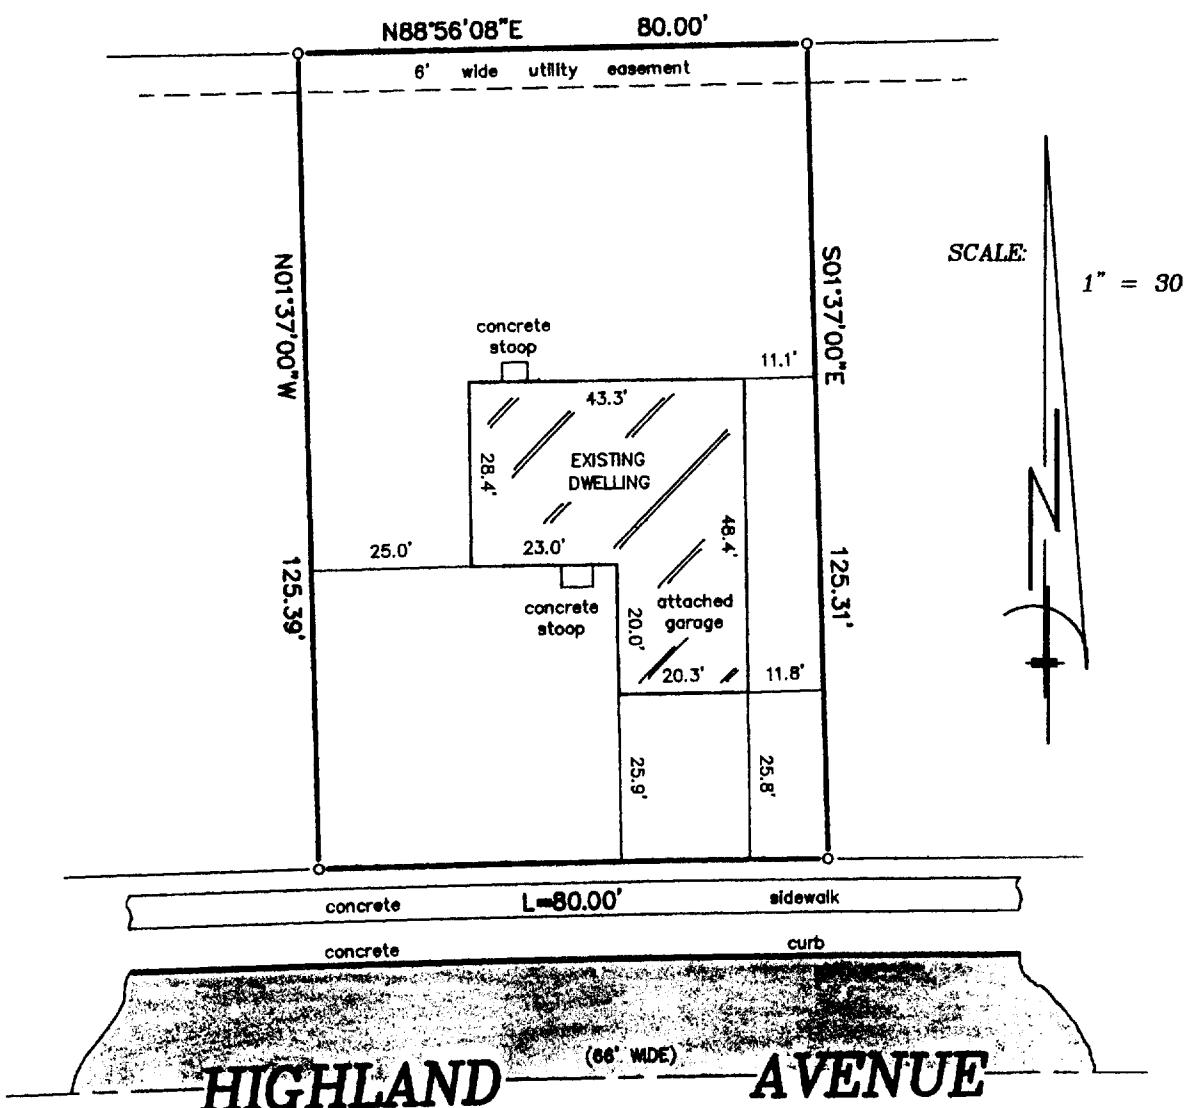


LEGEND

○ FOUND IRON ROD

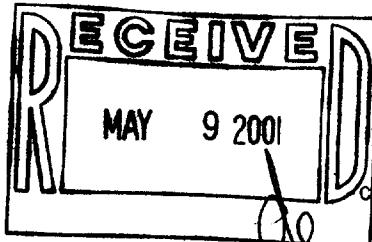

CURVE DATA

RADIUS = 4348.00'  
CENTRAL ANGLE = 1°03'15"  
CHORD = 80.00'  
CHORD BEARING = S88°52'14.5"W

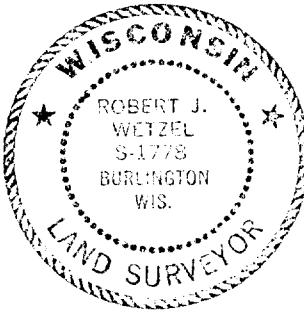

THIS IS NOT AN ORIGINAL PRINT  
UNLESS THIS SEAL IS RED.

*Robert J. Wetzel*  
ROBERT J. WETZEL S-1778

APRIL 9, 2001


4906

DATE

JOB NUMBER

"I hereby certify that I have surveyed the above described property and that the above map is a correct representation thereof and shows the size and location of the property, its exterior boundaries, the location of all visible structures and dimensions of all principal buildings thereon, boundary fences, apparent easements, roadways and encroachments, if any."

"This survey is made for the use of the present owners of the property, and those who purchase, mortgage, or guarantee the title thereto within one year from date hereof."

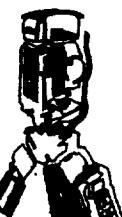

B.W. SURVEYING, INC.

412 N. PINE STREET  
BURLINGTON, WI 53105  
(262)-767-0225

THR-110

06-885