




SCALE-1"=20'
O IRON PIPE
X CROSS IN CONC

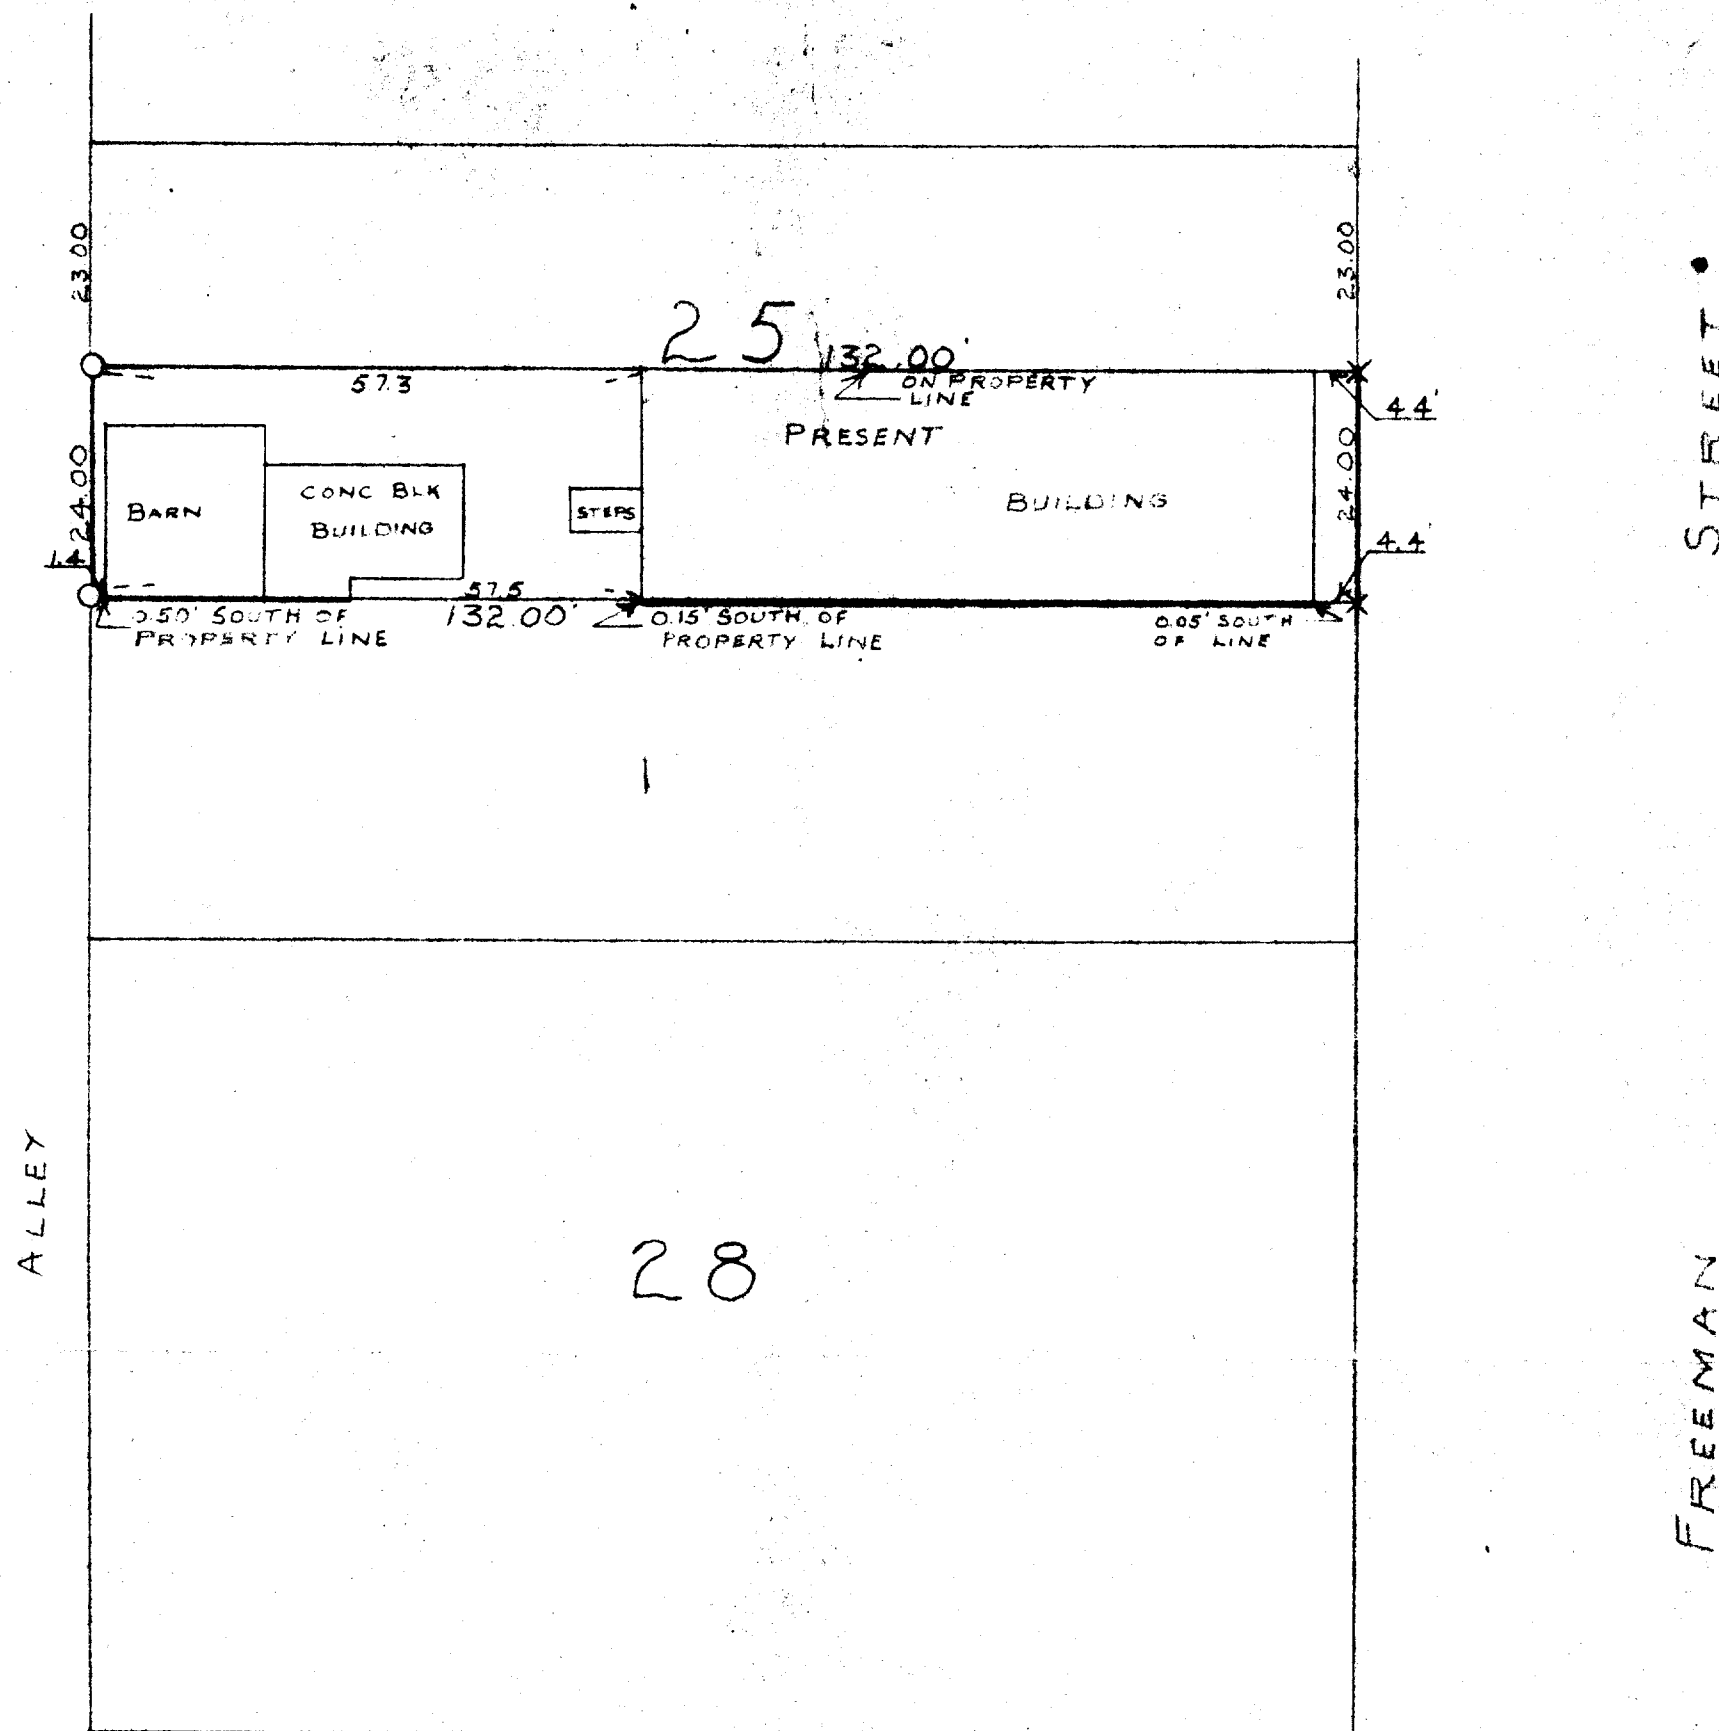

WALWORTH

STREET

PLAT OF SURVEY OF PART OF LOT 25 FREEMANS
ADDITION TO THE VILLAGE OF GENOA CITY WALWORTH
COUNTY WISCONSIN
MARCH 3 1951

H.E. Johnson

6-8J