
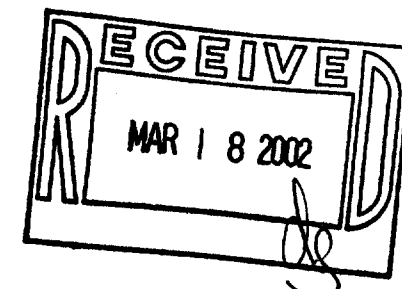


PLAT OF SURVEY OF

Lot 2 of WALWORTH COUNTY CERTIFIED SURVEY MAP NUMBER 2315, according to the recorded plat thereof on file and of record in the office of the Register of Deeds, Walworth County, Wisconsin, as Document Number 261972, recorded July 14, 1993, in Volume 11 of Certified Survey Maps, pages 179 and 180 and being part of the Northeast Quarter of Section 35, Township 1 North, Range 18 East of the 4th Principal Meridian, Village of Genoa City, Walworth County, Wisconsin.

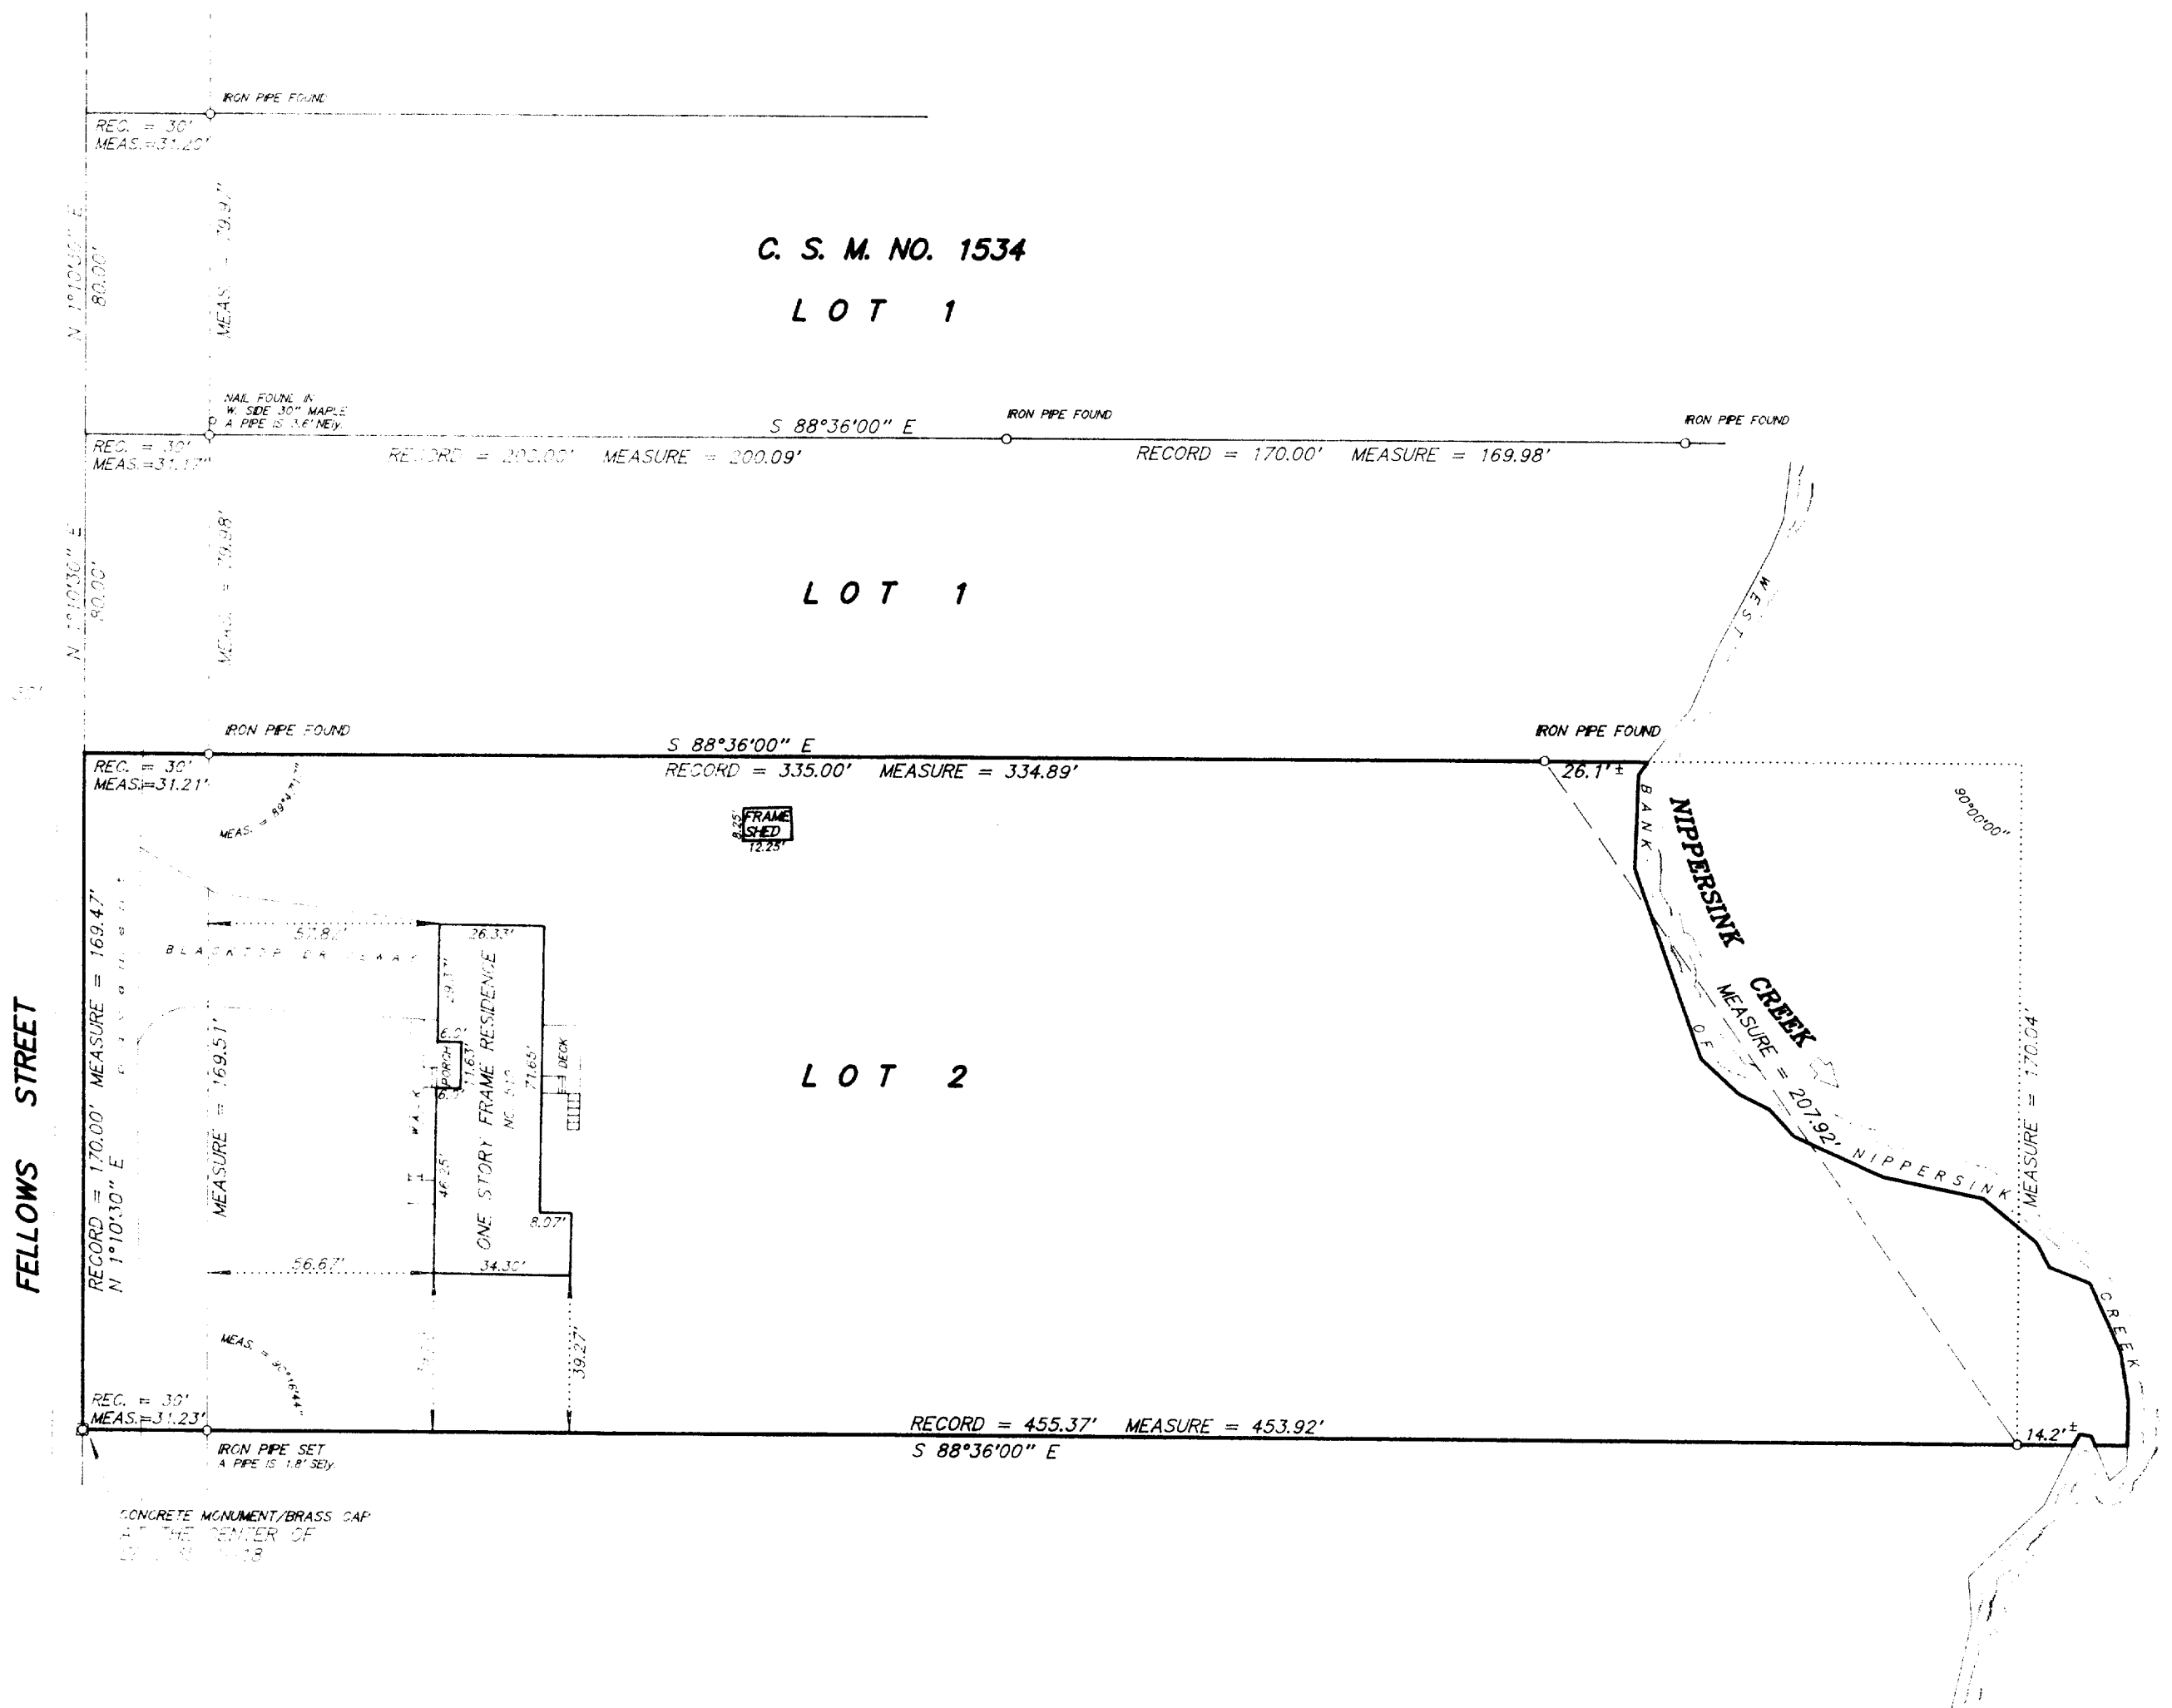

I hereby certify that I have surveyed the above described property and the above plat is a true representation thereof and shows the size and location of the property, its exterior boundaries, the location and dimensions of all visible structures thereon, boundary fences, apparent easements and roadways and visible encroachments, if any.

This survey is made for the exclusive use of the present owners of the property, and also those who purchase, mortgage, or guarantee the title thereto within one year from the date hereof.

Dated at Bassett, Wisconsin this _____ day of _____, 2001.

Mark A. Bolender
Wisconsin Registered Land Surveyor S - 1784

SCALE 1 inch = 40 feet
ORDERED BY W. Carlson
JOB NO. 01238