

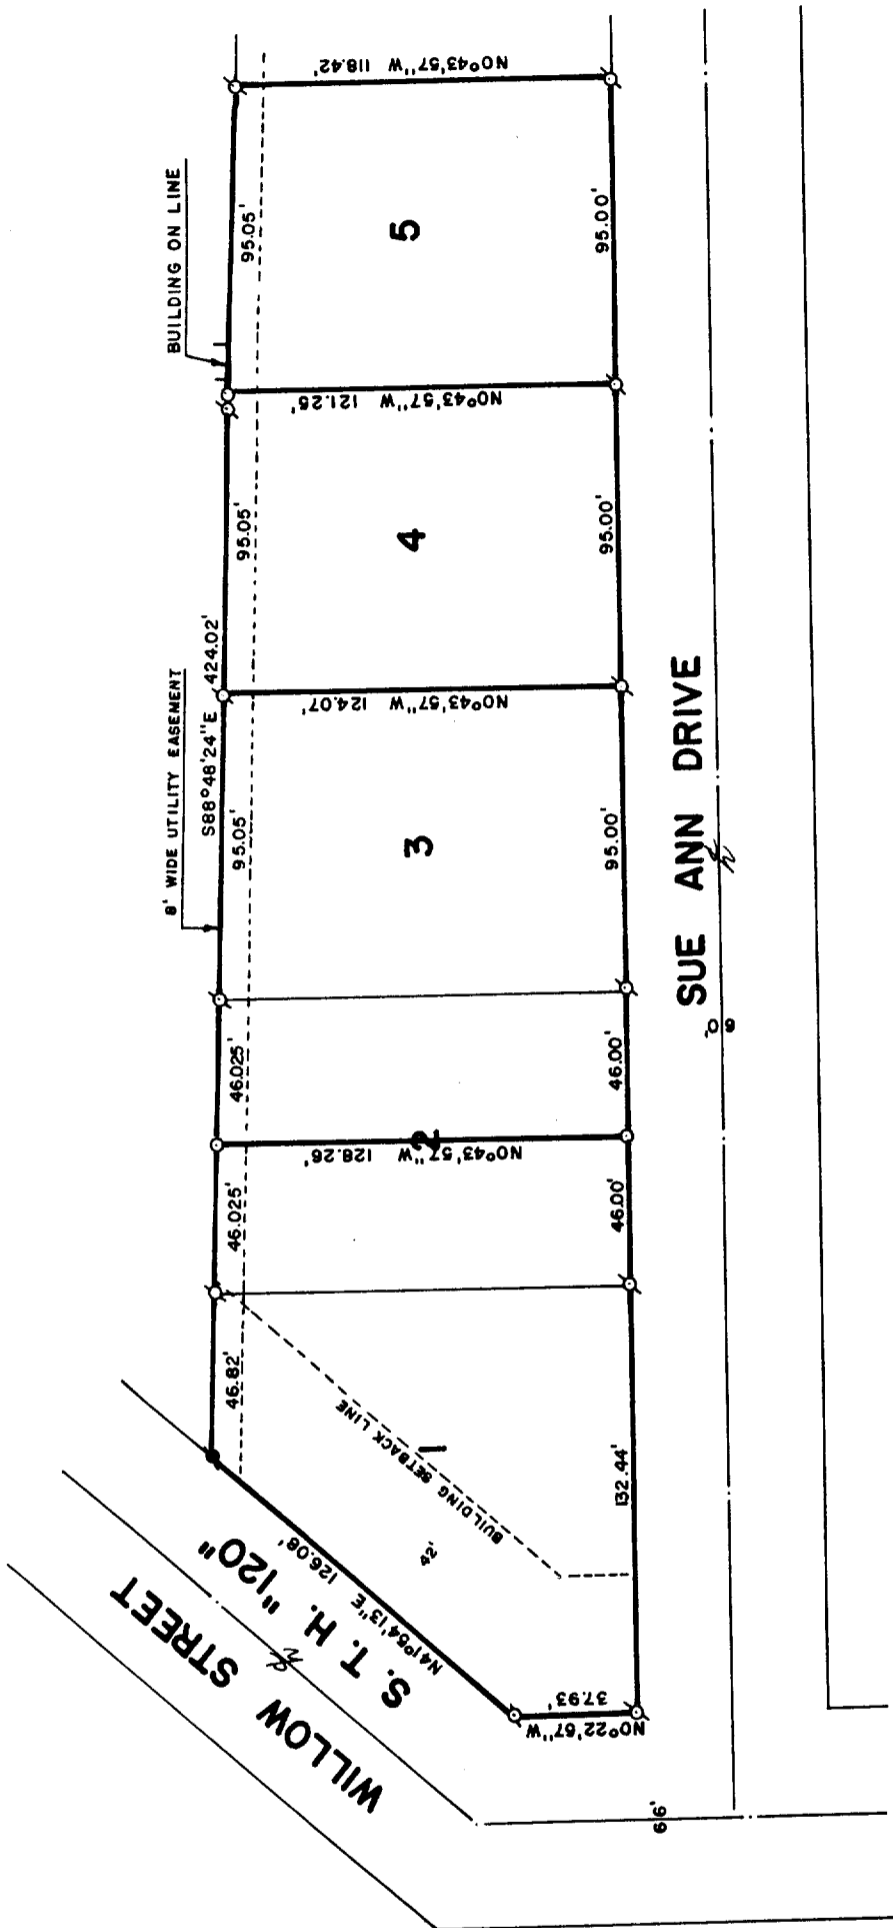


WALWORTH COUNTY
SURVEYING & MAPPING
LAKE GENEVA, WISCONSIN

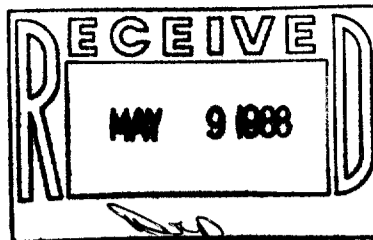

PLAT OF SURVEY OF
 LOTS 1, 2, 3, 4 AND 5 OF BARBARA JEAN ESTATES,
 LOCATED IN THE CITY OF LAKE GENEVA, WALWORTH
 COUNTY, WISCONSIN.
 ORDERED BY: REALTY WORLD-TAGGART
 736 MAIN STREET
 LAKE GENEVA, WISCONSIN
 53147

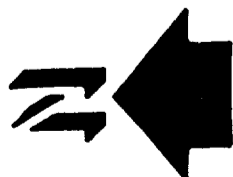

- SCALE: 1"=60'
- - IRON PIPE FOUND
 - - CONCRETE MONUMENT FOUND
 - - IRON ROD PLACED

I, ROBERT M. BAERENWALD, DO HEREBY CERTIFY THAT I HAVE SURVEYED THE PROPERTY HEREON DESCRIBED ACCORDING TO THE OFFICIAL RECORDS AND THAT THE PLAT HEREON IS A CORRECT REPRESENTATION OF THE PROPERTY LINES TO THE BEST OF MY KNOWLEDGE AND BELIEF.

Robert M. Baerenwald
 ROBERT M. BAERENWALD
 WISCONSIN REGISTERED LAND SURVEYOR, S-1508

DATE Jan. 26, 1988
 JOB NO. 1399

NOTE: THIS IS NOT A CERTIFIED COPY UNLESS SEALED.

7-1019