


FARRIS, HANSEN & ASSOCIATES, INC.
 ENGINEERING, ARCHITECTURE, SURVEYING
 7 RIDGWAY COURT - P.O. BOX 437, ELKHORN, WISCONSIN 53121
 PHONE: (414) 723-2098 FAX: (414) 723-5886

PLAT OF SURVEY
 LOT 7 OF GARRISON GLEN SUBDIVISION
 LOCATED IN THE SW & SE 1/4'S OF THE NE 1/4 OF SECTION 1
 TOWN 1 NORTH, RANGE 17 EAST, CITY OF LAKE GENEVA
 WALWORTH COUNTY, WISCONSIN

WORK ORDERED BY: RON GERBERI
 COUNTRY CREEK HOMES
 1400 HICKS ROAD
 ROLLING MEADOWS, IL. 60008

- - FOUND IRON PIPE STAKE
- - FOUND IRON REBAR STAKE
- SET IRON REBAR STAKE
- RECORDED AS


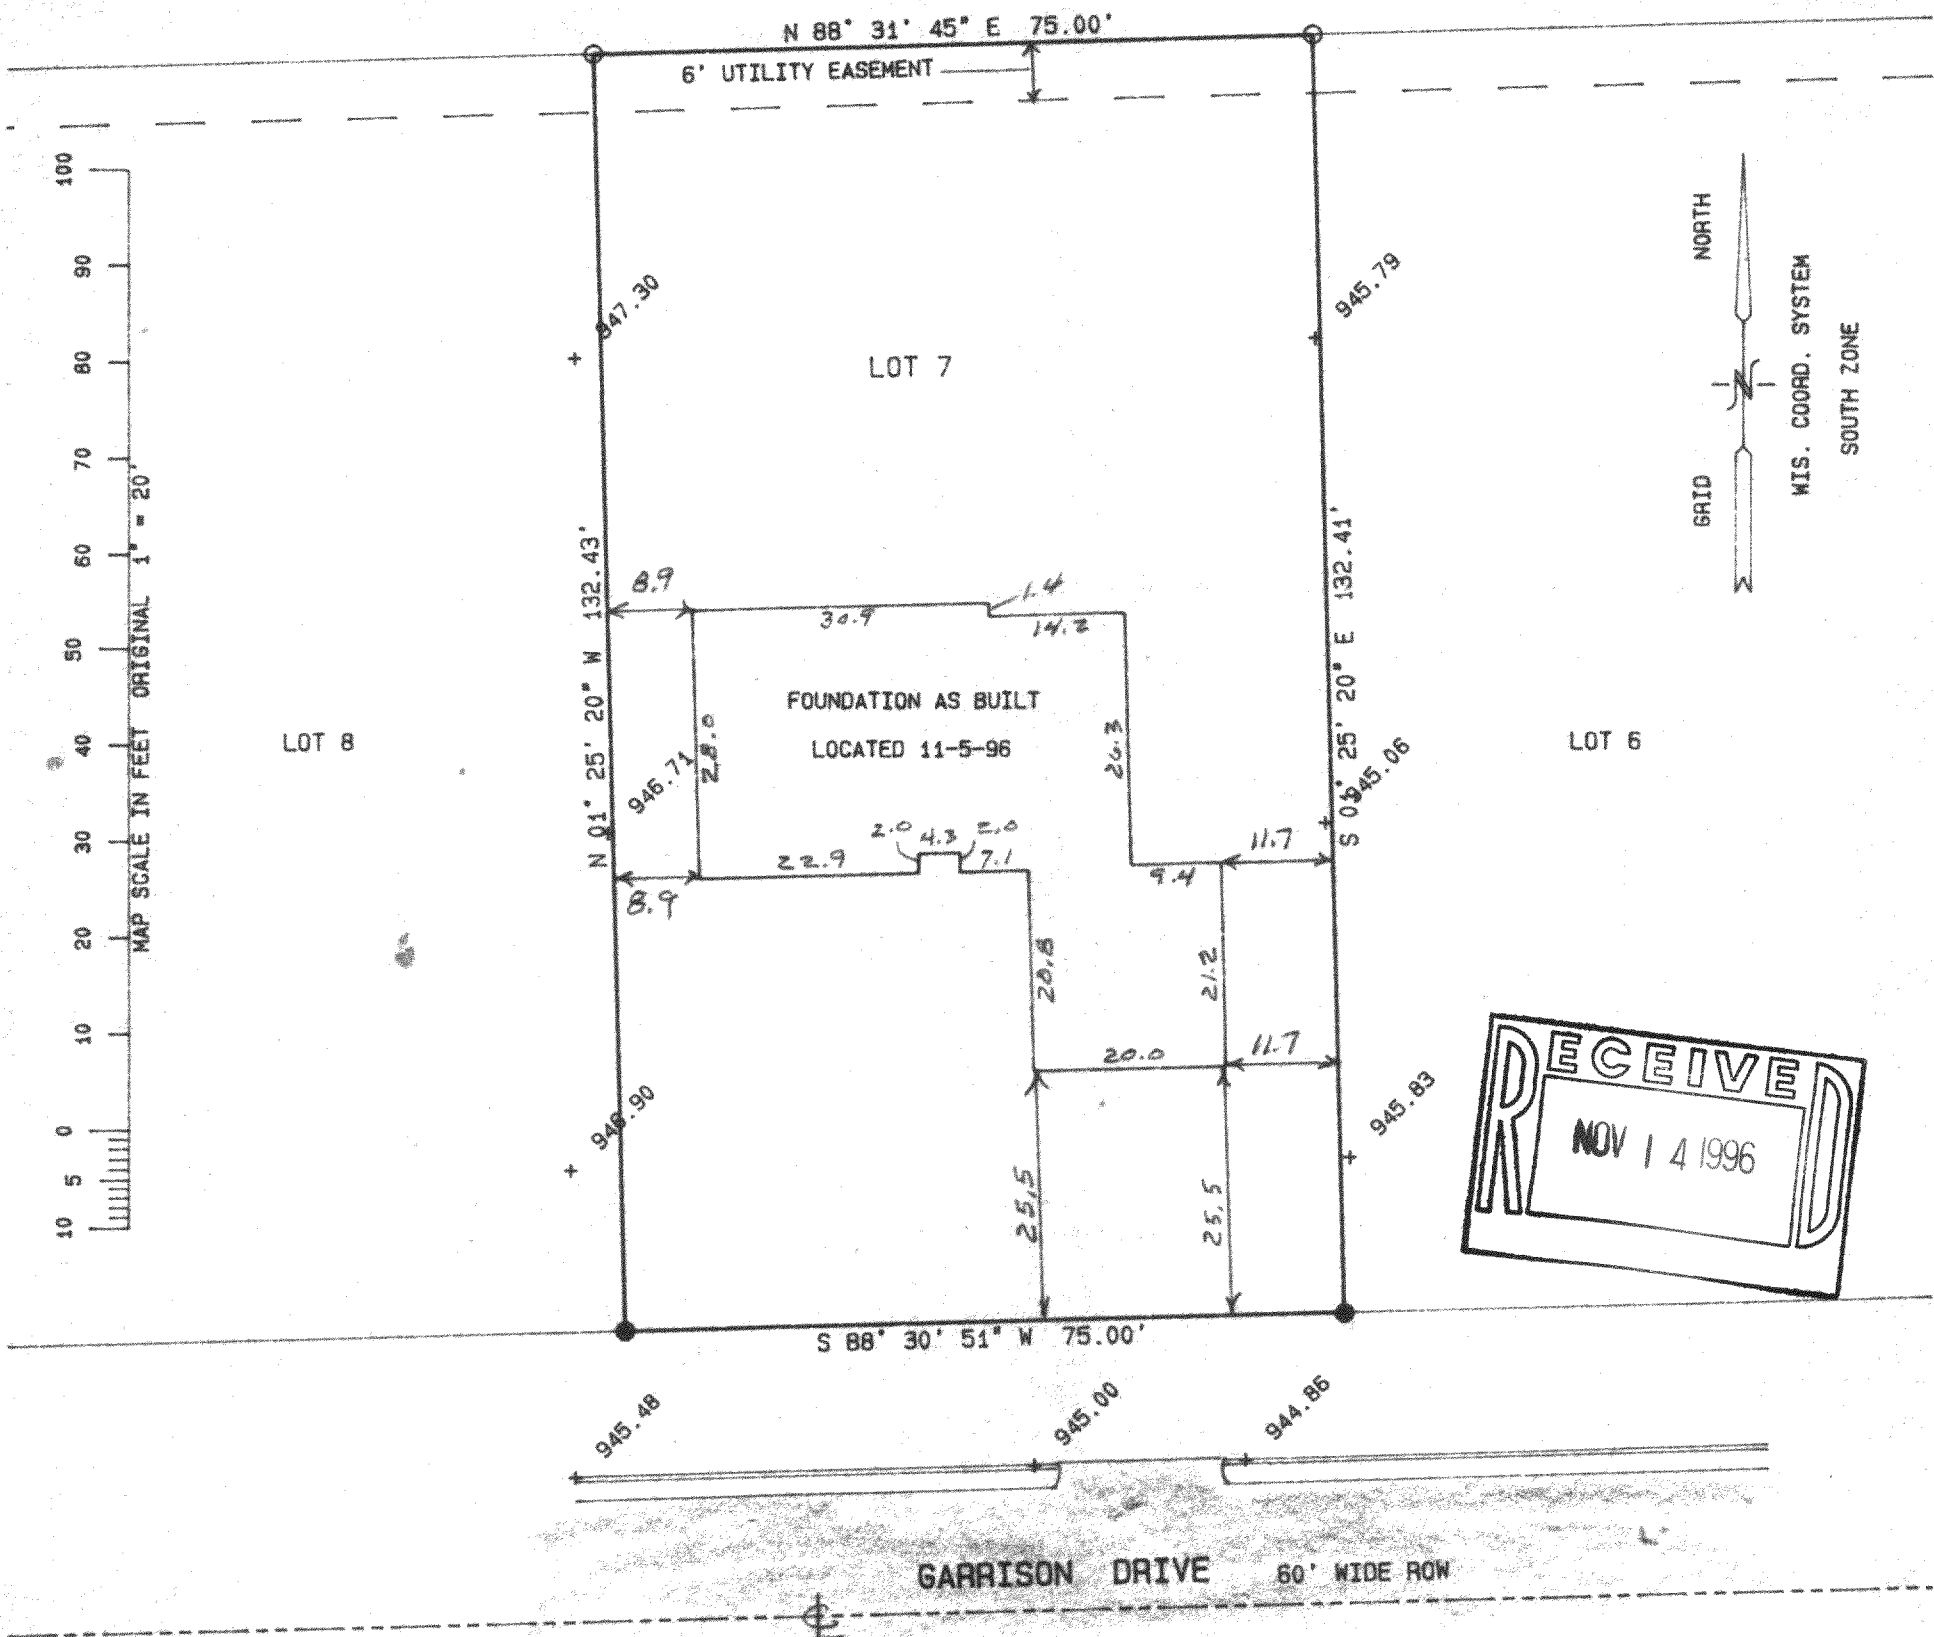


NOTE: COPIES OF THIS MAP TO WHICH THE FOLLOWING CERTIFICATE WILL APPLY ARE BLUE LINE PRINTS SHOWING SURVEYOR'S ORIGINAL SEAL AND SIGNATURE IN BLACK INK. COPIES BY ANY OTHER MEANS MAY HAVE ALTERATIONS WHICH DO NOT REPRESENT THE SURVEYOR'S WORK PRODUCT.

I HEREBY CERTIFY THAT THE ABOVE DESCRIBED PROPERTY HAS BEEN SURVEYED UNDER MY DIRECTION AND THAT THE ABOVE MAP IS A TRUE REPRESENTATION THEREOF AND SHOWS THE SIZE AND LOCATION OF THE PROPERTY AND ITS EXTERIOR BOUNDARIES. THIS SURVEY IS MADE FOR THE USE OF THE PRESENT OWNERS OF THE PROPERTY, AND ALSO THOSE WHO PURCHASE, MORTGAGE, OR GUARANTEE THE TITLE THERETO WITHIN ONE YEAR FROM THE DATE HEREOF.

DATED: 11-6-96

Peter S. Gordon
 PETER S. GORDON R.L.S. 2101

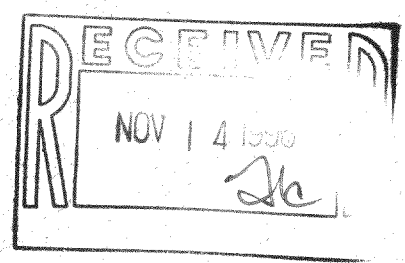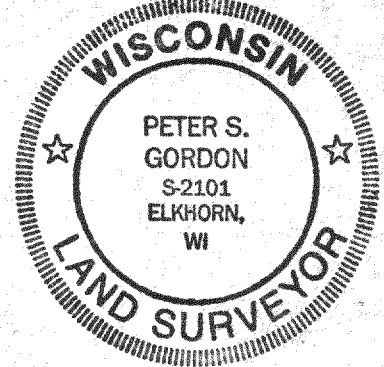

PROJ 3279.7

ZGAR-7

007-1672