



WALWORTH COUNTY  
SURVEYING & MAPPING  
LAKE GENEVA, WISCONSIN

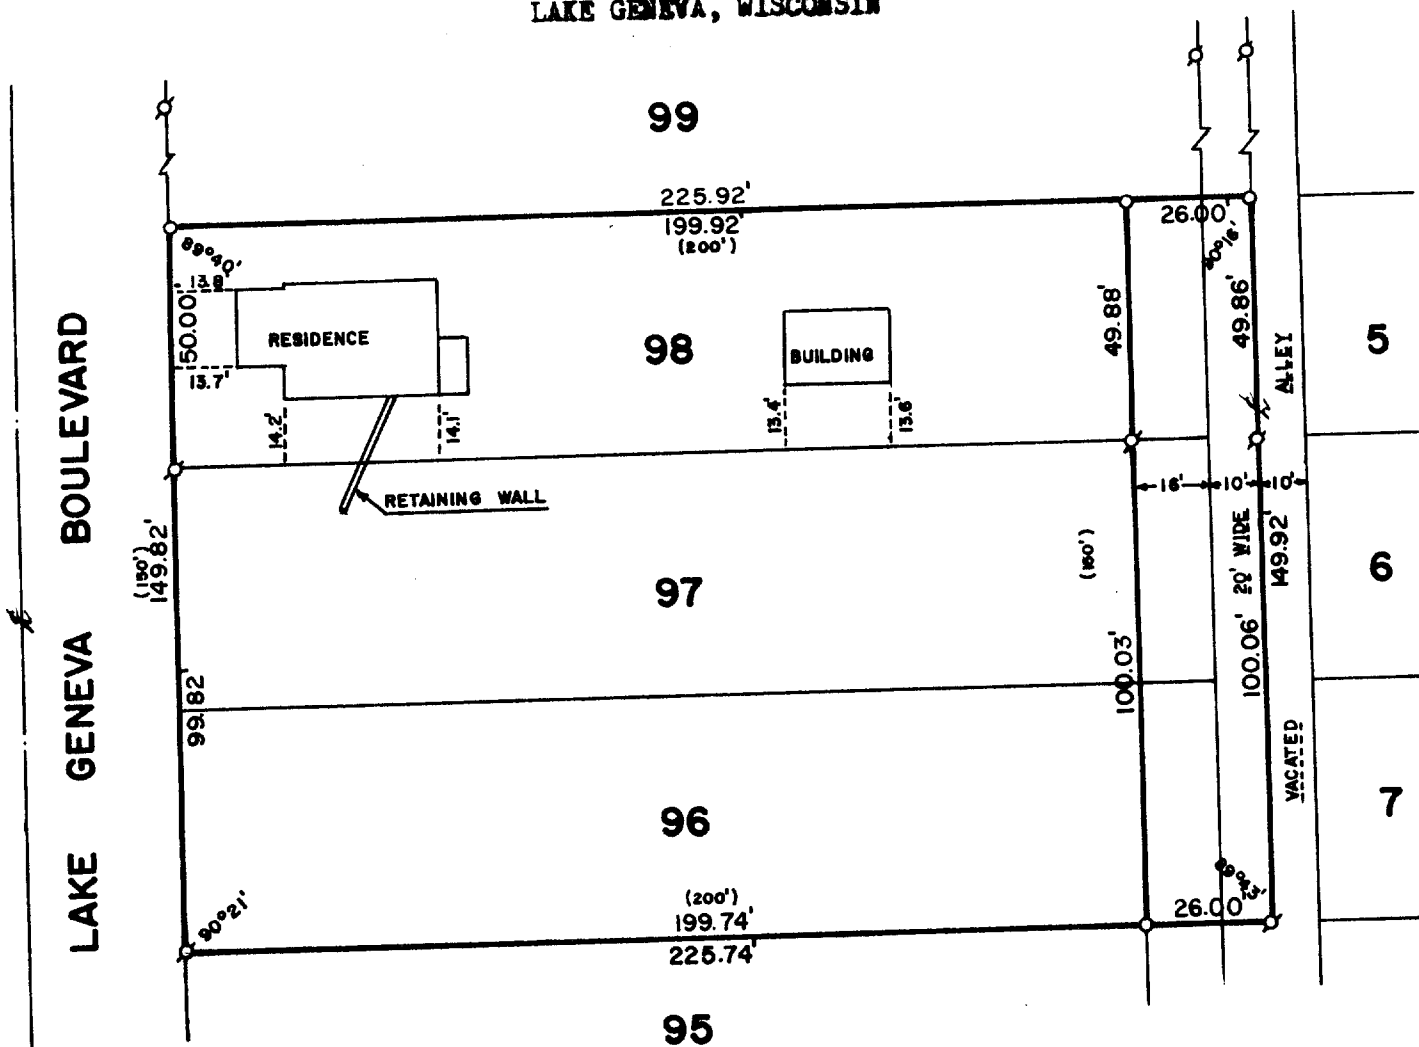

PLAT OF SURVEY OF

LOTS 96, 97, 98 AND PART OF A VACATED ALLEY ALL  
LOCATED IN BOULEVARD SUBDIVISION, SECTION 1,  
T 1 N, R 17 E, CITY OF LAKE GENEVA, WALWORTH  
COUNTY, WISCONSIN.

ORDERED BY: STURG TAGGART AGENCY  
736 MAIN STREET  
LAKE GENEVA, WISCONSIN

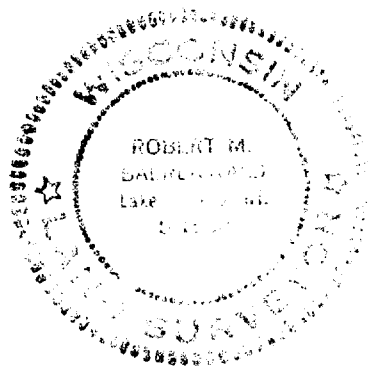

SCALE: 1"=40'

- ⊕ - IRON PIPE FOUND
- - IRON PIPE PLACED
- ( ) - RECORDED AS

I, ROBERT M. BAERENWALD, DO HEREBY CERTIFY  
THAT I HAVE SURVEYED THE PROPERTY HEREON  
DESCRIBED ACCORDING TO THE OFFICIAL RECORDS  
AND THAT THE PLAT HEREON IS A CORRECT  
REPRESENTATION OF THE PROPERTY LINES TO THE  
BEST OF MY KNOWLEDGE AND BELIEF.

*Robert M. Baerenwald*  
ROBERT M. BAERENWALD  
WISCONSIN REGISTERED LAND SUEVEYOR, S-1508

*January 22, 1984*  
DATE

JOB NO. 0018