


N

 SCALE 1"=20'
 0=IRON PIPE

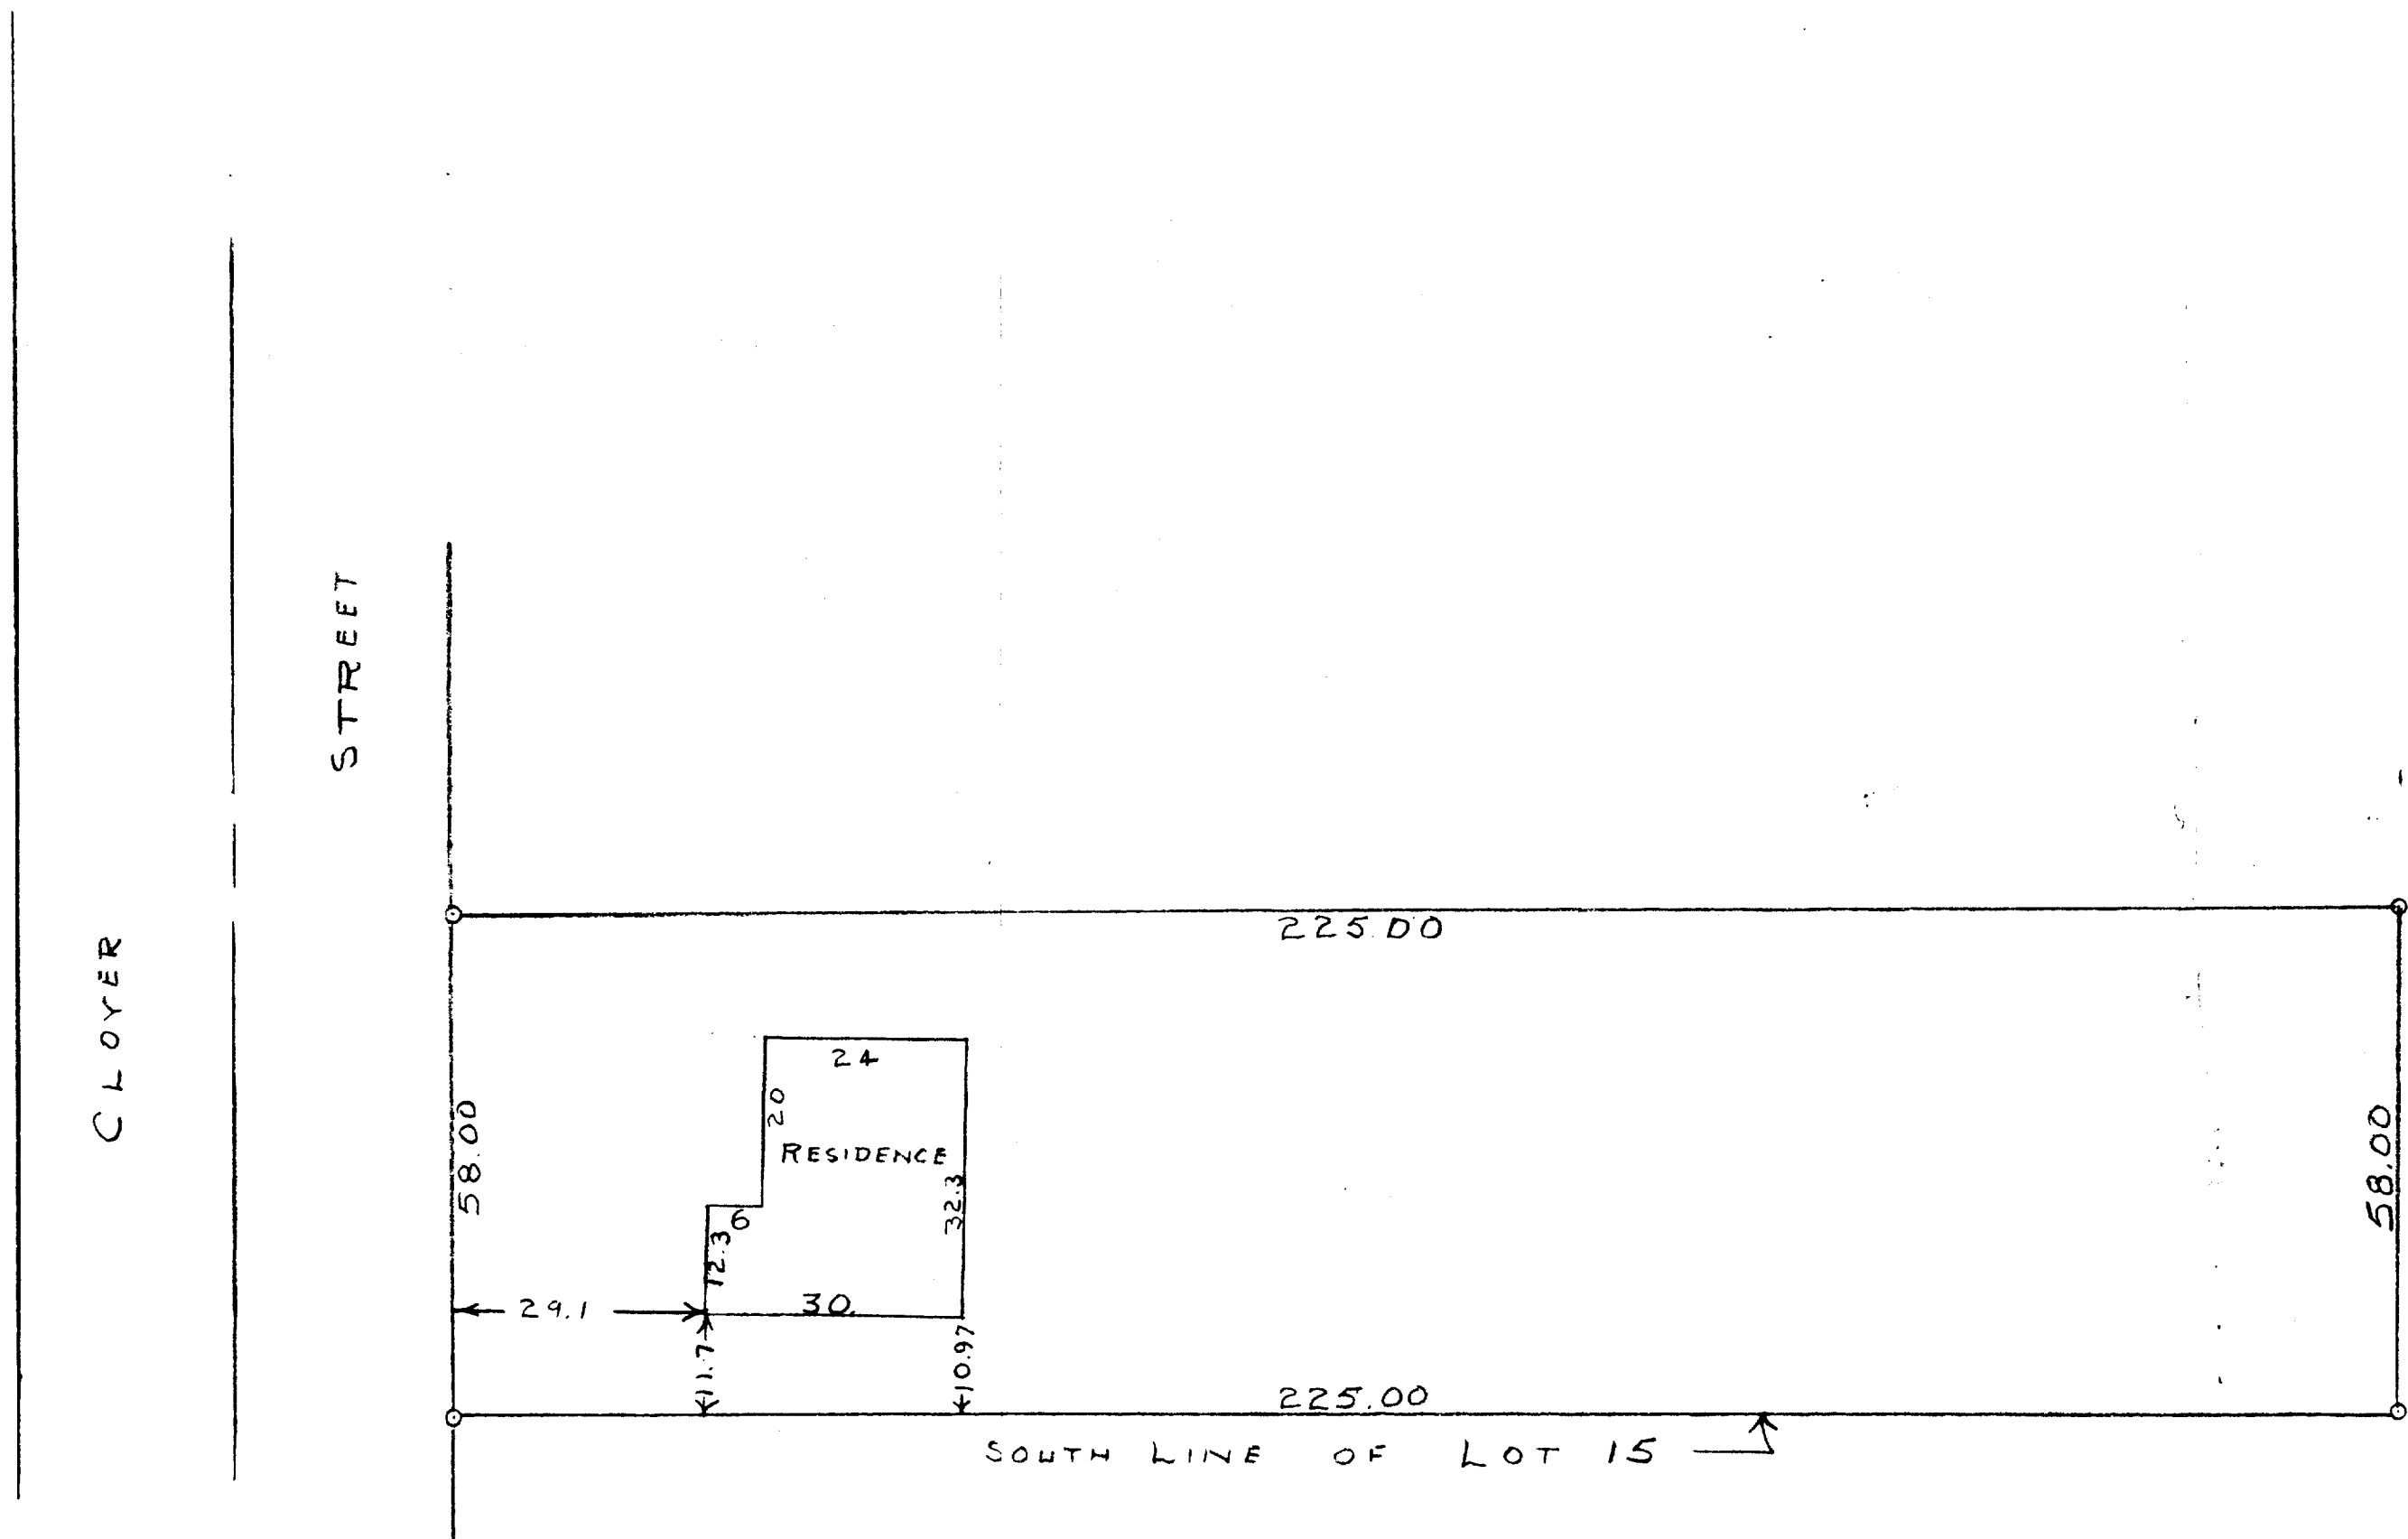

STATE OF WISCONSIN)
 COUNTY OF WALWORTH)

I, GEORGE T. DUNHAM DO HEREBY CERTIFY THAT I HAVE SURVEYED
 THE PROPERTY DESCRIBED AS FOLLOWS:

THE SOUTH 58.00 FEET OF THE WEST 225.00 FEET OF LOT 15 OF
 SECOND COLUMBIAN SUBDIVISION, CITY OF LAKE GENEVA
 WALWORTH COUNTY, WISCONSIN

AND THAT THE PLAT SHOWN ABOVE IS A CORRECT REPRESENTATION OF THE
 PROPERTY LINES AND THE LOCATION OF THE RESIDENCE.
 JUNE 13, 1956


 GEORGE T. DUNHAM, SURVEYOR
 DELAWARE, WISCONSIN