


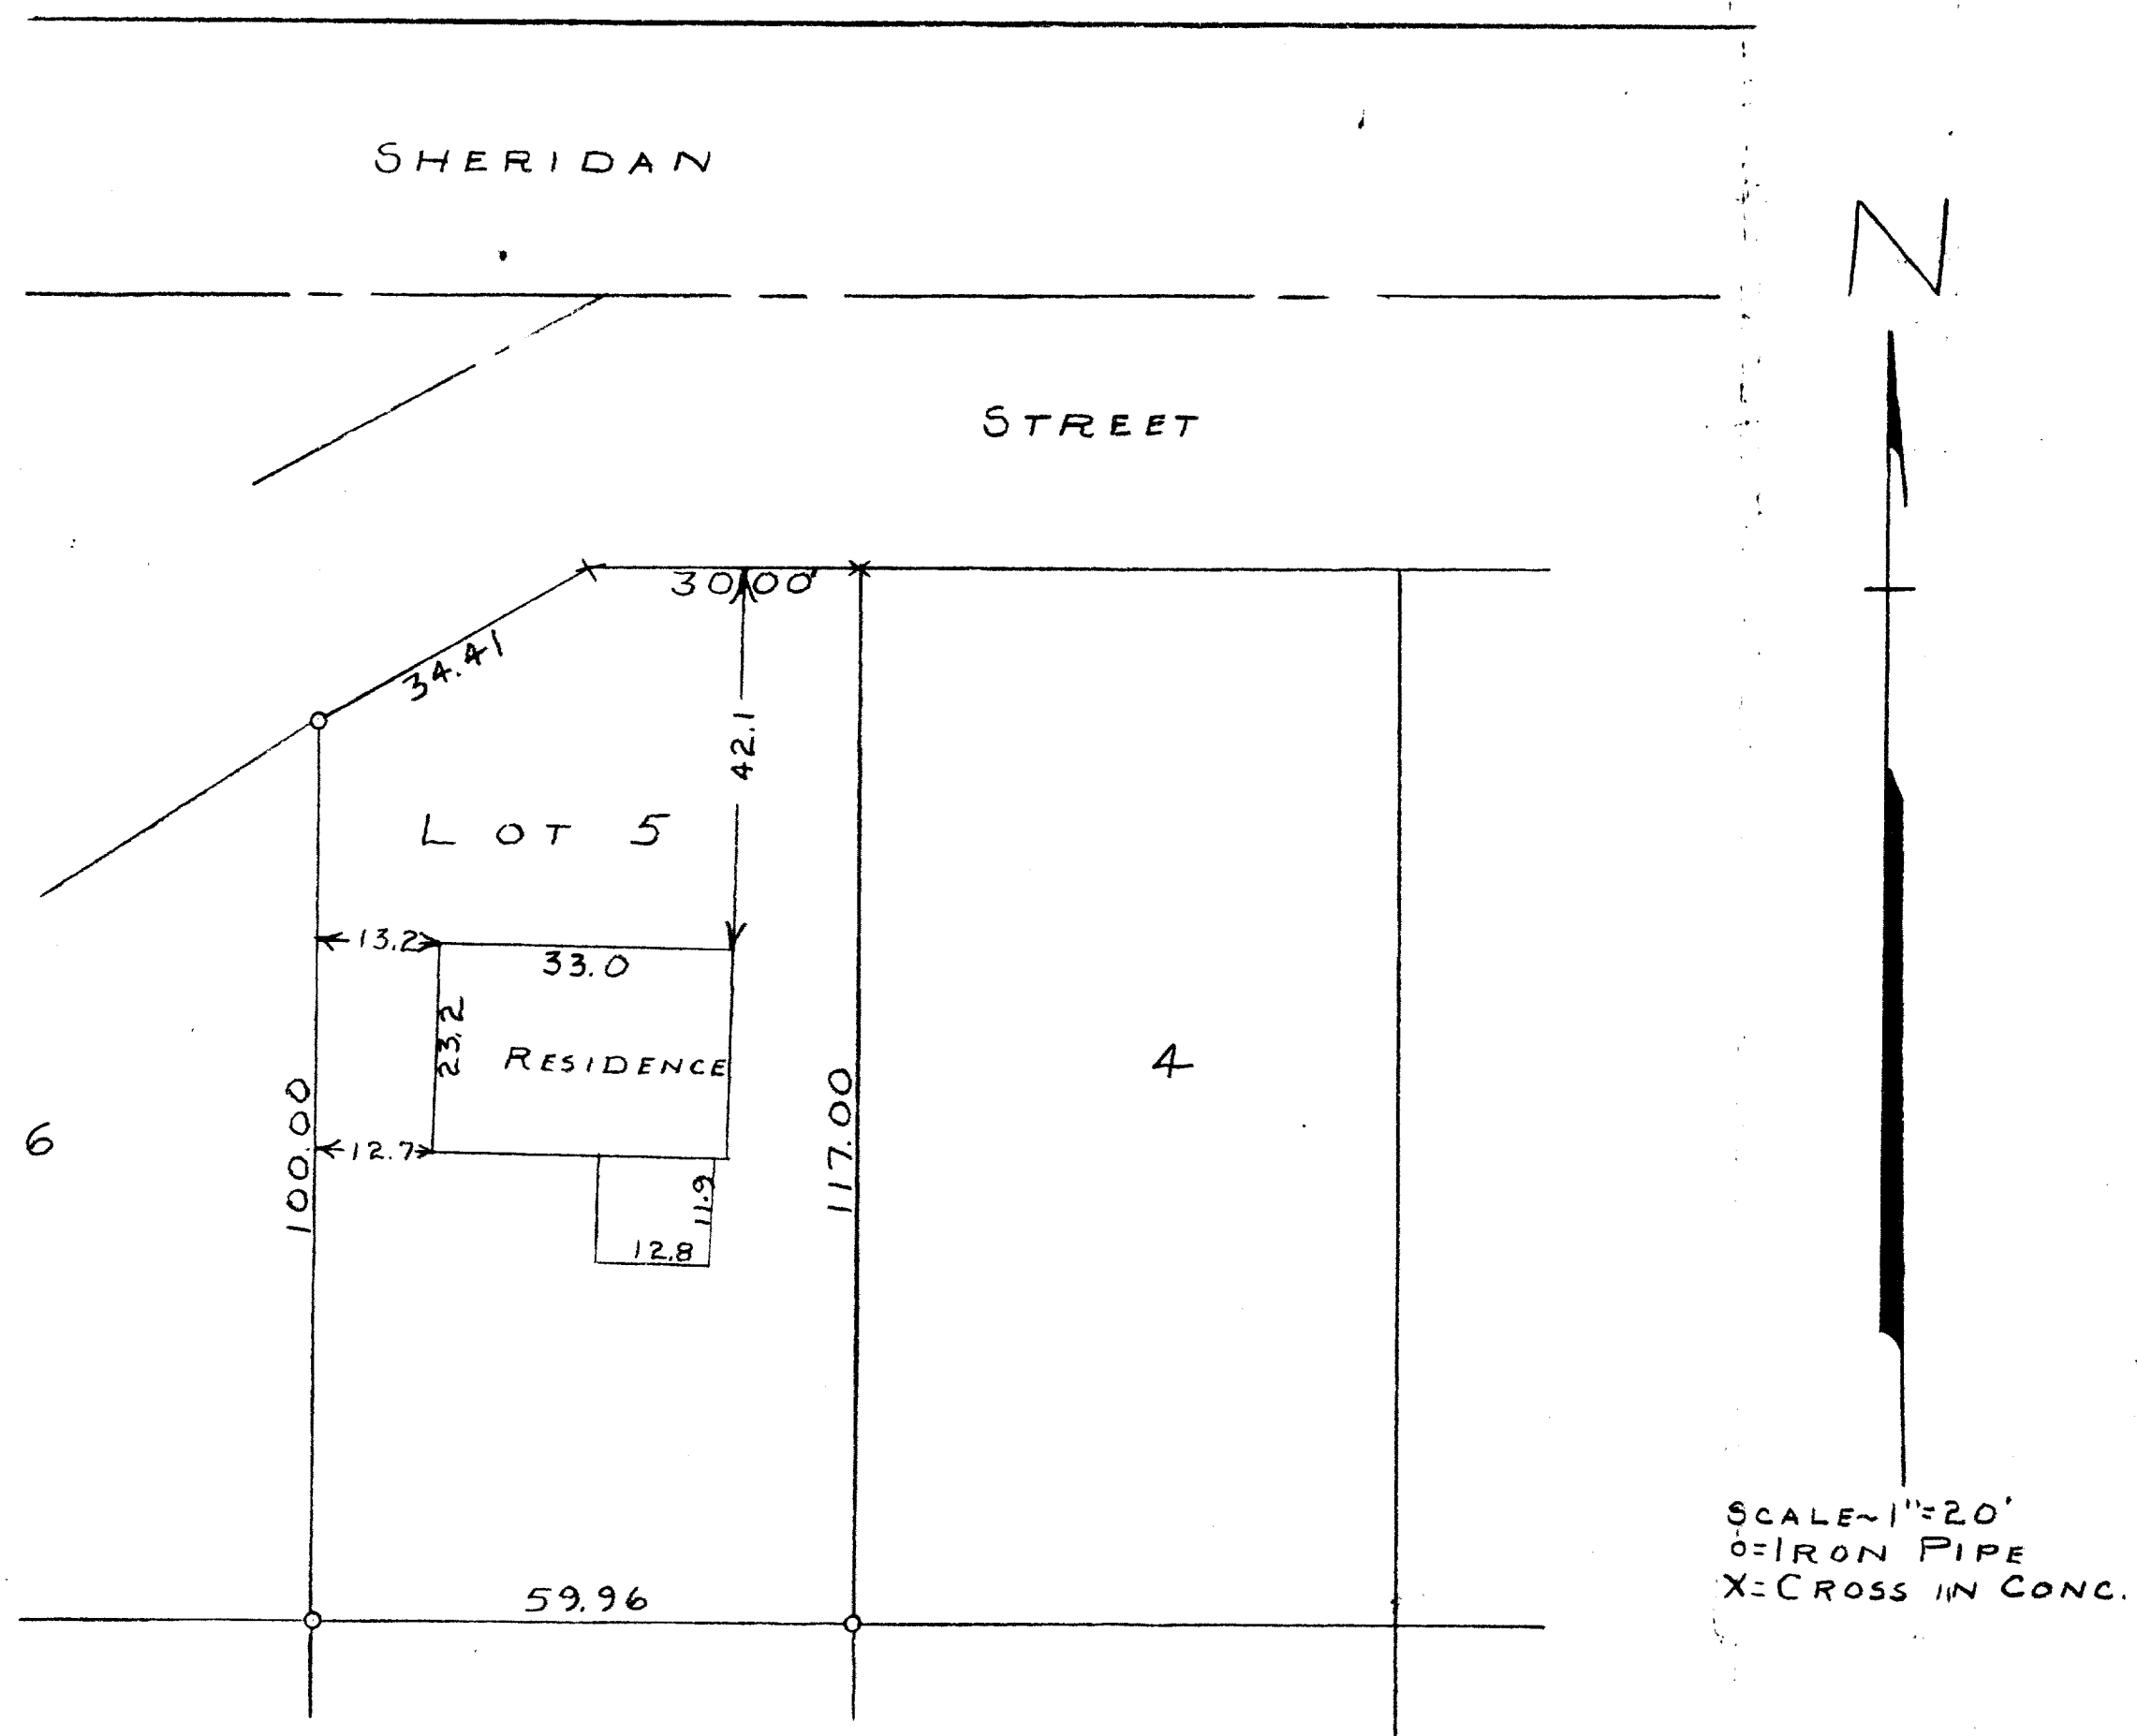

STATE OF WISCONSIN)
COUNTY OF WALWORTH)

I, GEORGE T. DUNHAM, DO HEREBY CERTIFY THAT I HAVE SURVEYED
THE PROPERTY DESCRIBED AS FOLLOWS:

LOT 5, BLOCK 1 OF WARHURSTS SUBDIVISION LOCATED IN THE
CITY OF LAKE GENEVA, WALWORTH COUNTY, WISCONSIN
AND THAT THE PLAT SHOWN ABOVE IS A CORRECT REPRESENTATION OF
THE PROPERTY LINES
JANUARY 24, 1956

George T. Dunham
GEORGE T. DUNHAM, SURVEYOR
DELAVER, WISCONSIN