


DUNHAM & RASMUSSEN
SURVEYING & ENGINEERING
DELAWARE, WISCONSIN

WILLIAM STREET
U. S. HIGHWAY 20. 12 & STATE TRUNK HIGHWAY NO. 36

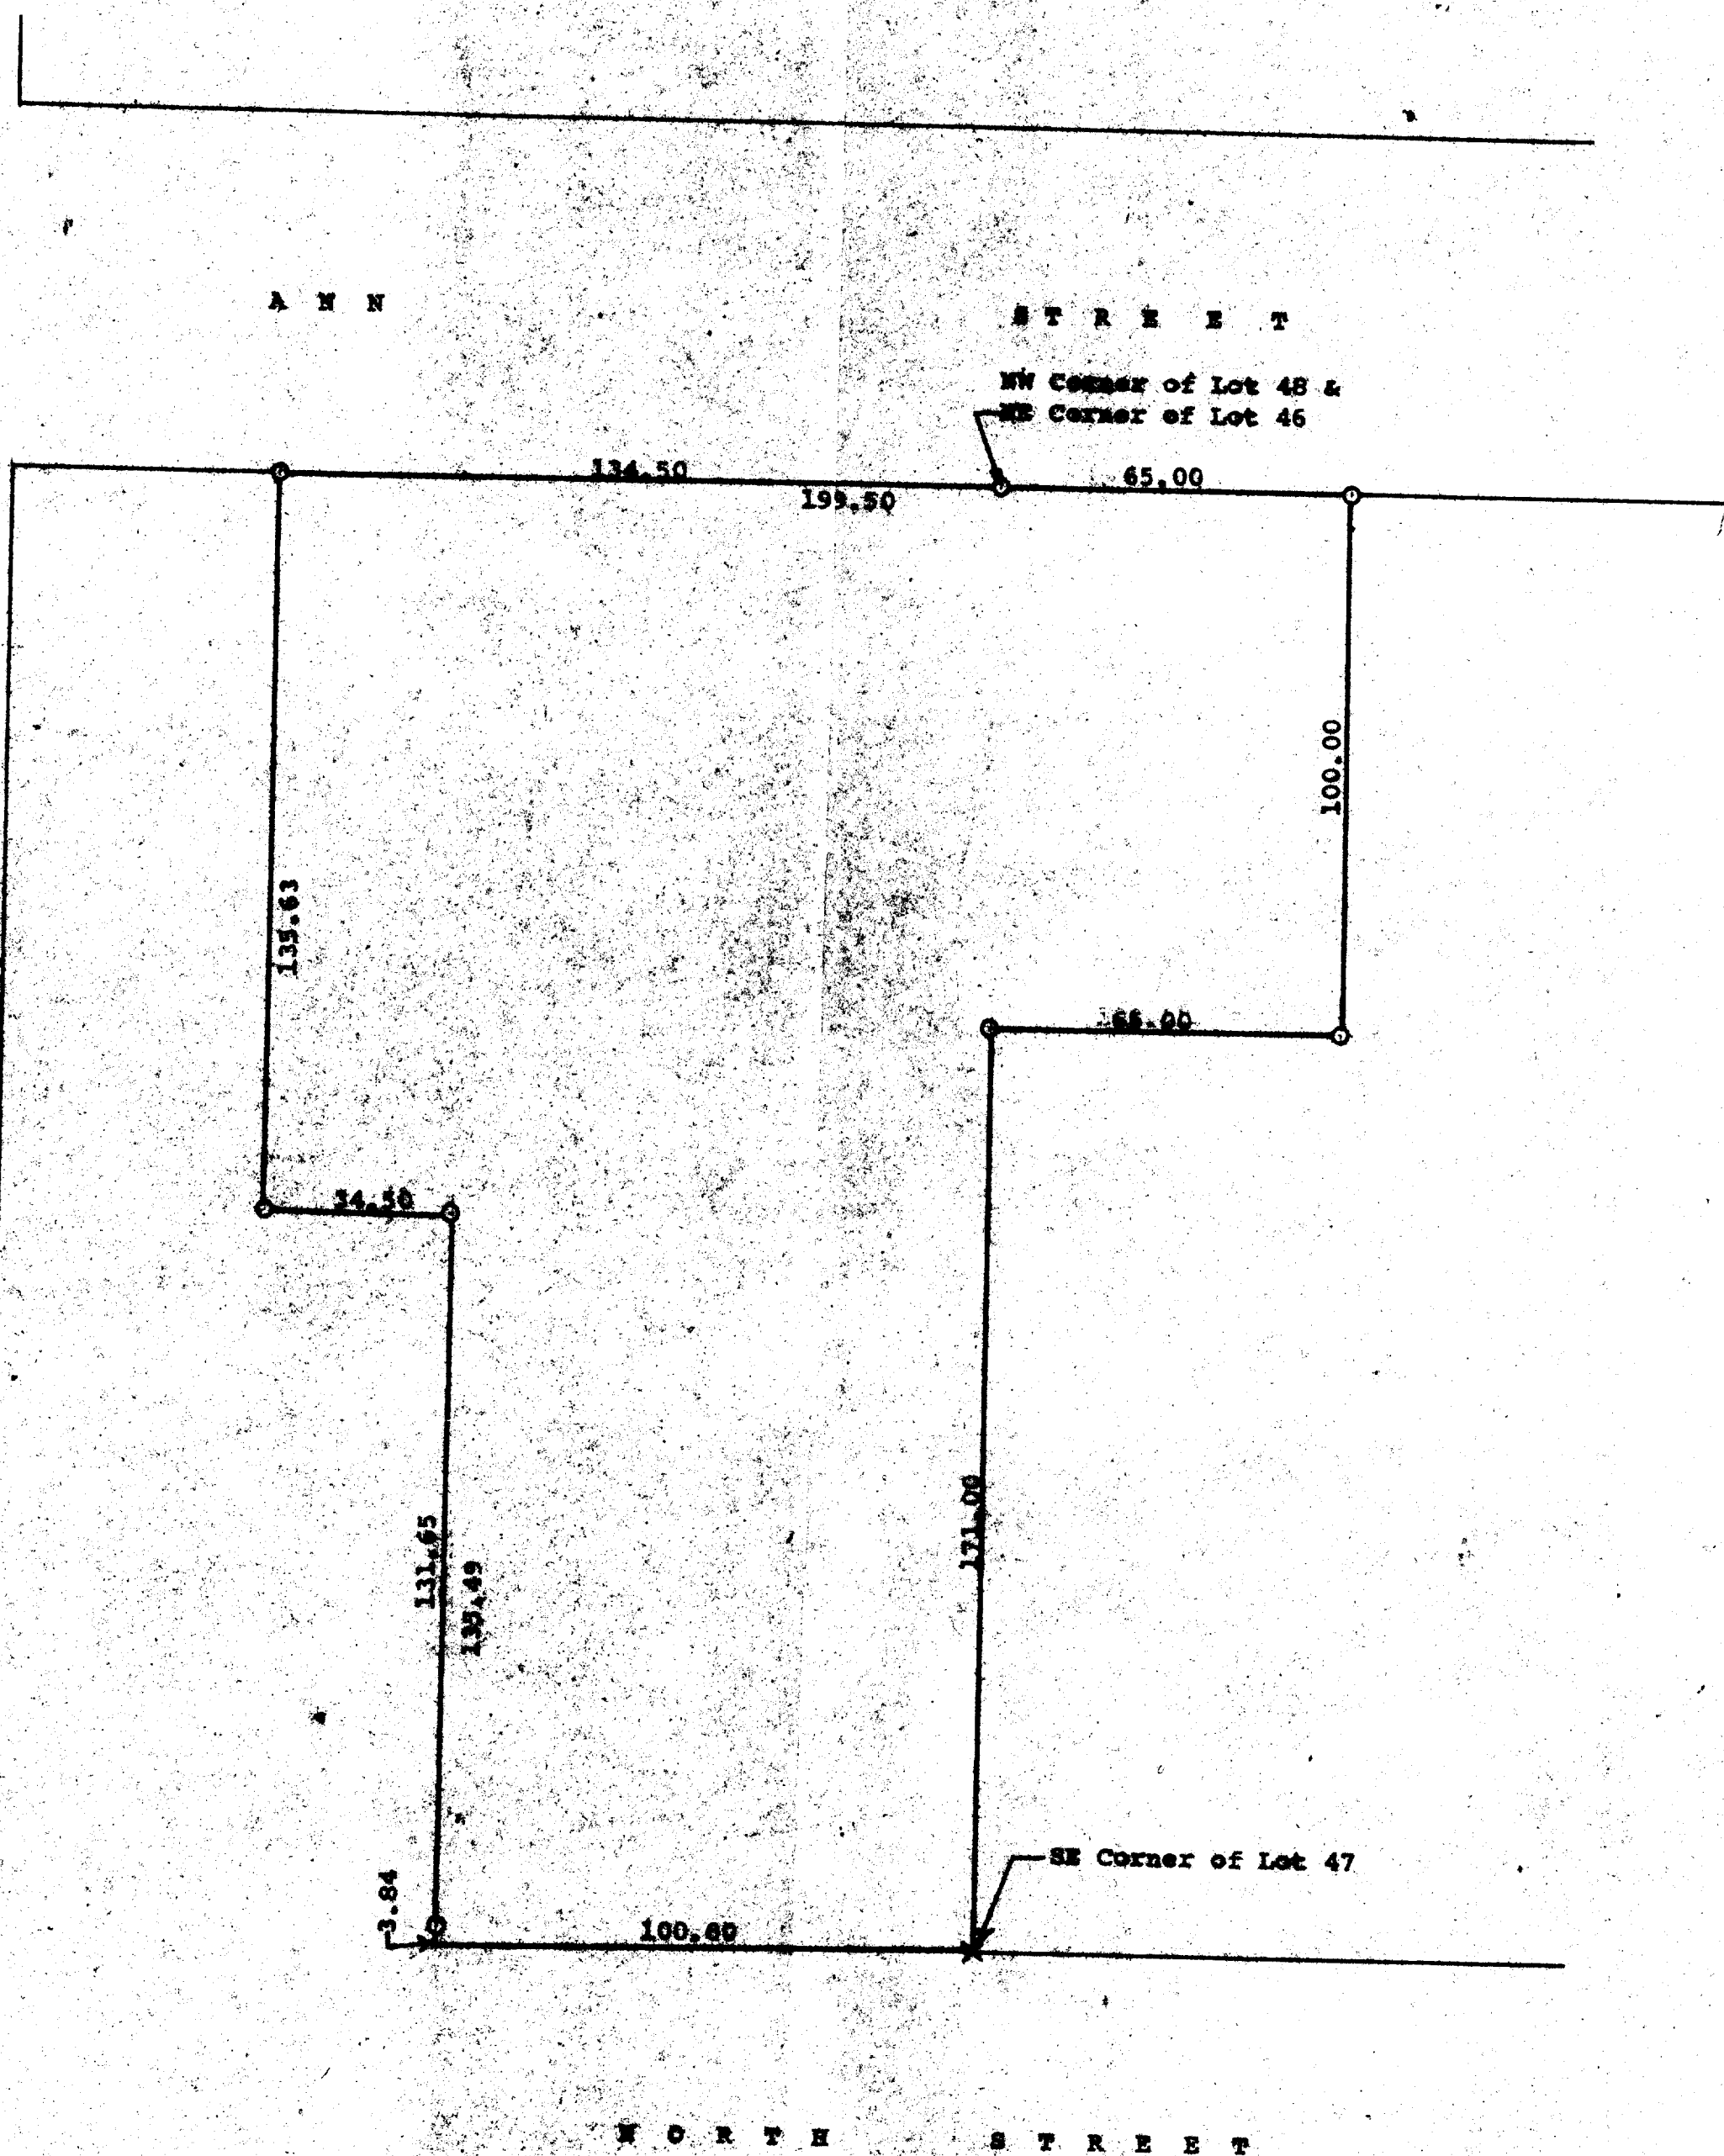

Scale - 1" = 30'
O = Iron Pipe
X = Cross in Concrete

Plat of survey of a parcel of land located in Lots 46, 47, and 48 of
Ferguson's Addition to the Village of Geneva, New City of Lake Geneva,
Walworth County, Wisconsin.
April 27, 1962

George T. Dunham
George T. Dunham, Surveyor