

PLAT OF SURVEY
OF

LOTS 1, 2, 3 & 4 IN DUN ROMIN ACRES, A SUBDIVISION
LOCATED IN SECTION 6, T. 1 N., R. 18 E. OF THE 4th
P.M., CITY OF LAKE GENEVA, WALWORTH COUNTY, WI.


FOR: ASTOR PARTNERSHIP

SCALE 1" = 40'

⚡ = IRON PIPE STAKE FOUND

BEARINGS ARE THOSE
OF RECORDED PLAT.

✕ = SOLID IRON STAKE FOUND.

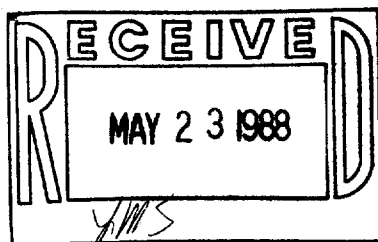


I have surveyed the above-described property,
and the map hereon is a true representation
thereof and shows the size and location of the
property, its exterior boundaries, the location
and dimensions of all visible structures thereon,
fences, apparent easements and roadways and
visible encroachments, if any.

This survey is made for the exclusive use of
the present owners of the property, and also
those who purchase, mortgage, or guarantee
the title thereto, within one year from date
hereof.

Done at Burlington, this 16th day
of MARCH, 1988

John F. Degen
John F. Degen, Land Surveyor S 242

MOBILE ST.

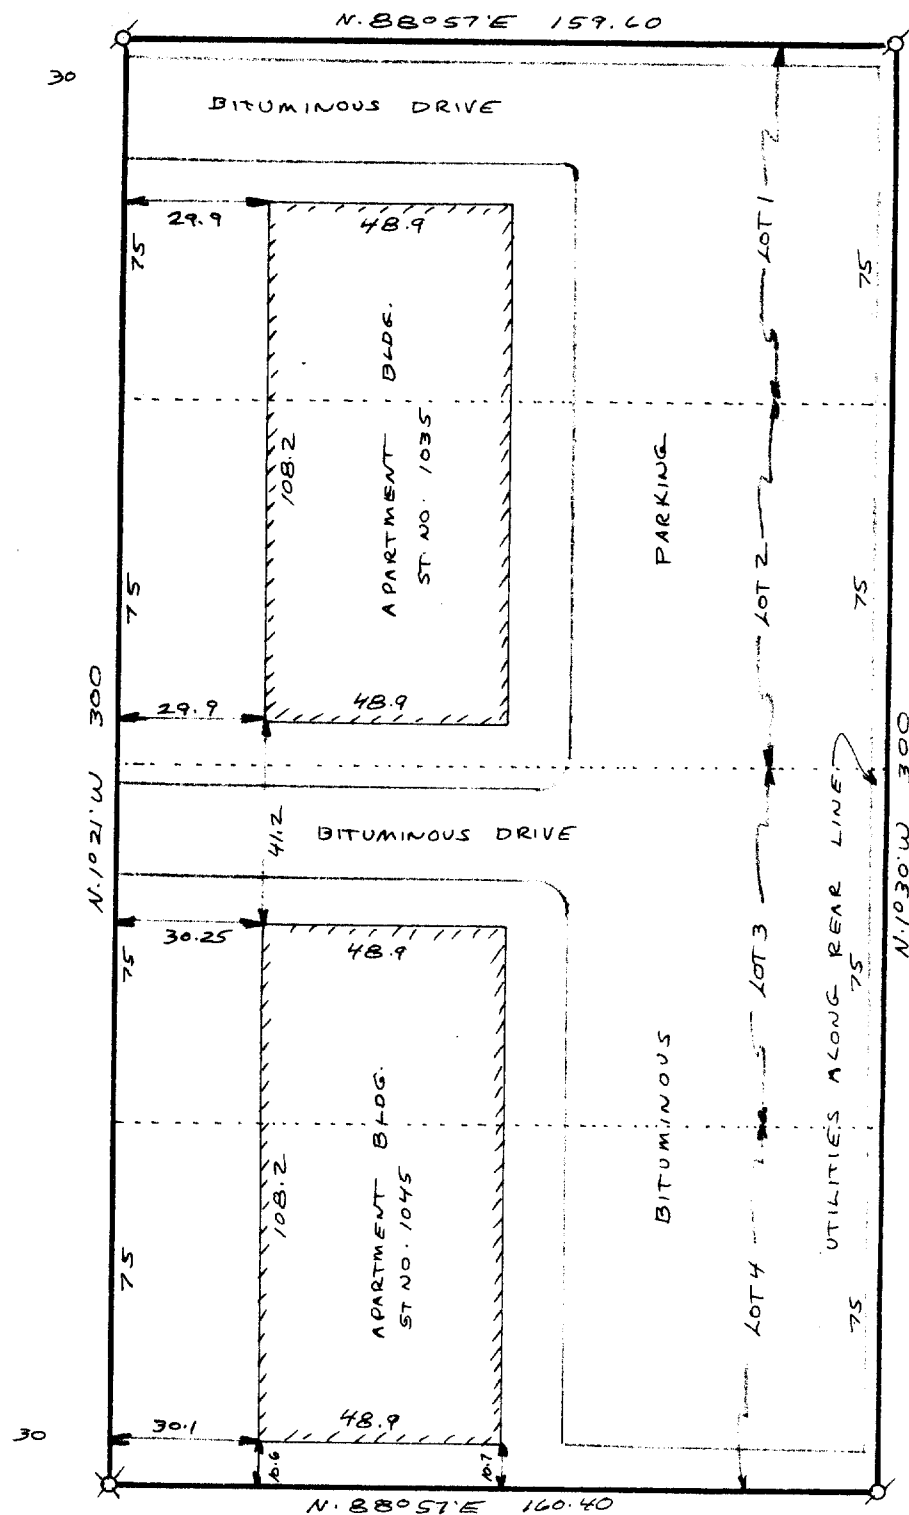

7-1021