



200-62

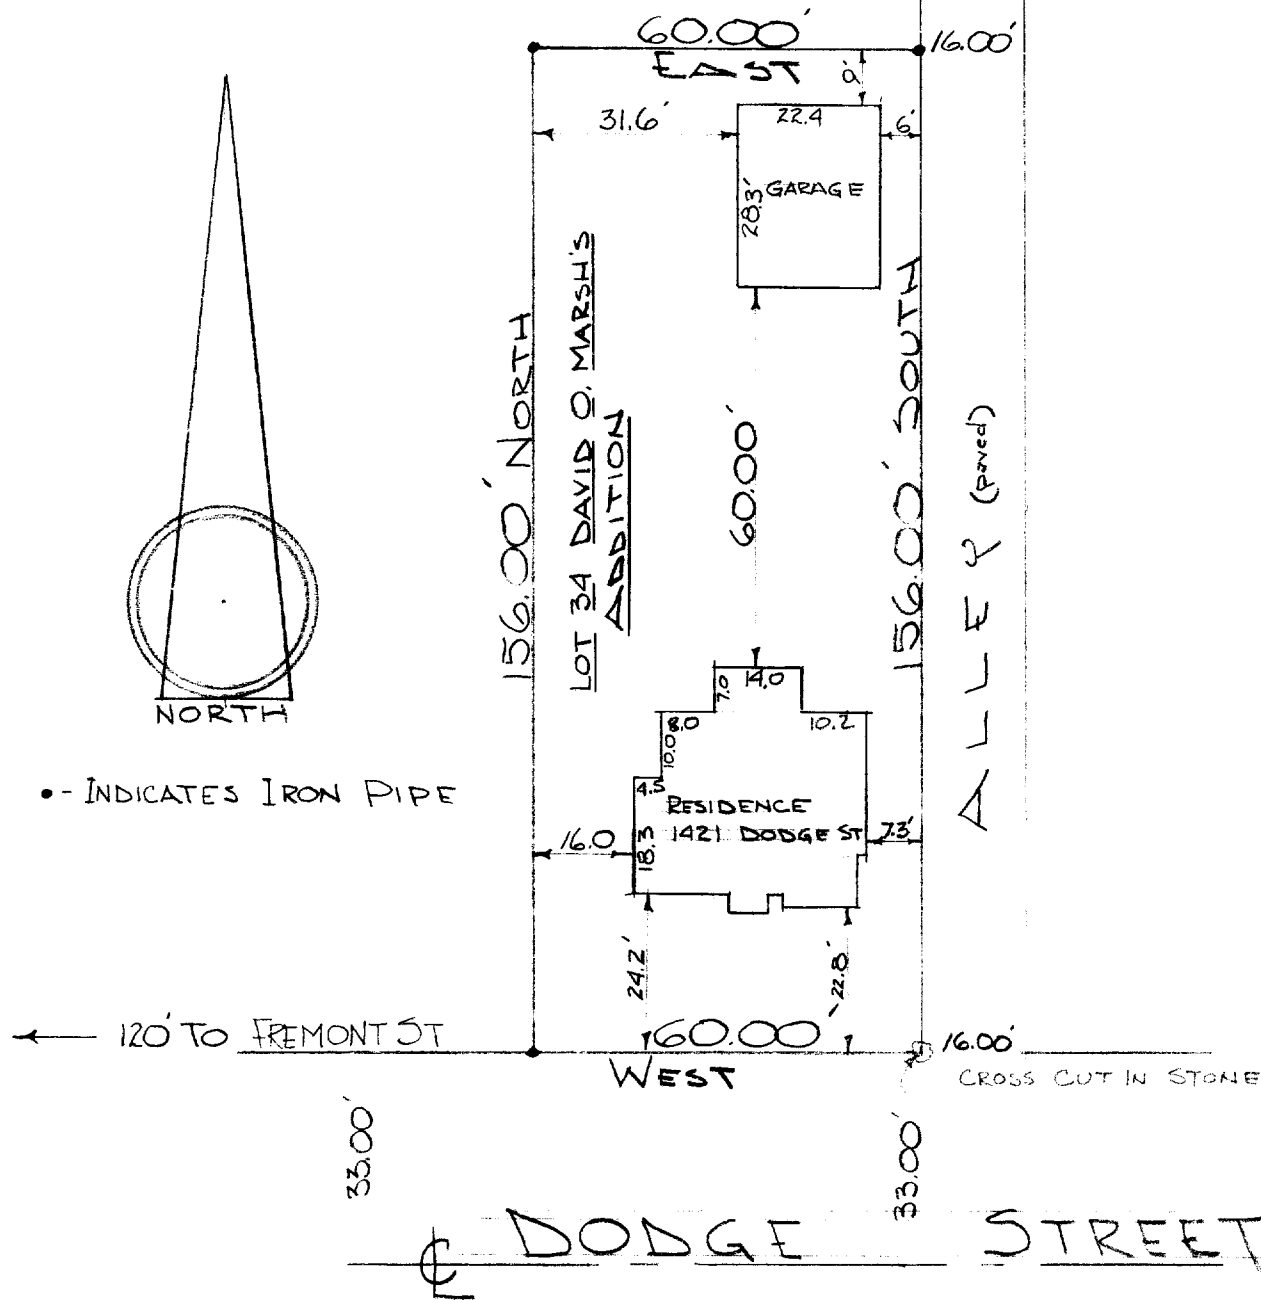

DESCRIPTION: Lot 34 of David O. Marsh Addition to the City of Lake Geneva, Walworth County, Wisconsin.

CERTIFICATE: I, James F. Biagi, surveyor, do hereby certify that I have surveyed the property hereon described, and that the location of all the improvements are as shown on the drawing above.

SEPTEMBER 11, 1962.

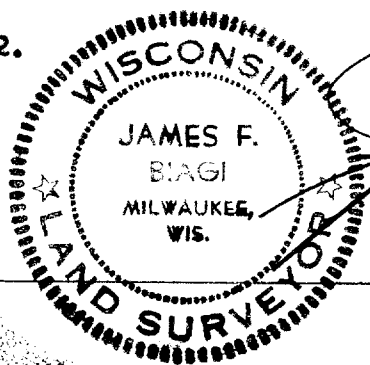

James F. Biagi
James F. Biagi, RLS 272