


GEORGE T. DUNHAM
SURVEYING & SUBDIVIDING
DELAVER, WISCONSIN

W A L W O R T H

S T R E E T

N

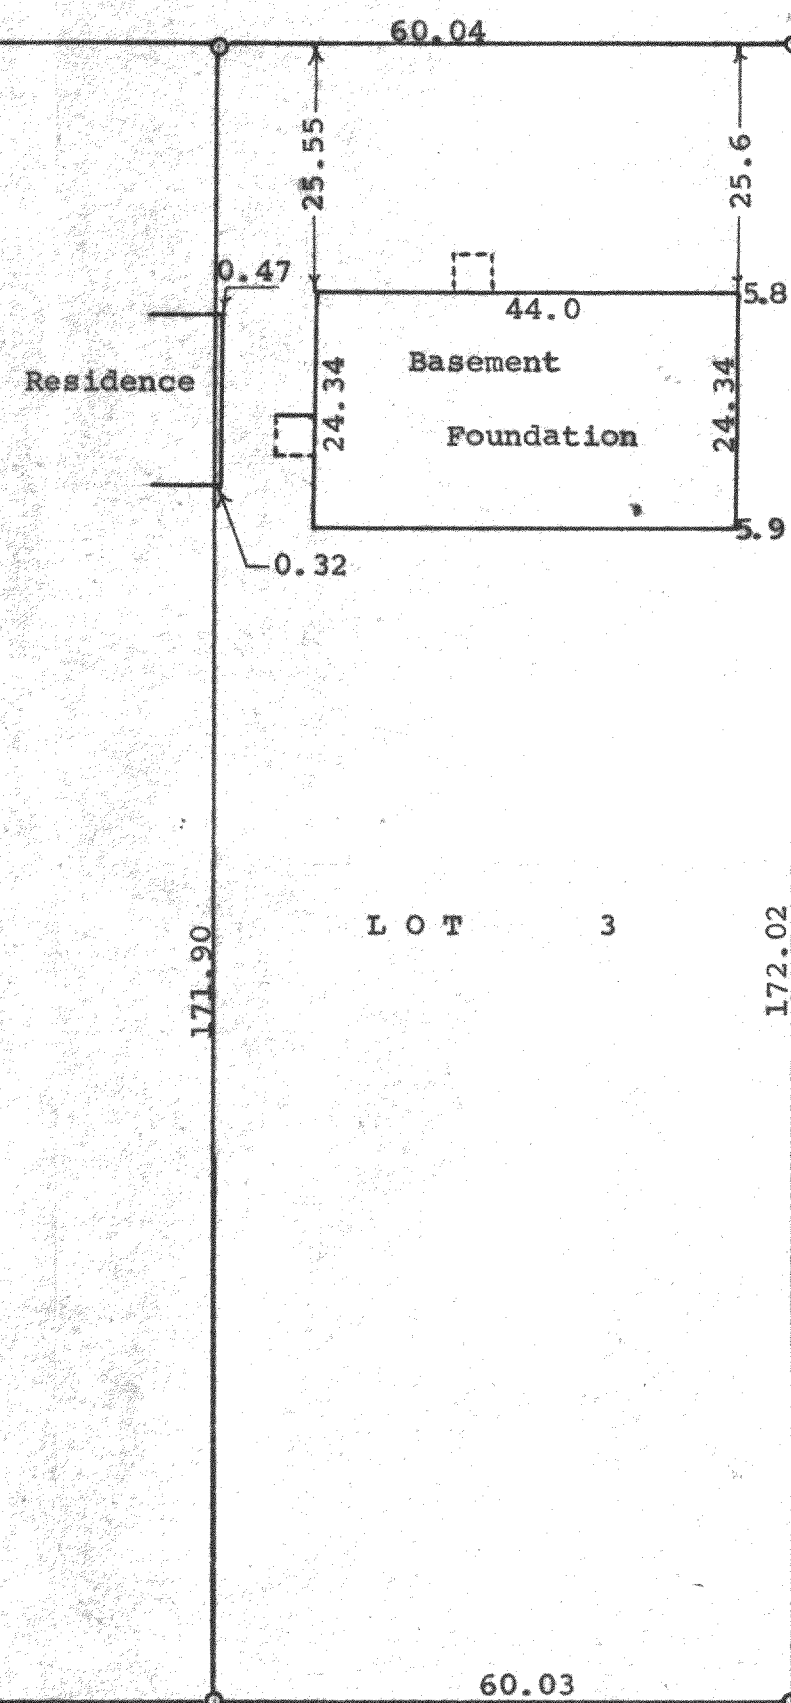

Scale - 1" = 20'
O = Iron Pipe

L O T 3

A L L E Y

STATE OF WISCONSIN)
WALWORTH COUNTY) SS

I, George T. Dunham, do hereby certify that I have surveyed the property described as follows,
Lot 3, Block 23 of Geneva Lake Crawford Mfg Co's
Addition to Geneva located in the City of Lake Geneva,
Walworth County, Wisconsin
and that the above plat is an accurate survey and a true representation thereof and correctly shows the exterior boundary lines and other improvements on said property and the correct measurements thereof.
May 27, 1963

George T. Dunham
George T. Dunham, Surveyor