


DESCRIPTION: Commencing at the southwest corner of Lot 4, Lake Geneva Villa Park Subdivision, located in the N. $\frac{1}{2}$ of Section 1, Town 1, north, Range 17 east, City of Lake Geneva, Walworth County, Wisconsin, thence N. $36^{\circ} 02' E.$, 137.75 feet, thence S. $81^{\circ} 22' E.$, 67.46 feet thence N. $80^{\circ} 45' E.$, 114.69 feet, thence South 121.15 feet, thence N. $89^{\circ} 40' W.$, 261.00 feet to the place of beginning.

CERTIFICATE: I, James F. Biagi, Surveyor, do hereby certify that I have surveyed the property hereon described and that the location of said property is as described.

April 1st 1963
Elkhorn, Wisconsin.

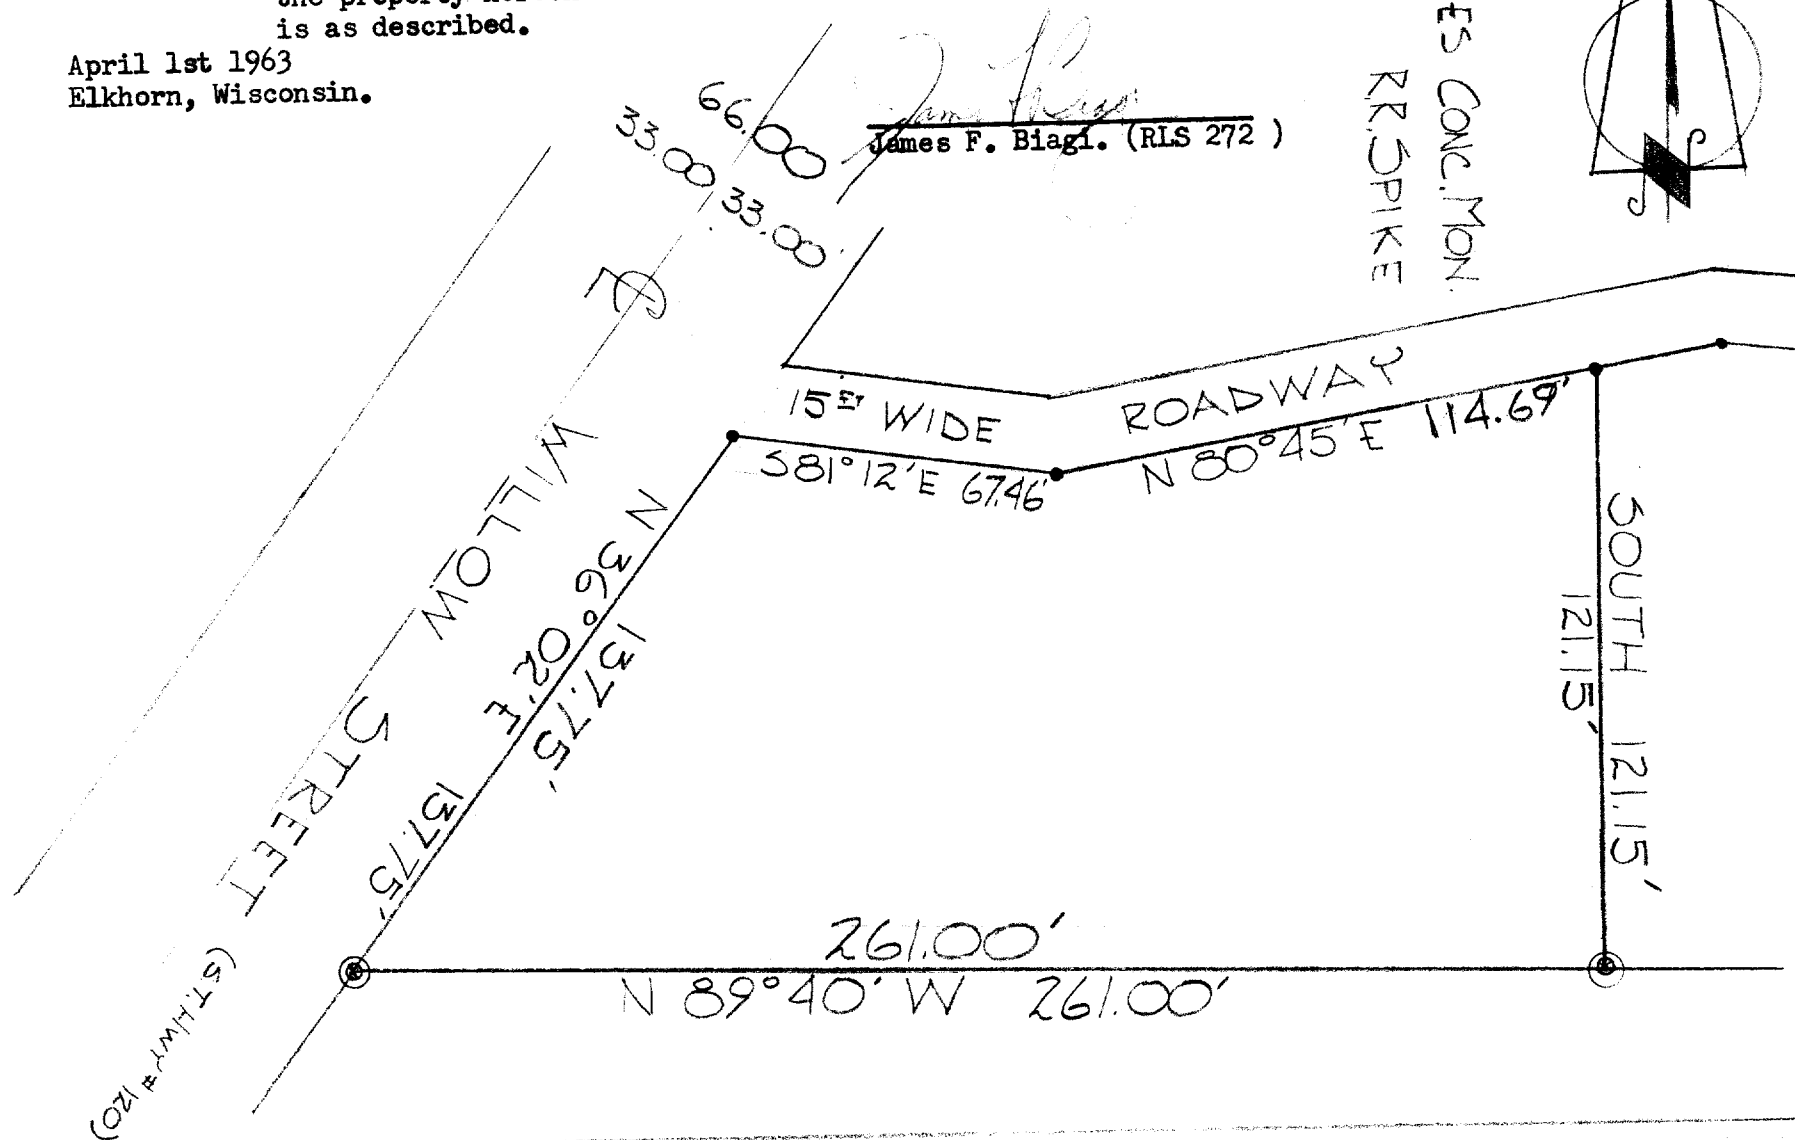

"B" - 32-63

LP-1C

7-105B