


GEORGE T. DUNHAM
SURVEYING & SUBDIVIDING
DELAVER, WISCONSIN

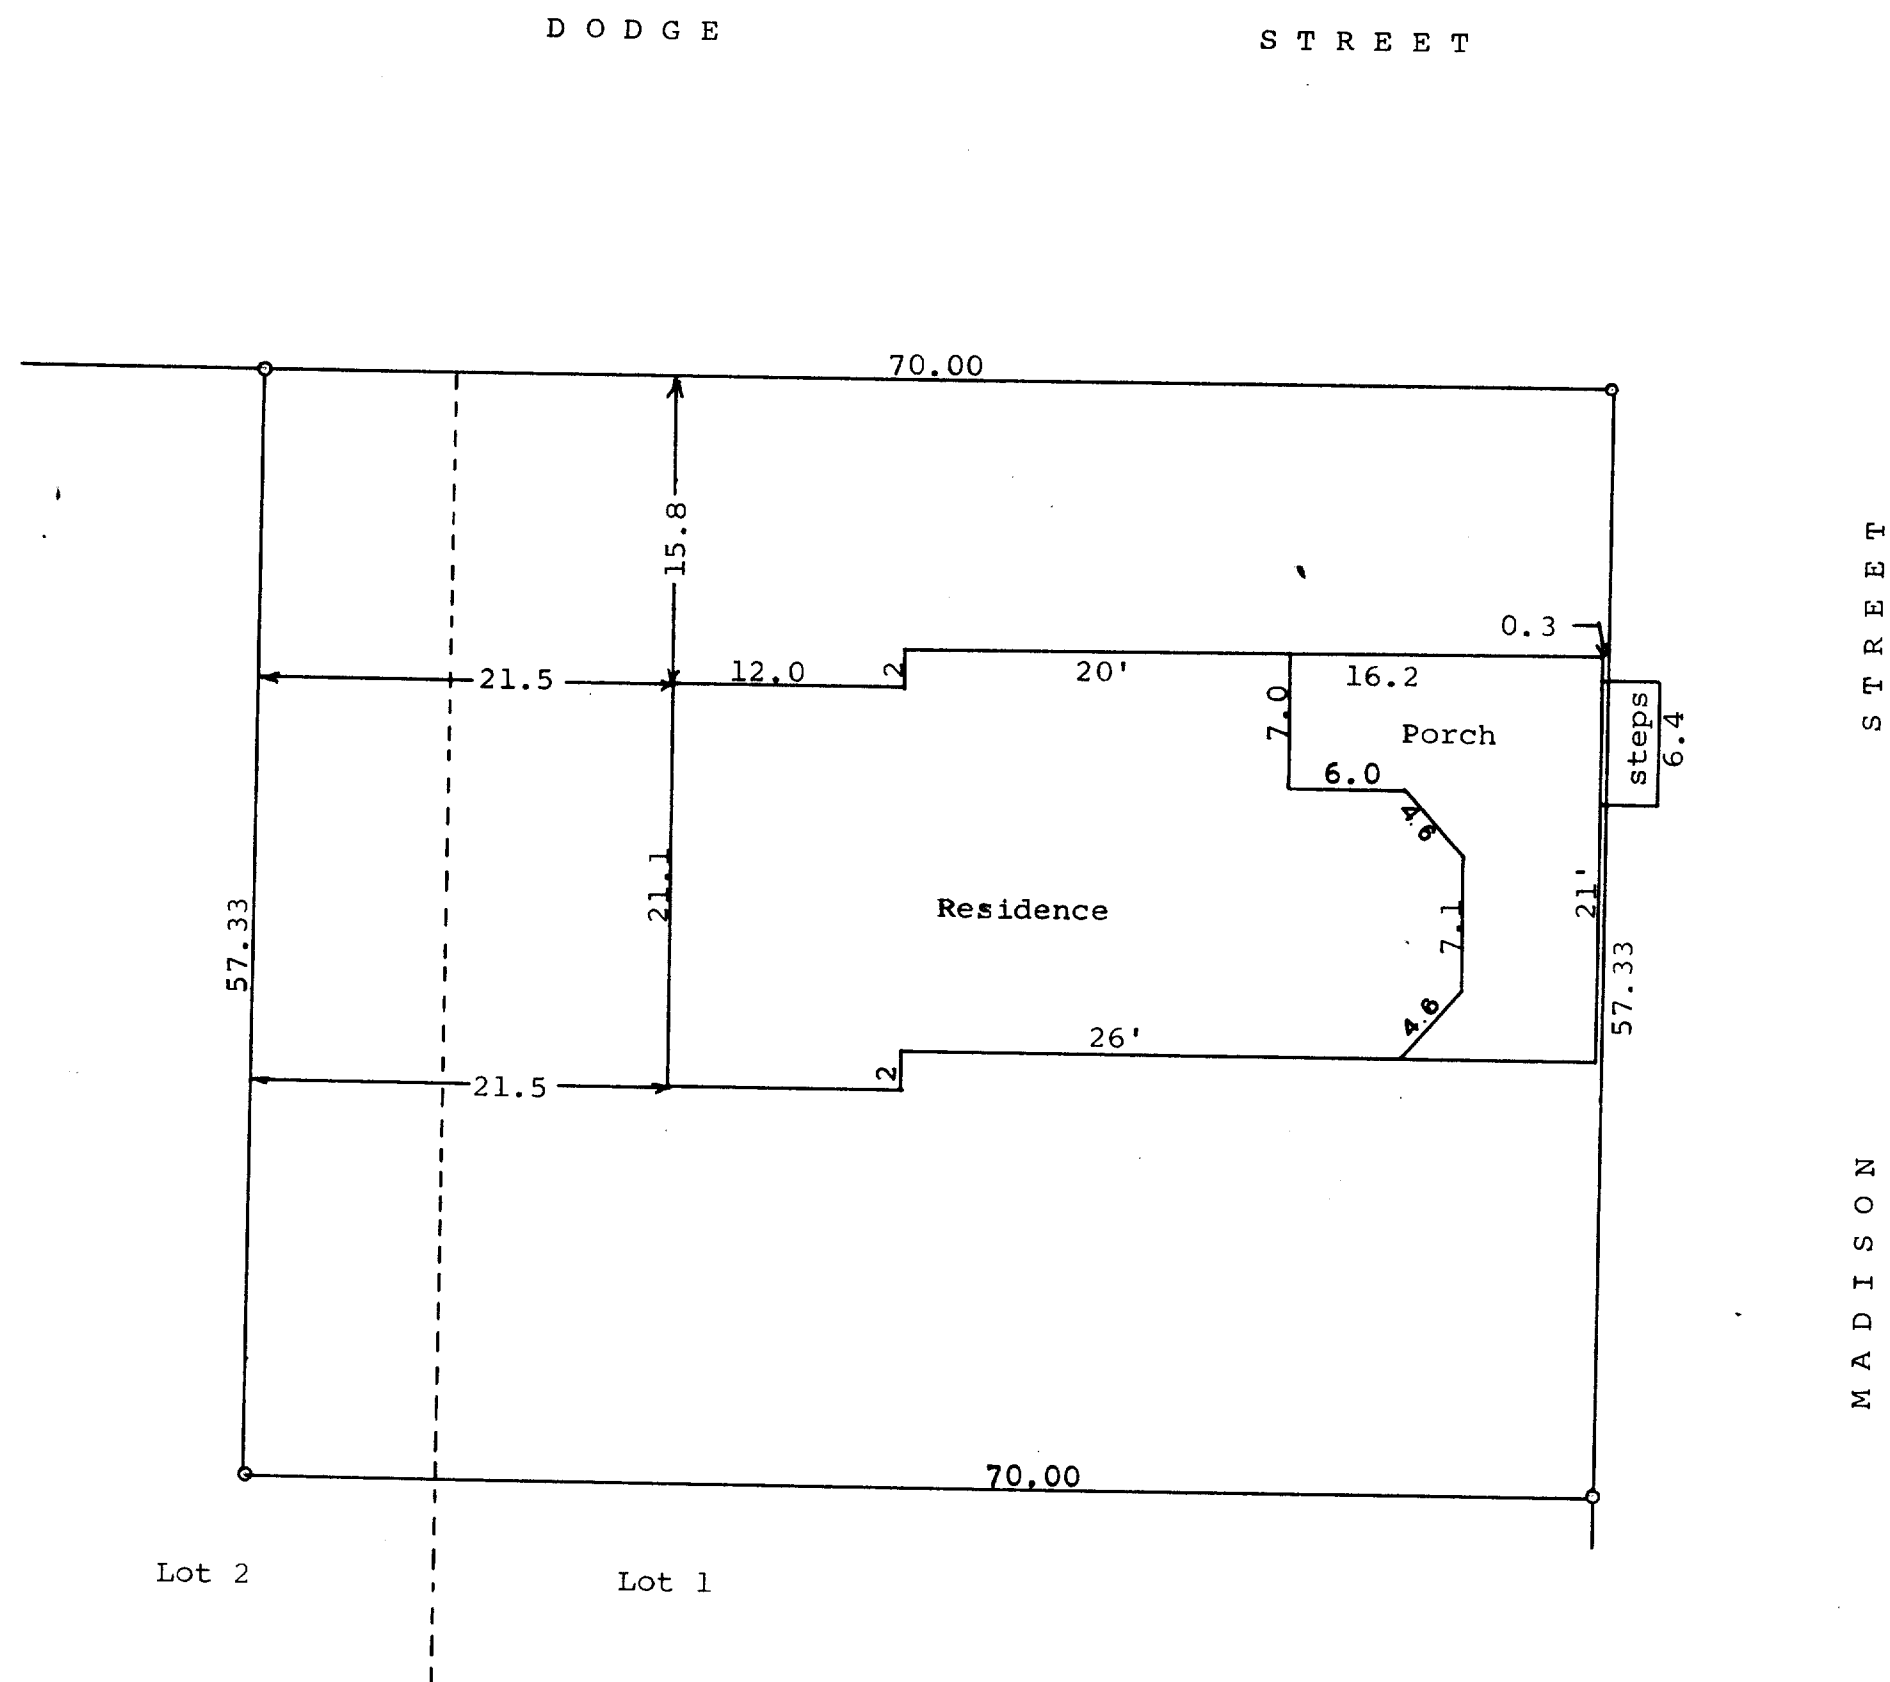

N

Scale - 1" = 10'
○ = Iron Pipe

Plat of survey of the East 70.00 feet of
the North 57.33 feet of Lots 1 and 2, Block
10, Original Plat of the City of Lake Geneva,
Walworth County, Wisconsin.
January 23, 1967

George T. Dunham
George T. Dunham, Surveyor

7-108

OP-71