


7-10 J

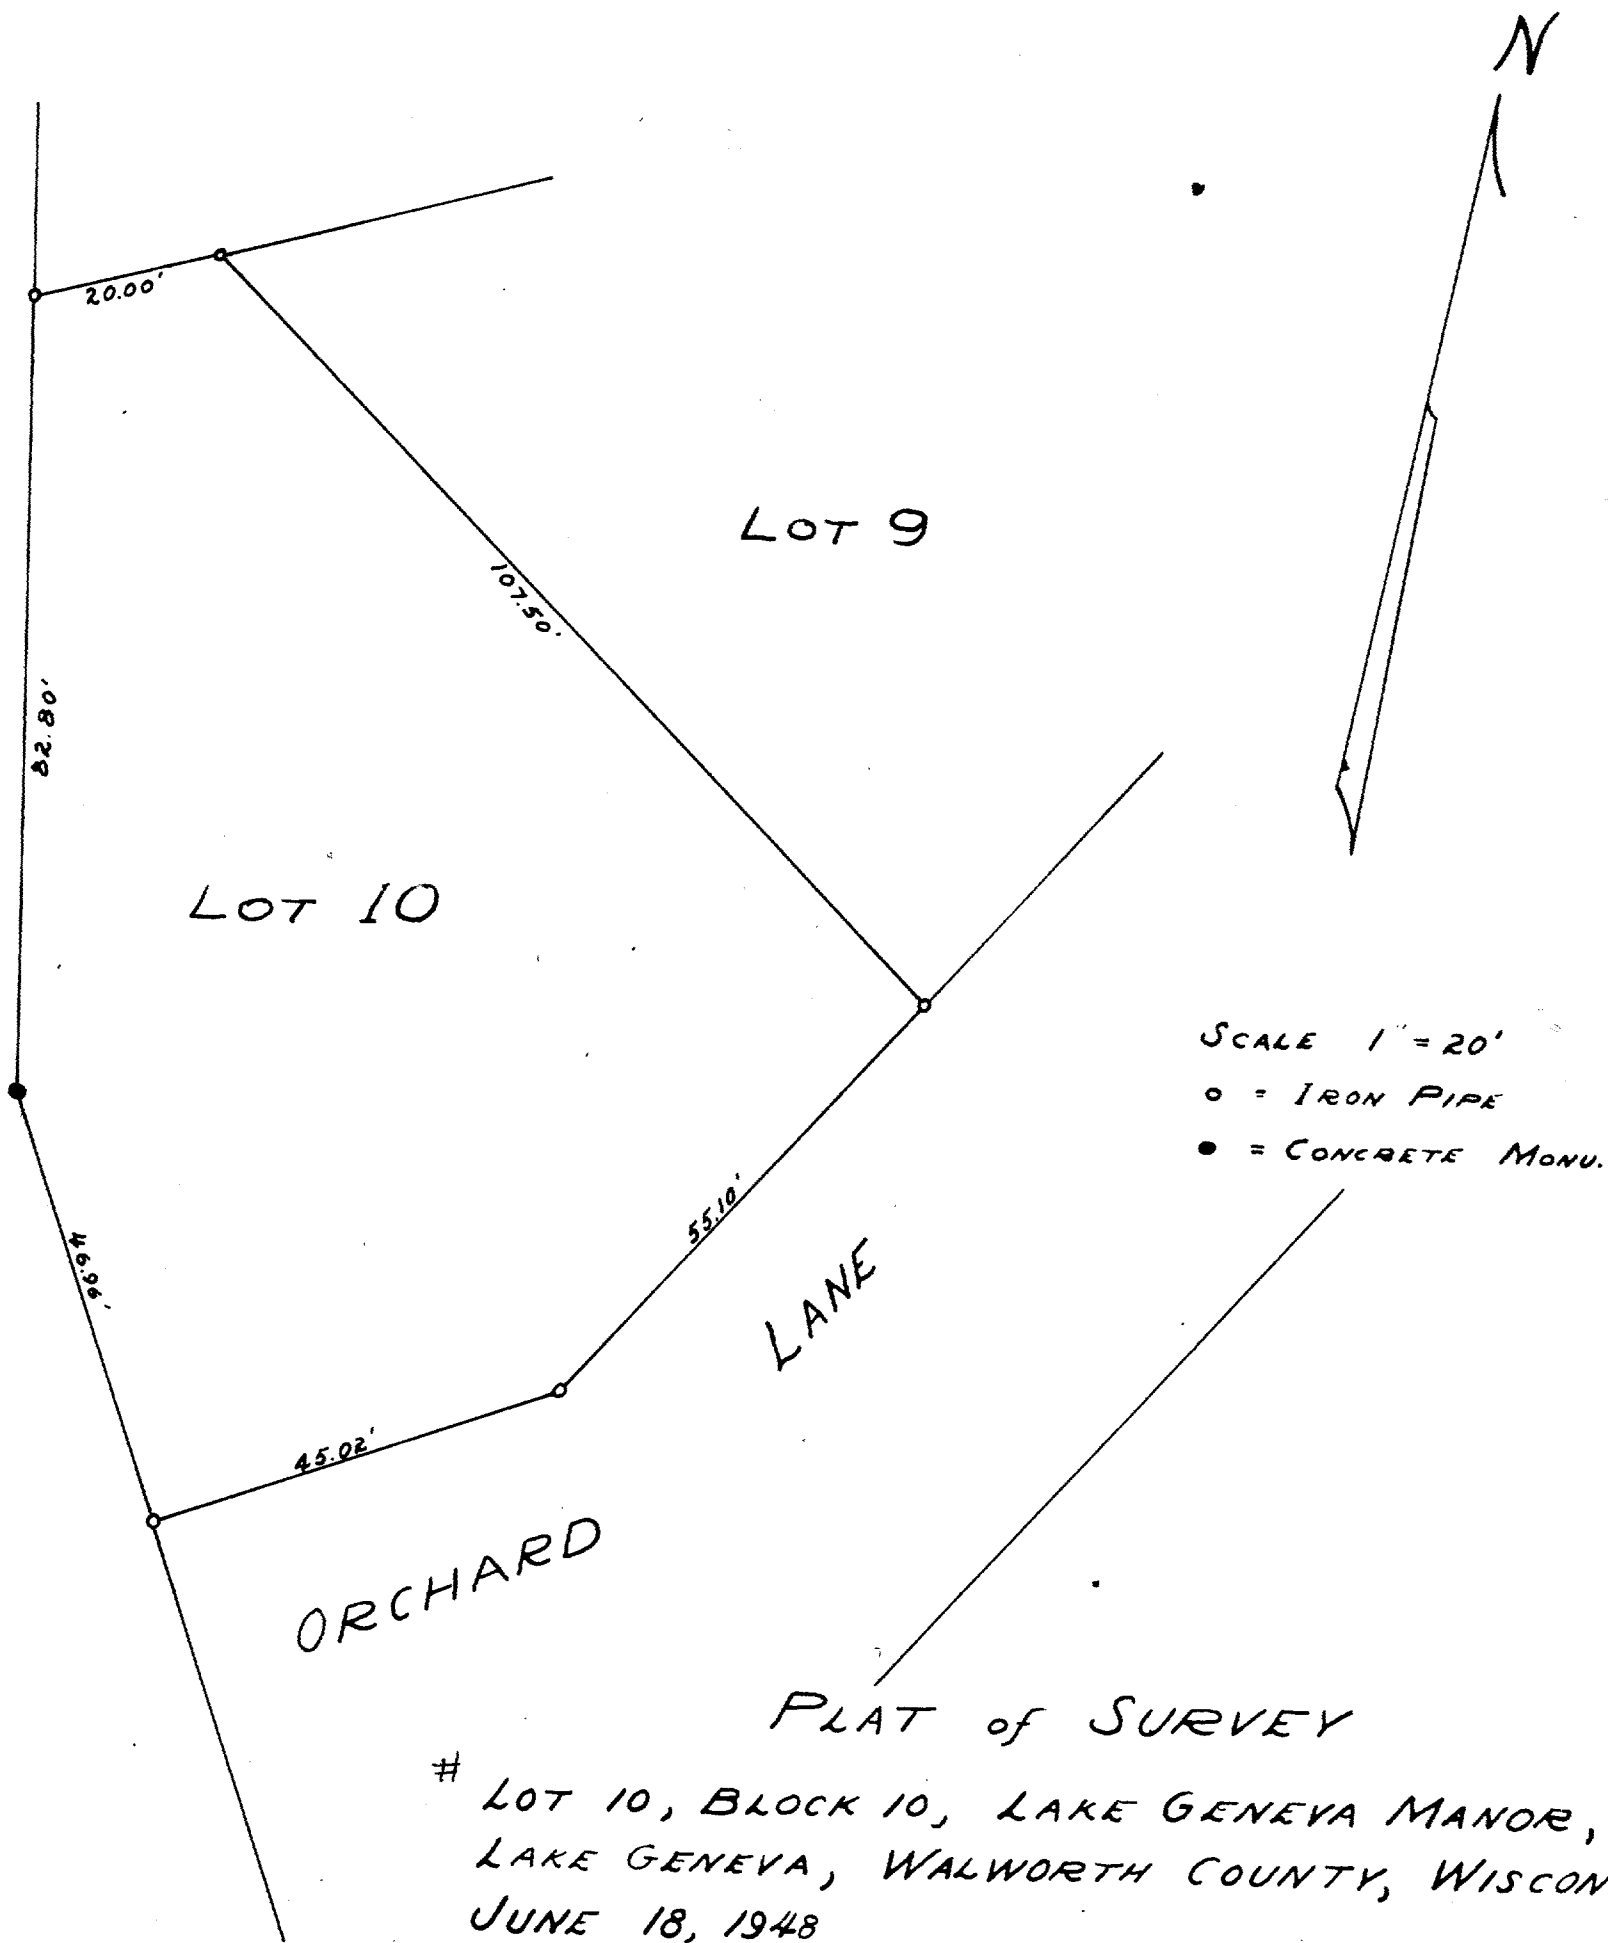

LOT 10, BLOCK 10, LAKE GENEVA MANOR,
LAKE GENEVA, WALWORTH COUNTY, WISCONSIN.
JUNE 18, 1948

Lloyd D. Jensen
COUNTY SURVEYOR