


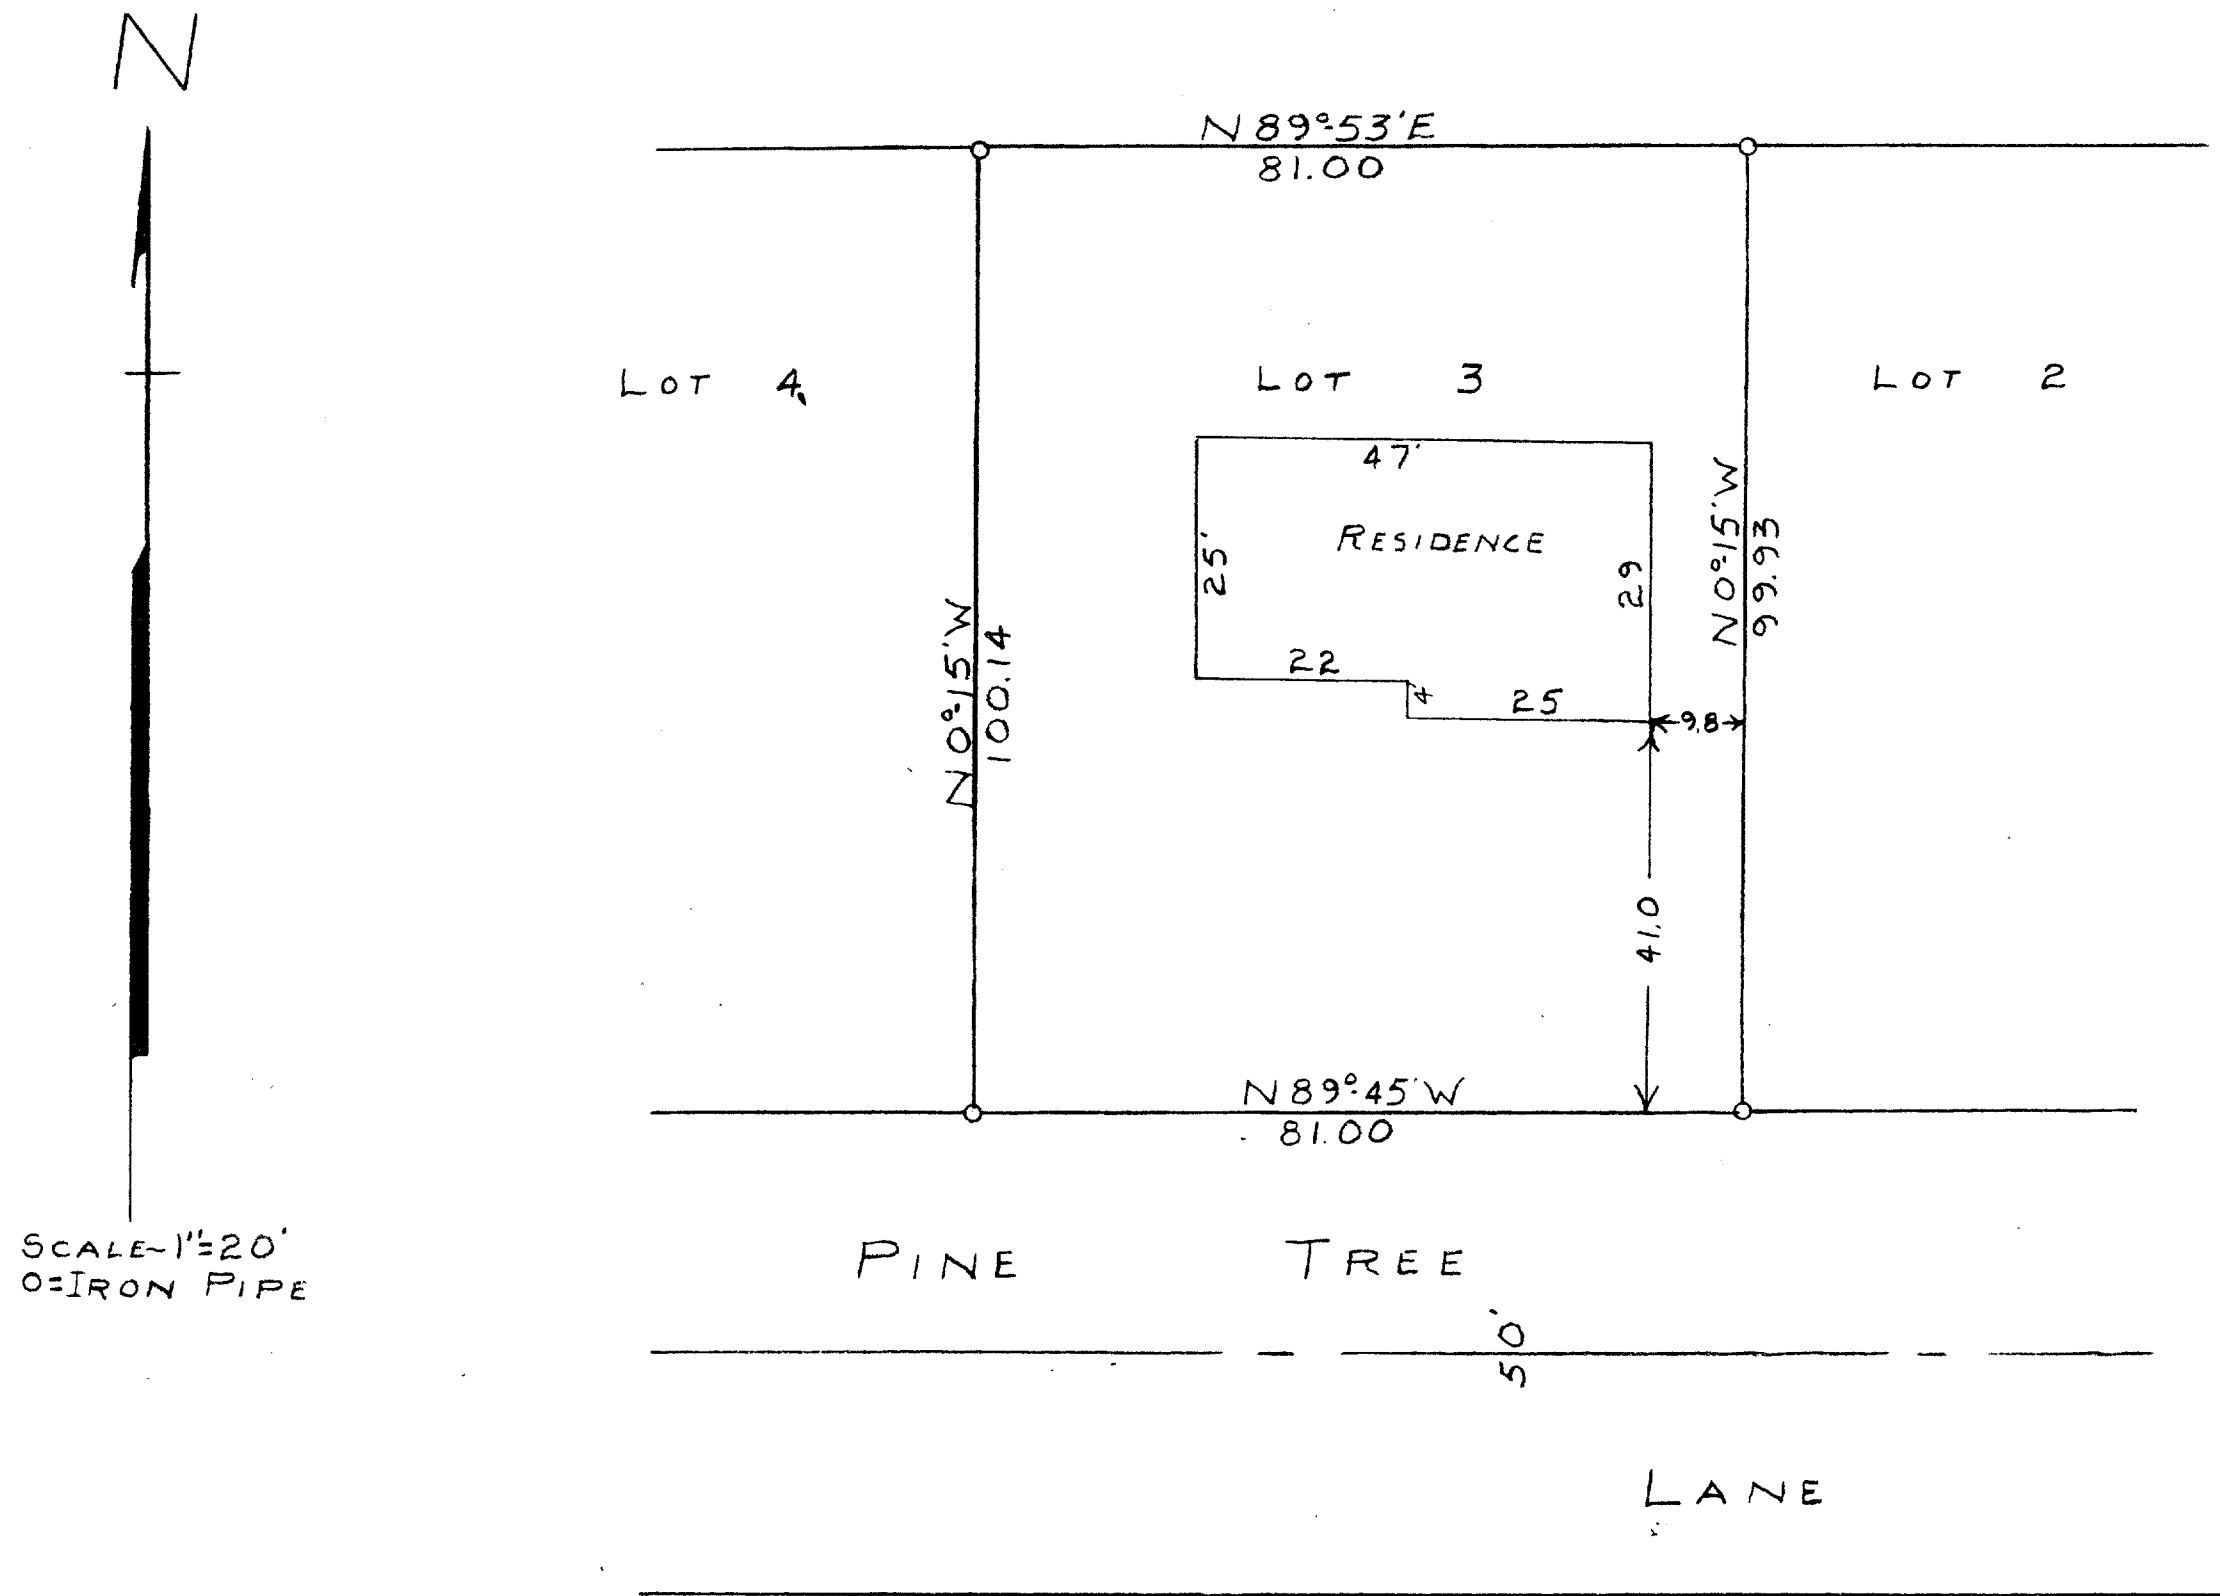

STATE OF WISCONSIN)
COUNTY OF WALWORTH)

I, GEORGE T. DUNHAM, DO HEREBY CERTIFY THAT I HAVE SURVEYED
THE PROPERTY DESCRIBED AS FOLLOWS:

LOT 3 OF SYVER-STAD LAKE SHORE ESTATES LOCATED IN THE
CITY OF LAKE GENEVA, WALWORTH COUNTY, WISCONSIN.

AND THAT THE PLAT SHOWN ABOVE IS A CORRECT REPRESENTATION OF
THE PROPERTY LINES.

DEC. 1955

George T. Dunham
GEORGE T. DUNHAM, SURVEYOR
DELAVER, WISCONSIN 7-11