
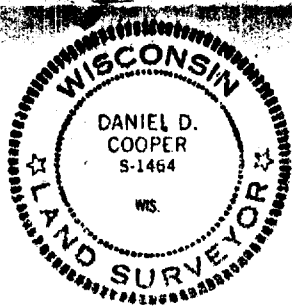


D. Cooper & CO., INC.
Rt 4 Box 508B • Elkhorn WI 53121

Plat of Survey of the East 43 feet of Lots
14, 15, & 18, Block 8 and the East 45 feet of
Lot 11 Block 8 and the East 45 feet of the South
10 feet of Lot 10 Block 8 and all being located
in Geneva Lake Crawford MFG. Co. Addition to the
City of Lake Geneva, Walworth County, Wisconsin.

Survey ordered by Wuttke Estate-Rt 2 Lake Geneva

Bearing Reference: Westerly line of Alley
assumed to bear North-South

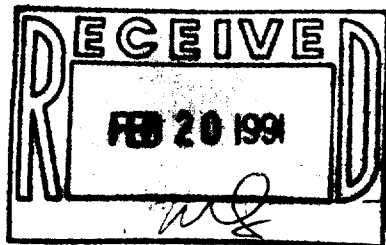

Scale 1"=20'


LEGEND

- indicates iron pipe found
- indicates 3/4" x 24" iron rod set
- x indicates cross cut in concrete
- ⊗ indicates 20 penny nail set in asphalt

I hereby certify that I have surveyed the
property described hereon and that the
map shown hereon is a true and accurate
representation thereof to the best of my
professional knowledge and belief.

Dated this 29th day of November, 1989

Daniel D. Cooper
Daniel D. Cooper, RLS No. S-1464

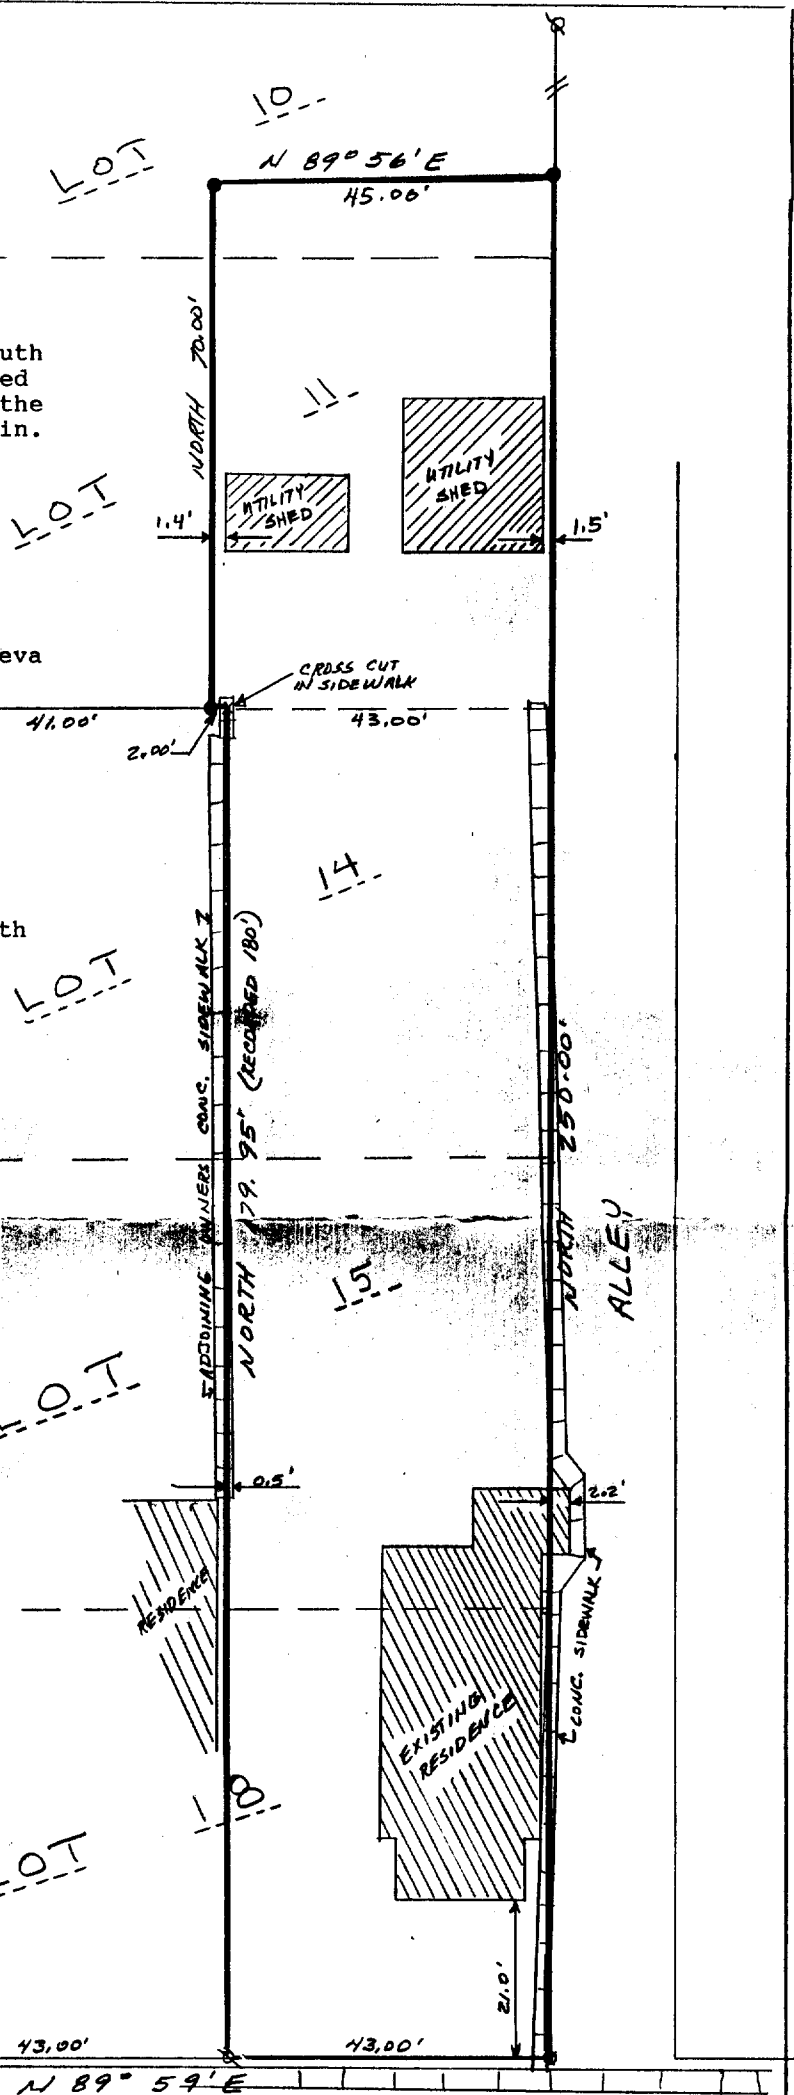

SPRING STREET

Drawing No. 3551-20-32

Redused

TAX KEY # ZGC 00033

7-1156