


PLAT OF SURVEY & HOUSE LOCATION
 LOTS 20, 21, & 22 BLOCK 21
 LAKE GENEVA MANOR CITY OF LAKE GENEVA
 WALWORTH COUNTY, WISCONSIN

N
 SCALE 1"=20'
 LEGEND
 O IRON PIPE FOUND
 X IRON PIPE FOUND & RESET
 • IRON PIPE SET

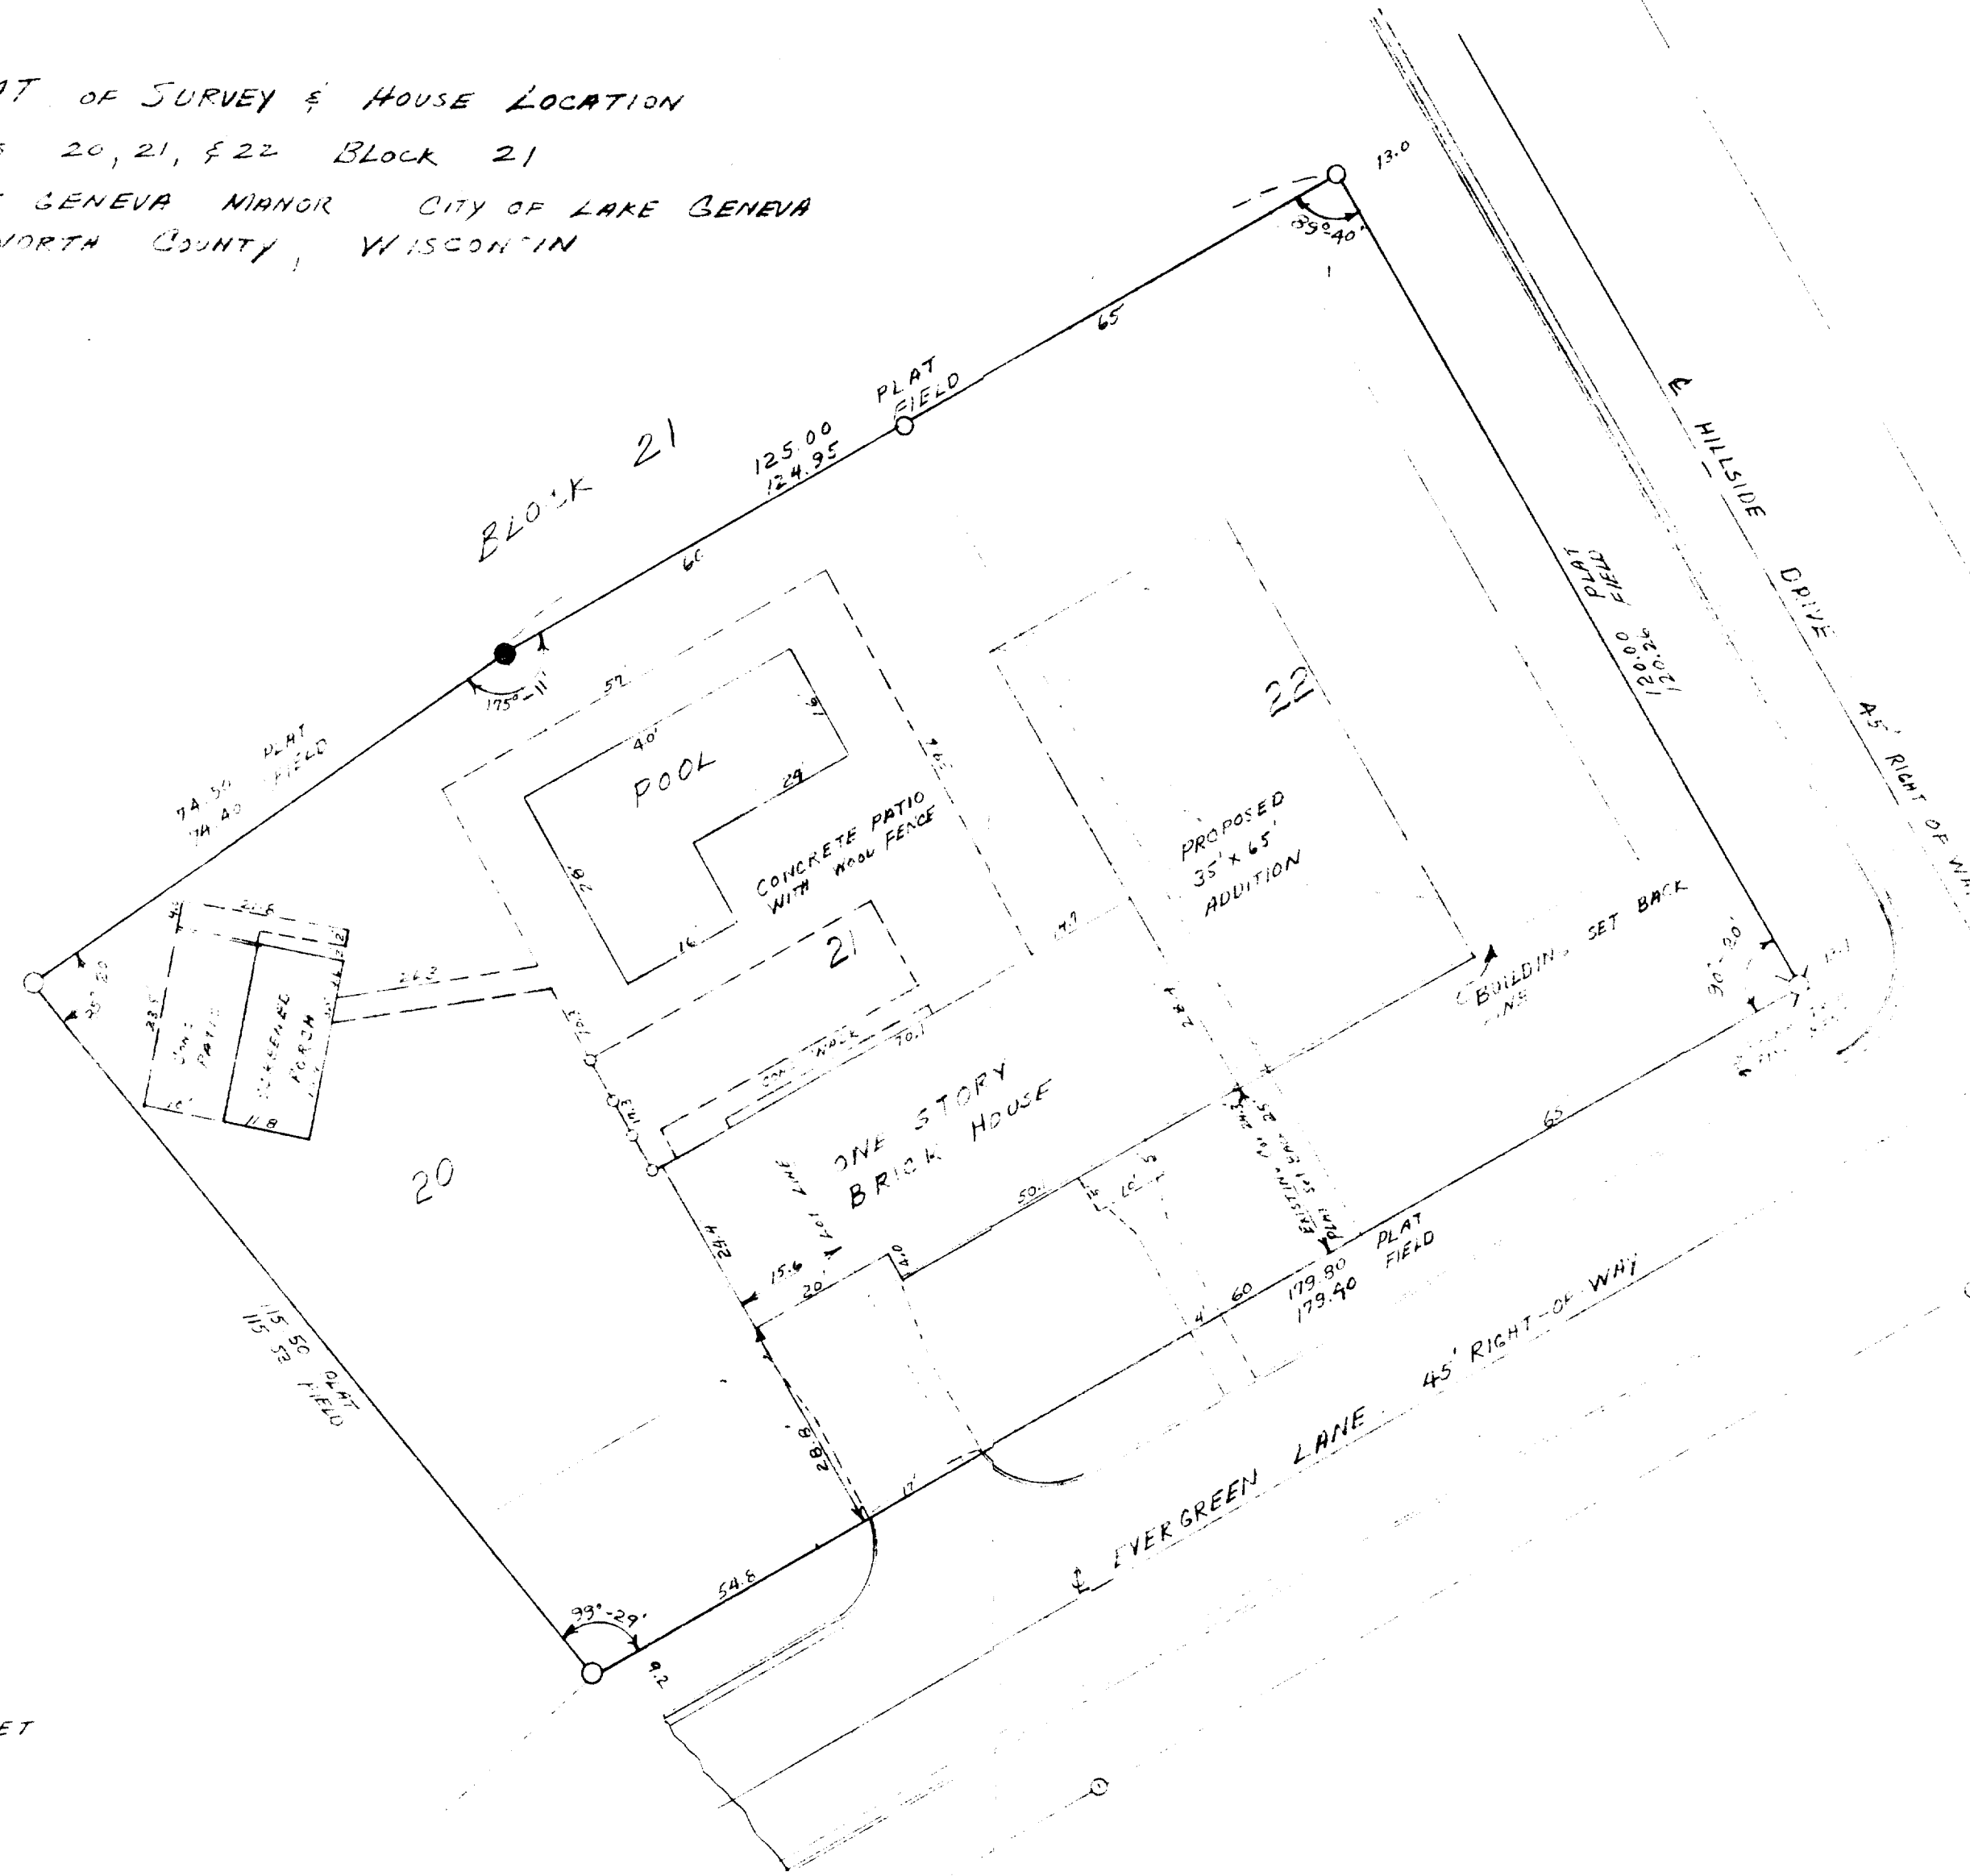

I, the undersigned, have surveyed the above described property and find the above plat is a true and correct representation thereof and of the exterior boundary lines and of the buildings and other improvements on the property and the exact measurements.

WISCONSIN
 State of Wisconsin
 County of Walworth
 City of Lake Geneva
 Notary Public
 S-821