
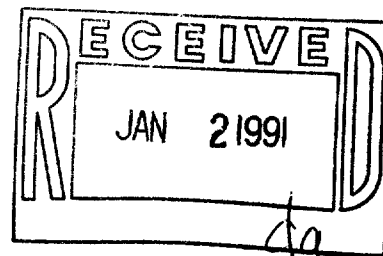



WALWORTH COUNTY
SURVEYING & MAPPING
LAKE GENEVA, WISCONSIN
414-248-0505

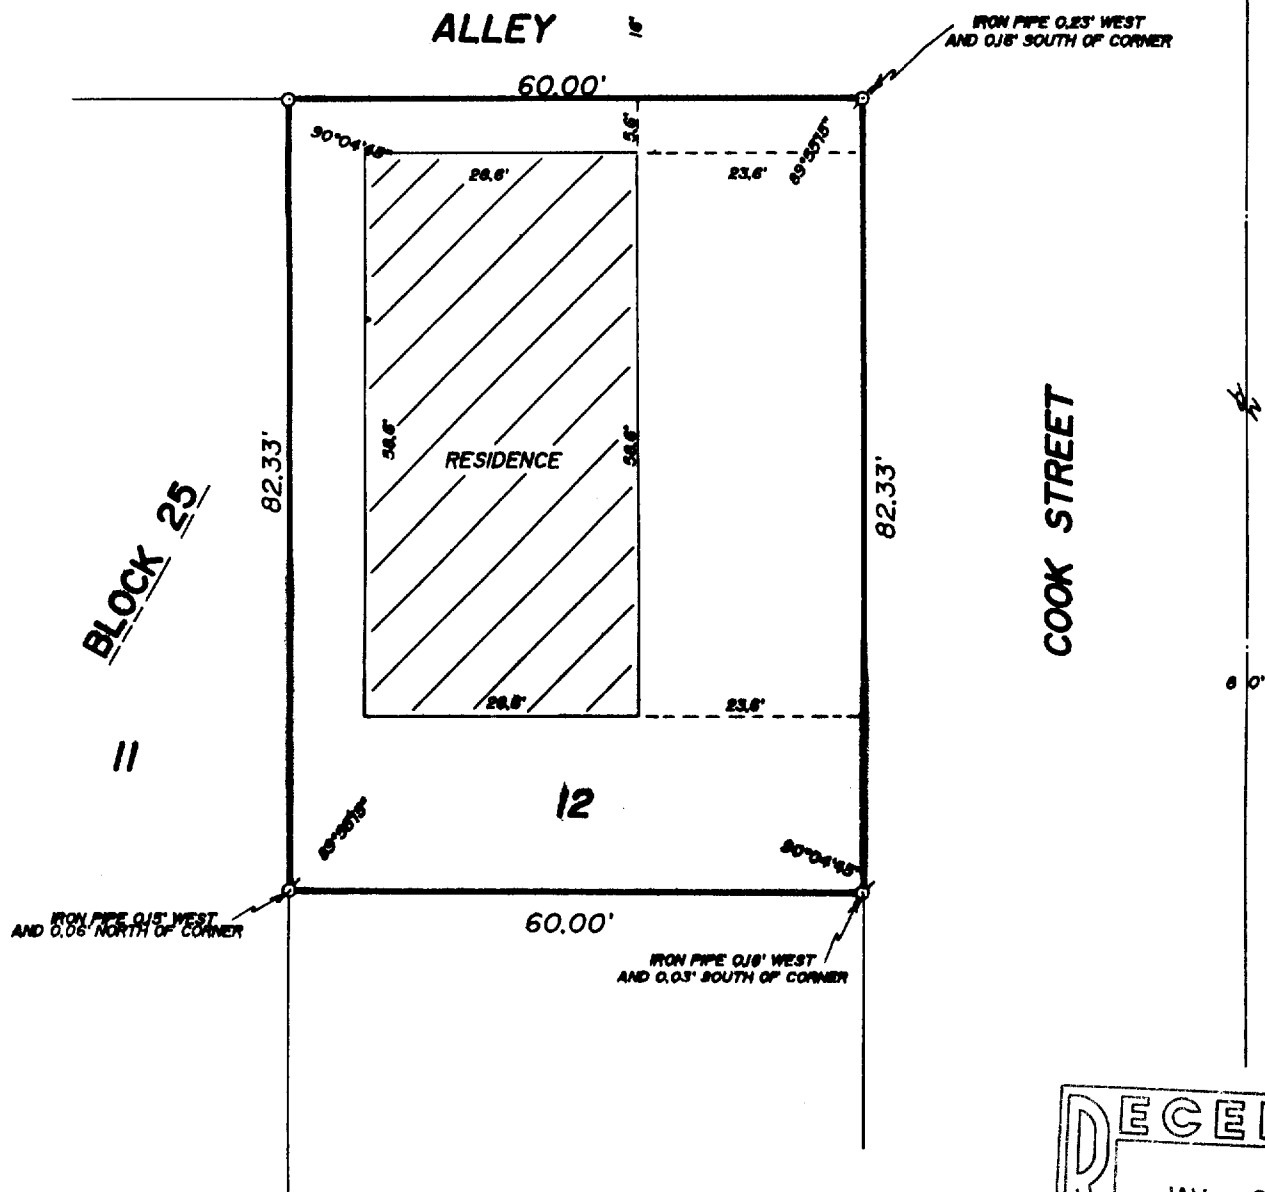

PLAT OF SURVEY OF

LOT 12, BLOCK 25, ORIGINAL PLAT OF THE CITY
OF LAKE GENEVA, WALWORTH COUNTY, WISCONSIN.
EXCEPT THE SOUTH 89.67 FEET THEREOF.

ORDERED BY: KEEFE REAL ESTATE
704 MAIN STREET
LAKE GENEVA, WISCONSIN
53147

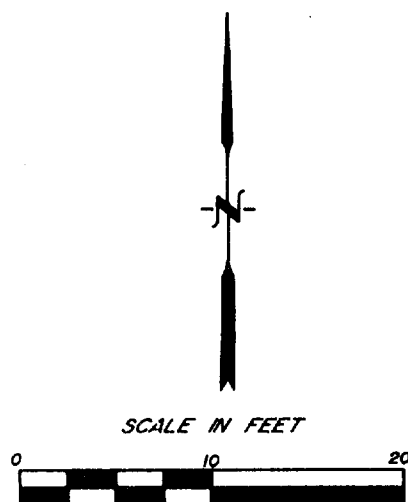

⊙ - IRON PIPE FOUND
○ - IRON PIPE PLACED

I HEREBY CERTIFY THAT I HAVE SURVEYED THE ABOVE DESCRIBED PROPERTY AND THAT
THE ABOVE MAP IS A TRUE REPRESENTATION THEREOF AND SHOWS THE SIZE AND
LOCATION OF THE PROPERTY, ITS EXTERIOR BOUNDARIES, THE LOCATION OF ALL VISIBLE
STRUCTURES AND DIMENSIONS OF ALL PRINCIPAL BUILDINGS THEREON, BOUNDARY FENCES,
APPARENT EASEMENTS AND ROADWAYS AND VISIBLE ENCROACHMENTS, IF ANY, TO THE
BEST OF MY KNOWLEDGE AND BELIEF.

THIS SURVEY IS MADE FOR THE USE OF THE PRESENT OWNERS OF THE PROPERTY AND
ALSO THOSE WHO PURCHASE, MORTGAGE OR GUARANTEE THE TITLE THEREIN WITHIN
ONE (1) YEAR FROM DATE HEREOF.

Robert M. Baumannwald
ROBERT M. BAUMANNWALD
WISCONSIN REGISTERED LAND SURVEYOR, S-1508

DATE *Oct. 17, 1989* JOB NO. 2210

NOTE: THIS IS NOT A CERTIFIED COPY UNLESS SEALED

Survey # 887-1171

TAX KEY # 30P 07/24/3