
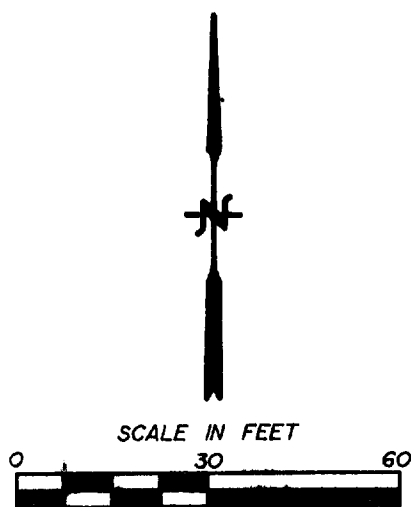
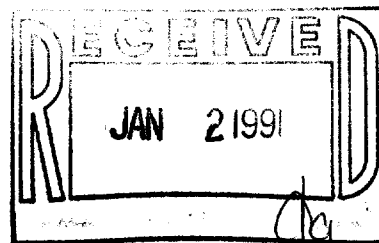


WALWORTH COUNTY  
SURVEYING & MAPPING  
LAKE GENEVA, WISCONSIN  
414-248-0505

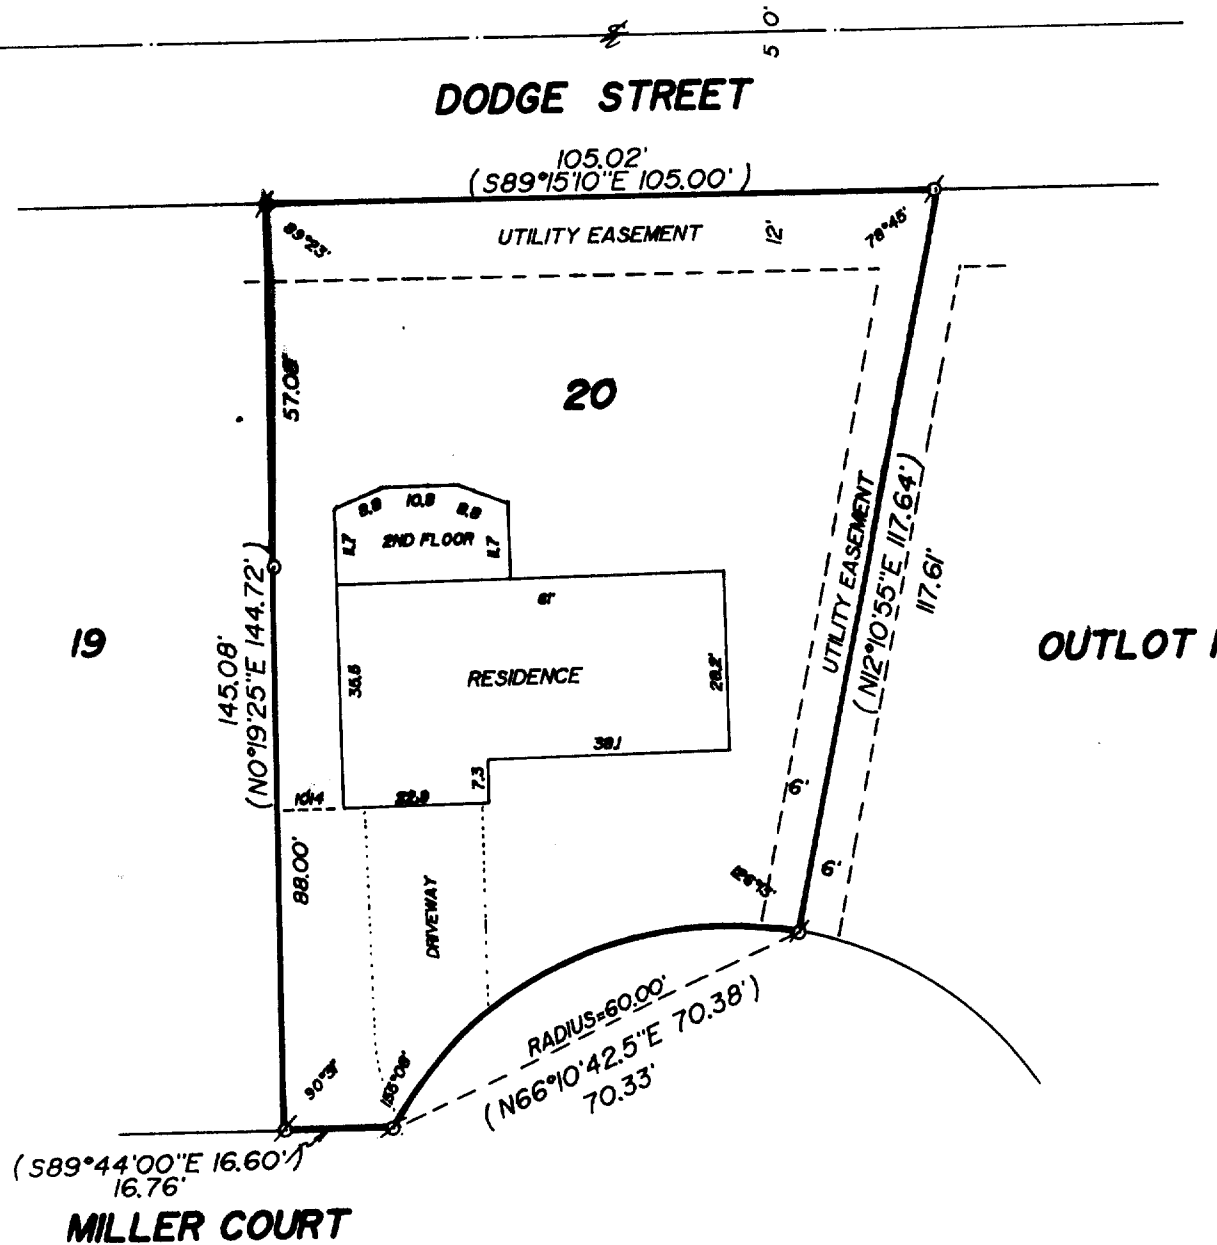

⊘ - IRON PIPE FOUND  
⊘ - IRON ROD FOUND  
( ) - RECORDED AS

PLAT OF SURVEY OF  
LOT 20 OF WESTGATE SUBDIVISION, LOCATED  
IN THE CITY OF LAKE GENEVA, WALWORTH  
COUNTY, WISCONSIN.

ORDERED BY: LAKESHORE REAL ESTATE  
101 BROAD STREET  
LAKE GENEVA, WISCONSIN  
53147

I HEREBY CERTIFY THAT I HAVE SURVEYED THE ABOVE DESCRIBED PROPERTY AND THAT  
THE ABOVE MAP IS A TRUE REPRESENTATION THEREOF AND SHOWS THE SIZE AND  
LOCATION OF THE PROPERTY, ITS EXTERIOR BOUNDARIES, THE LOCATION OF ALL VISIBLE  
STRUCTURES AND DIMENSIONS OF ALL PRINCIPAL BUILDINGS THEREON, BOUNDARY FENCES,  
APPARENT EASEMENTS AND ROADWAYS AND VISIBLE ENCROACHMENTS, IF ANY, TO THE  
BEST OF MY KNOWLEDGE AND BELIEF.

THIS SURVEY IS MADE FOR THE USE OF THE PRESENT OWNERS OF THE PROPERTY AND  
ALSO THERE UND PURCHASE, MORTGAGE OR GUARANTEE THE TITLE THERE TO WITHIN  
ONE (1) YEAR FROM DATE HEREOF.

*Robert M. Bevernwald*  
ROBERT M. BEVERNWALD  
WISCONSIN REGISTERED LAND SURVEYOR, S-1508

DATE *Oct. 6, 1989*  
JOB NO. 2162

NOTE: THIS IS NOT A CERTIFIED COPY UNLESS BEALED

Survey# 007-1172

TAX KEY# ZWC 11/1/89