


56-74

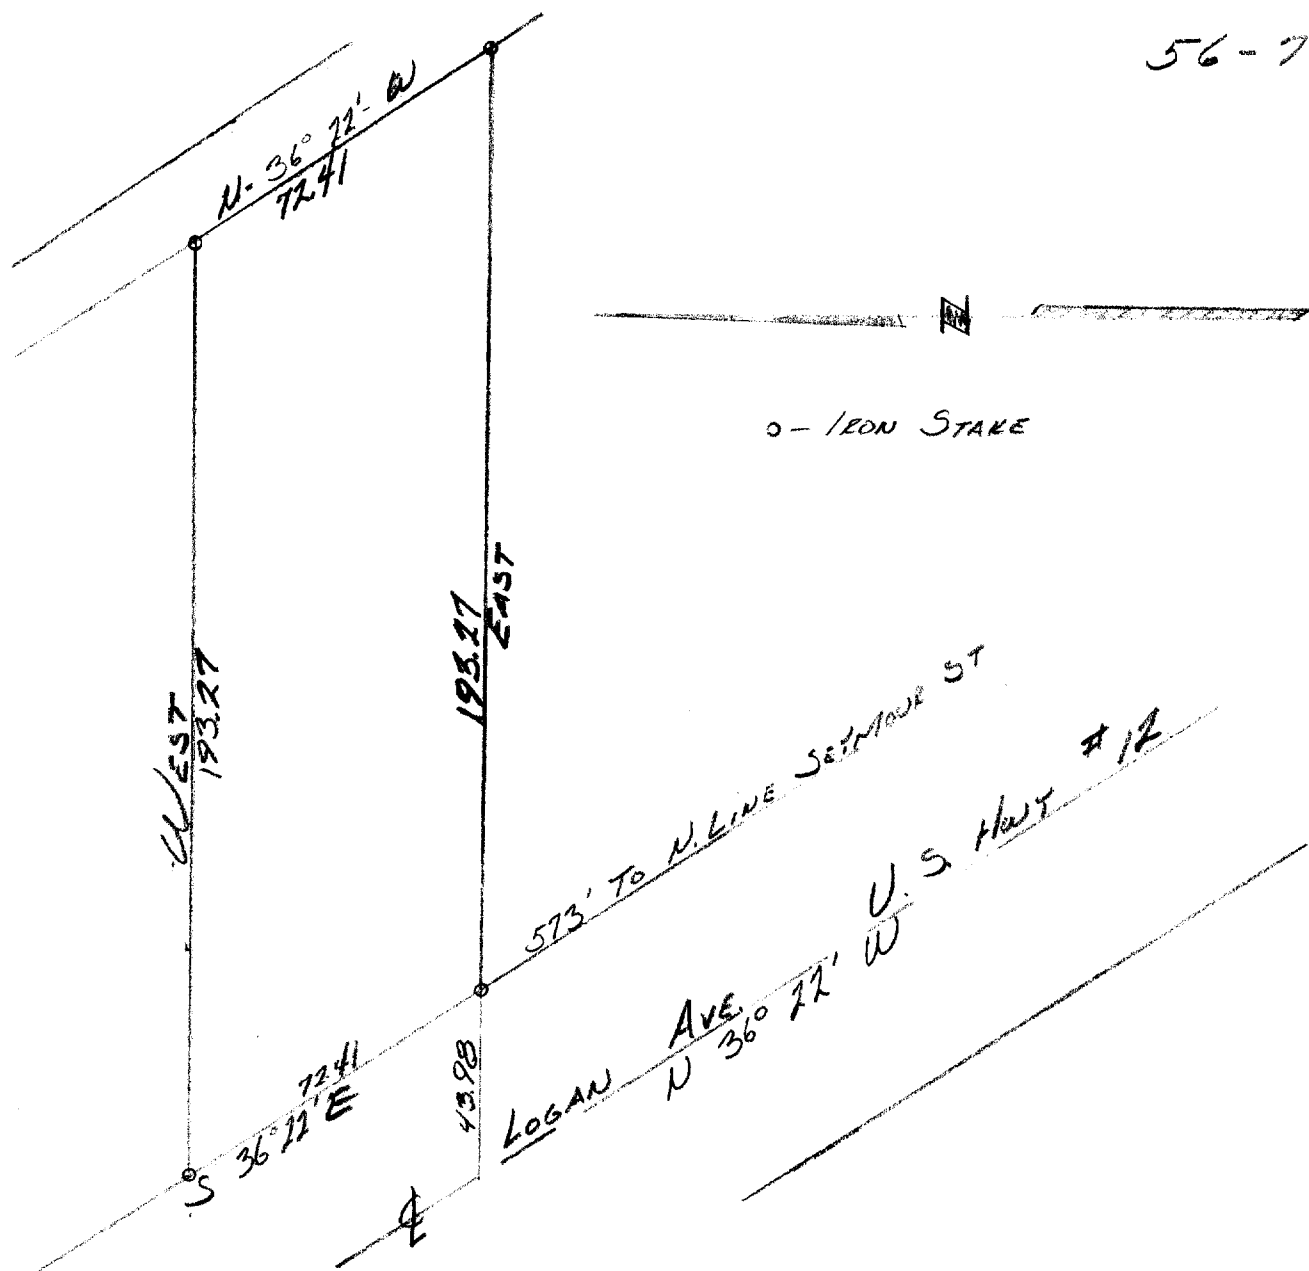

DESCRIPTION: Commencing at an iron stake that is in the East line of Logan Street and 573.0 feet N. 36° 22' W. of the intersection of the East line of Logan Street and the North line of Seymour Street, thence East parallel with the South line of Section 36, T.2, N., R.17, E., 193.27 feet to an iron stake, thence N. 36° 22' W. 72.41 feet to an iron stake, thence West parallel with the South line of said section 193.27 feet to an iron stake in the East line of Logan Street, thence S. 36° 22' E. 72.41 feet along the East line of Logan Street to the Place of Beginning

CERTIFICATE: I hereby certify that I have on this the 23rd day of February, 1956 surveyed the above described property and that the above drawing is an accurate portrayal of the survey.

SIGNED AND SEALED ON THIS THE 24TH DAY OF FEBRUARY 1956

Joseph M. Biagi
Joseph M. Biagi
Reg. Land Surveyor
Elkhorn, Wisconsin.

7-117B.2