


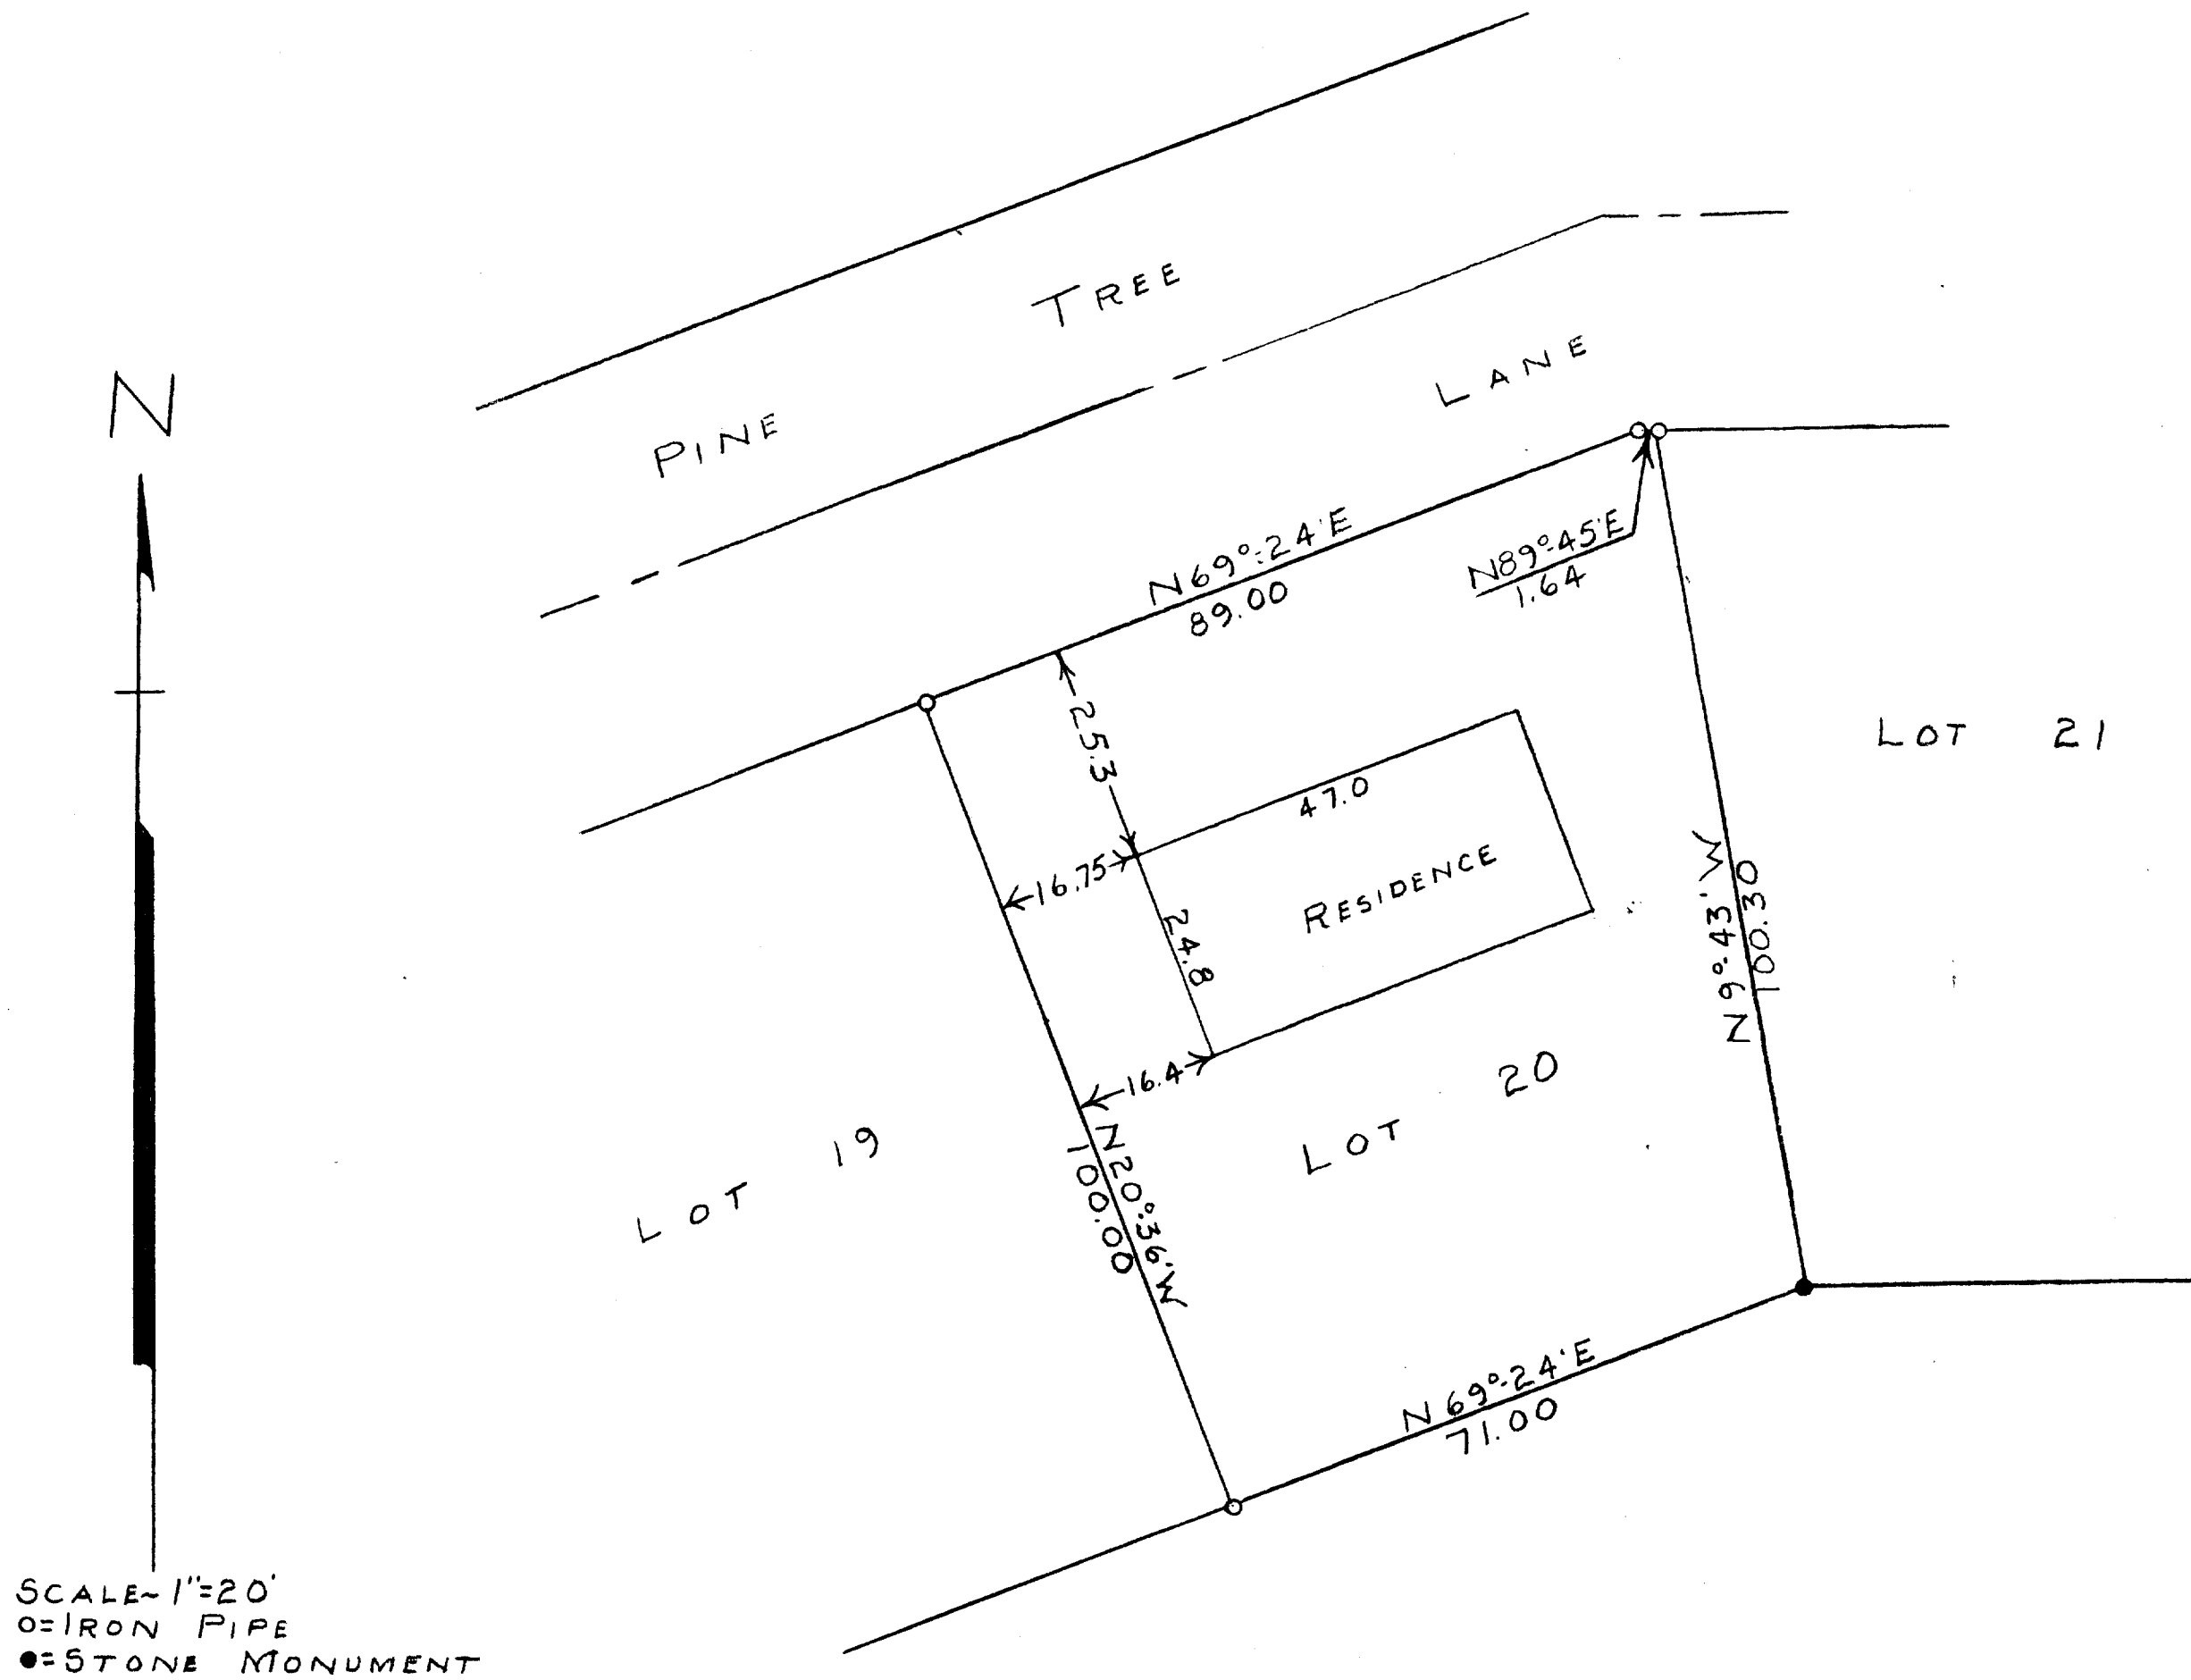

STATE OF WISCONSIN)
 COUNTY OF WALWORTH)

I, GEORGE T. DUNHAM, DO HEREBY CERTIFY THAT I HAVE SURVEYED
 THE PROPERTY DESCRIBED AS FOLLOWS:

LOT 20 OF SYVERSTAD LAKE SHORE ESTATES LOCATED IN THE CITY
 OF LAKE GENEVA, WALWORTH COUNTY, WISCONSIN.

AND THAT THE PLAT SHOWN ABOVE IS A CORRECT REPRESENTATION OF
 THE PROPERTY LINES.

DEC. 1955

George T. Dunham
 GEORGE T. DUNHAM, SURVEYOR
 DELAVAN, WISCONSIN 7-12