


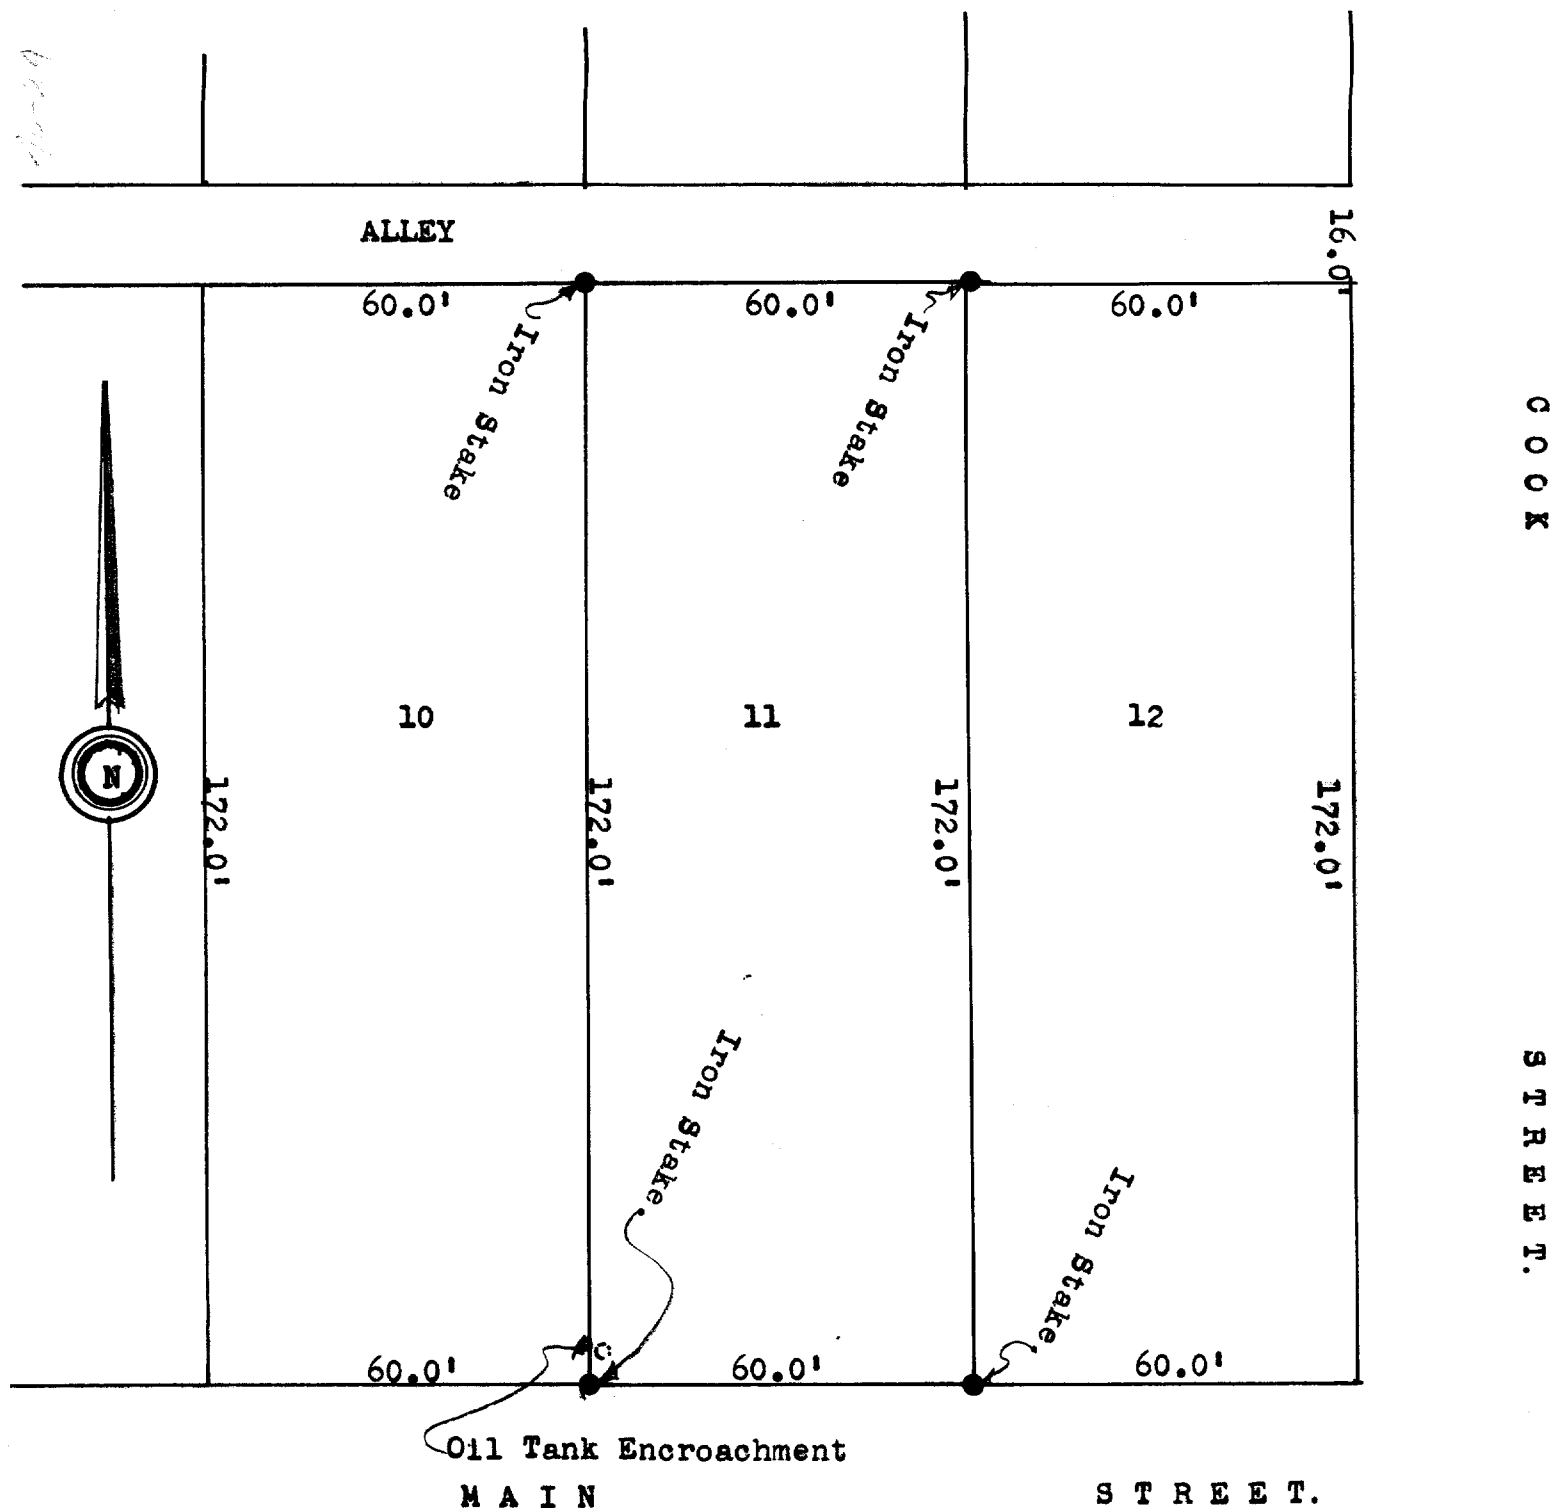

DESCRIPTION: Lot 11, Block 25 Original Plat of the Village (now city) of Lake Geneva, Walworth County, Wisconsin.

CERTIFICATE: I, hereby certify that I have on this the 21st day of September 1946, surveyed the above described property according to the official records on file in the office of the Recorder of Deeds in and for Walworth County, Wisconsin, and find that an encroachment exists as shown upon the plat, SIGNED AND SEALED THIS 23RD DAY OF SEPTEMBER 1946.

Joseph M. Biagi
Joseph M. Biagi, Professional Eng.
Elkhorn Wisconsin.